
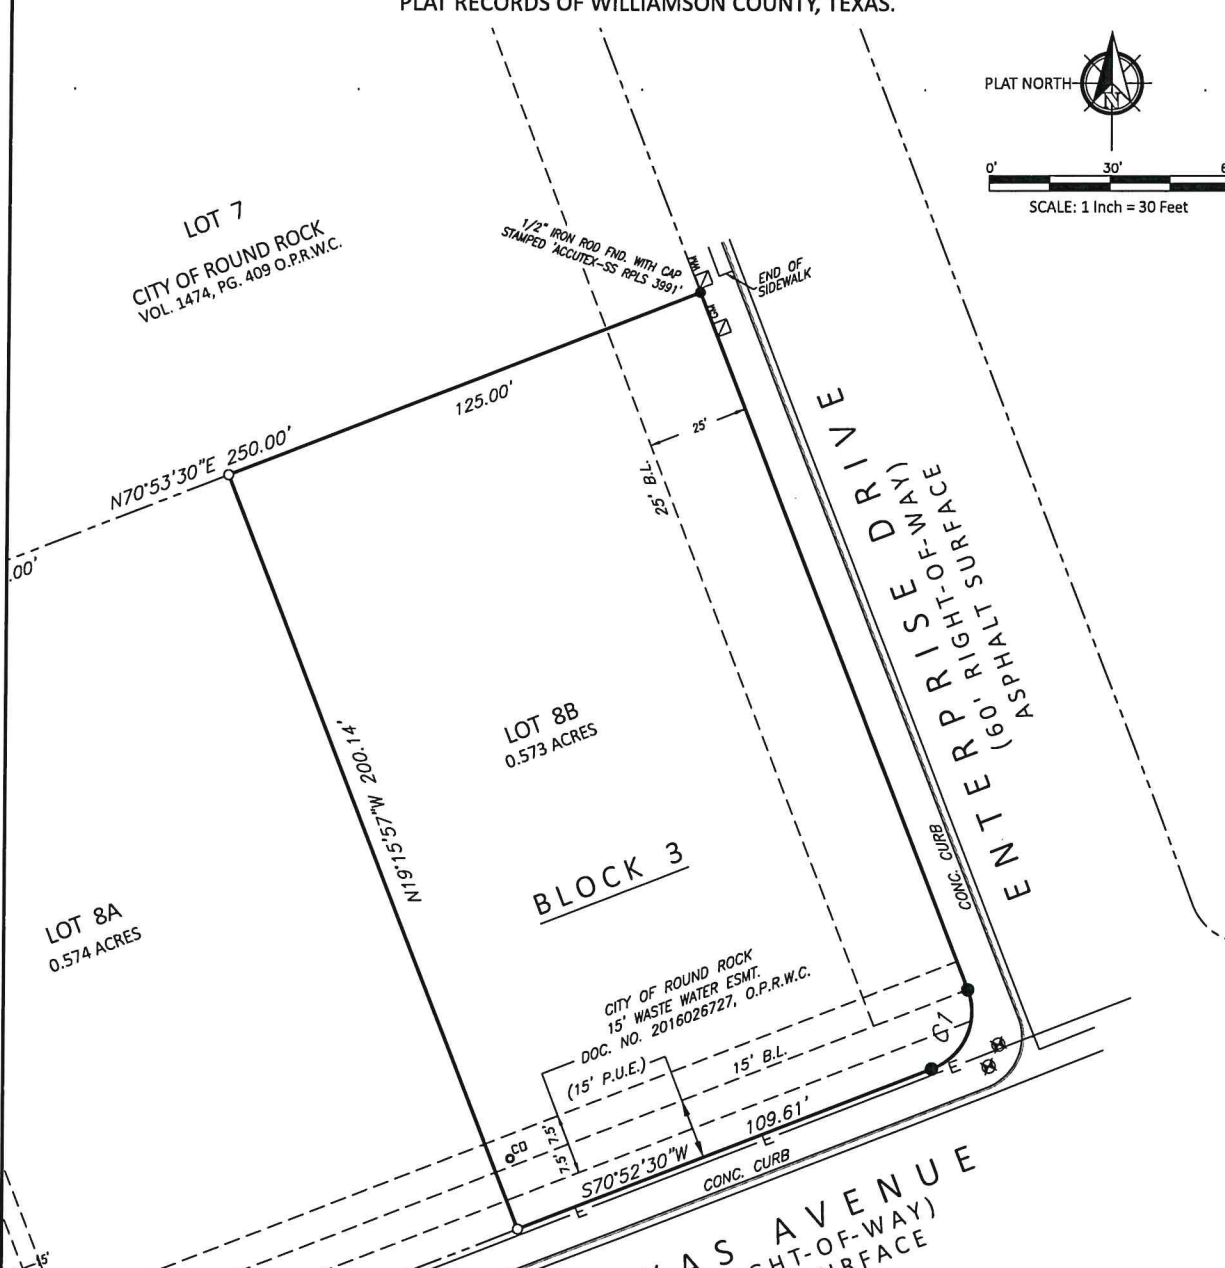


# AS-BUILT SURVEY OF LOT 8B, BLOCK 3, ROUND ROCK NORTH INDUSTRIAL BUSINESS PARK SECTION II,

ACCORDING TO THE MAP OR PLAT THEREOF, RECORDED IN DOCUMENT NO. 2017103297, OF THE  
PLAT RECORDS OF WILLIAMSON COUNTY, TEXAS.

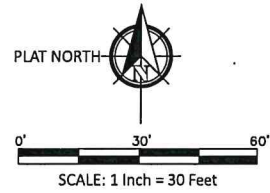

**SURVEYOR'S CERTIFICATION:**  
I, FRED L. DODD JR., A REGISTERED PROFESSIONAL LAND SURVEYOR, DO HEREBY CERTIFY THAT THE SKETCH SHOWN HEREON WAS DETERMINED FROM A SURVEY MADE ON THE GROUND UNDER MY DIRECTION AND SUPERVISION, AND THAT ALL CORNERS ARE MARKED AS SHOWN.

*Fred L. Dodd Jr.*  
FRED L. DODD, JR. RPLS (NO. 6392)  
DATE: 09/29/2018 JOB NO. WC14306-1B



- LEGEND**
- 1/2" IRON ROD FOUND
  - 1/2" IRON ROD SET
  - CM CONTROL MONUMENT
  - ☒ AIR CONDITIONING CONDENSER UNIT
  - BOLLARD
  - CLEAN OUT
  - ⌋ DOWN GUY
  - CHAIN LINK FENCE
  - ⊕ FIRE HYDRANT
  - ☒ MAILBOX
  - OVERHEAD ELECTRIC/TELEPHONE LINE
  - ⊕ SANITARY SEWER MANHOLE
  - ⊕ STORM SEWER MANHOLE
  - ⊕ UTILITY POLE
  - ⊕ WATER METER
  - ⊕ WATER VALVE
  - ( ) RECORD INFORMATION

**FRED L. DODD JR.**  
**SURVEYOR, INC.**  
PROFESSIONAL LAND SURVEYING

ORDER A SURVEY EMAIL US AT:  
INFO@DODDSURVEYING.COM  
OFFICE (512) 953-5705

[WWW.DODDSURVEYING.COM](http://WWW.DODDSURVEYING.COM)

8019 W. GRAND PKWY.  
SUITE 1060 #464  
RICHMOND, TX 77407