

**T-47 RESIDENTIAL REAL PROPERTY AFFIDAVIT
(MAY BE MODIFIED AS APPROPRIATE FOR COMMERCIAL TRANSACTIONS)**

Date: 6/7/2019

GF No. _____

Name of Affiant(s): Blake Taylor

Address of Affiant: 20822 Rose Crossing Lane, Spring, TX 77379

Description of Property: Lot 10 Blk 2 Windrose West Sec 15 AMEND
County Harris, Texas

"Title Company" as used herein is the Title Insurance Company whose policy of title insurance is issued in reliance upon the statements contained herein.

Before me, the undersigned notary for the State of Texas, personally appeared Affiant(s) who after by me being sworn, stated:

1. We are the owners of the Property. (Or state other basis for knowledge by Affiant(s) of the Property, such as lease, management, neighbor, etc. For example, "Affiant is the manager of the Property for the record title owners.")

2. We are familiar with the property and the improvements located on the Property.

3. We are closing a transaction requiring title insurance and the proposed insured owner or lender has requested area and boundary coverage in the title insurance policy(ies) to be issued in this transaction. We understand that the Title Company may make exceptions to the coverage of the title insurance as Title Company may deem appropriate. We understand that the owner of the property, if the current transaction is a sale, may request a similar amendment to the area and boundary coverage in the Owner's Policy of Title Insurance upon payment of the promulgated premium.


4. To the best of our actual knowledge and belief, since 7/25/2012 there have been no:
a. construction projects such as new structures, additional buildings, rooms, garages, swimming pools or other permanent improvements or fixtures;
b. changes in the location of boundary fences or boundary walls;
c. construction projects on immediately adjoining property(ies) which encroach on the Property;
d. conveyances, replattings, easement grants and/or easement dedications (such as a utility line) by any party affecting the Property.

EXCEPT for the following (If None, Insert "None" Below): NONE


5. We understand that Title Company is relying on the truthfulness of the statements made in this affidavit to provide the area and boundary coverage and upon the evidence of the existing real property survey of the Property. This Affidavit is not made for the benefit of any other parties and this Affidavit does not constitute a warranty or guarantee of the location of improvements.

6. We understand that we have no liability to Title Company that will issue the policy(ies) should the information in this Affidavit be incorrect other than information that we personally know to be incorrect and which we do not disclose to the Title Company.

[Signature]

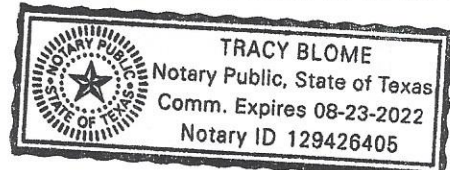

SWORN AND SUBSCRIBED this 7th day of June, 2019
Tracy Blome
Notary Public

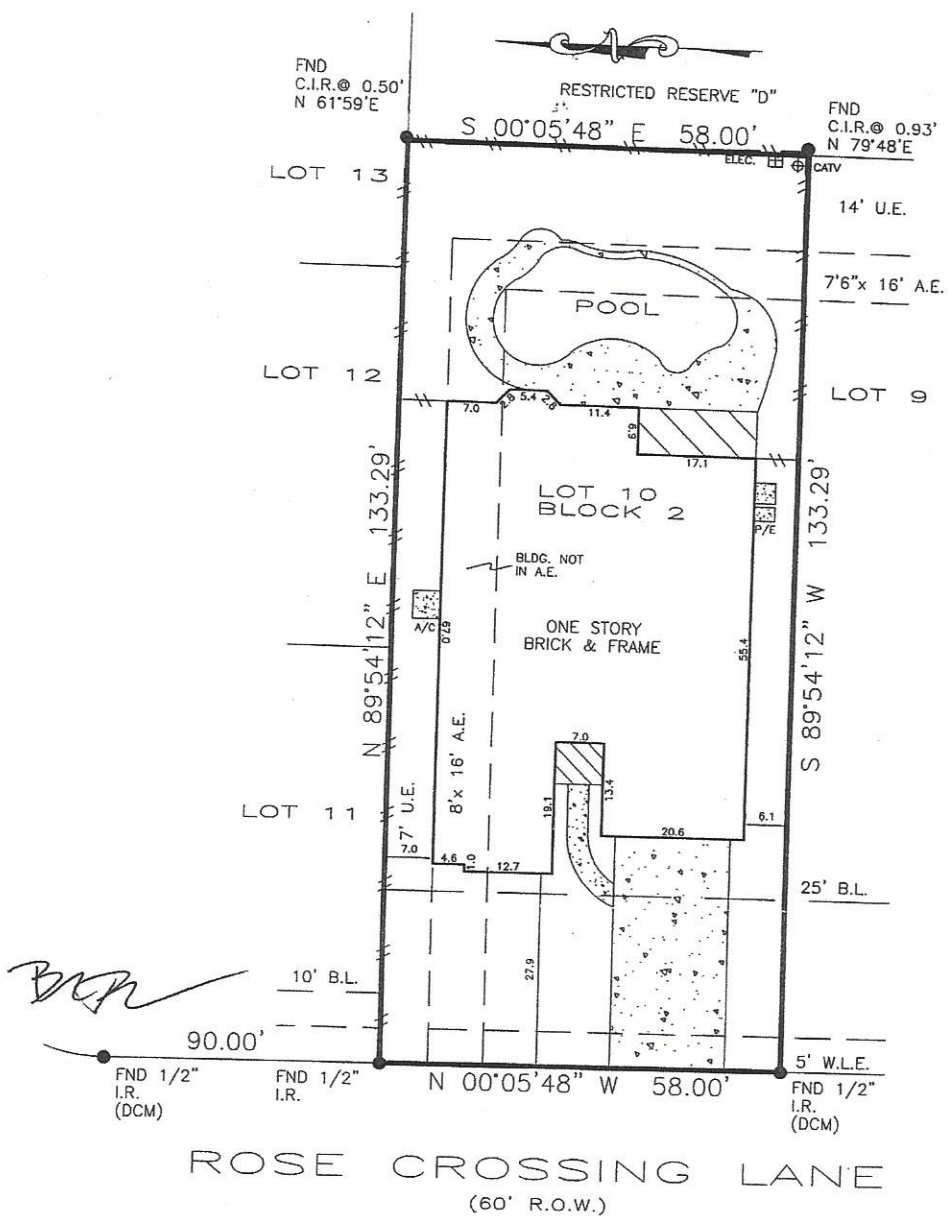

Agreement for electric service (Y251907)
 DCM=Directional Control Monument
 Bearings based on subdivision plat.
 Easements and Building Lines (B.L.) as provided by Title Company.

FLOOD PLAIN INFORMATION:
 ZONE: "X"
 PANEL: 48201C-0235L
 DATE: 6-18-07
 G.F. NO.: 1424197-GT74
 JOB NO.: 10005501
 SCALE: 1" = 20'

Purchaser JASON S. STOGDILL
 Address 20822 ROSE CROSSING LANE SPRING, TEXAS 77379
 Lot 10 Block 2 Sec. 15
 Survey _____
 Area _____
 Subd WINDROSE WEST
 F.C. No. 570236 M.R. HARRIS COUNTY, TEXAS

To GREAT AMERICAN TITLE COMPANY

The undersigned does hereby certify that this survey was this day made, on the ground of the property, legally described hereon and correct; and that there are no discrepancies, conflicts, shortages in area, boundary line conflicts, visible encroachments, overlapping of improvements, easements or apparent rights-of-way, except as shown hereon, and said property has access to and from dedicated roadway, except as shown hereon.
 This document is copyright protected with a production date as delineated below.
 This survey is valid only with impression seal signed in red ink.

Dated this 25th day of JANUARY 2010 ROBERT A. LAPLANT JR.
 RPLS 5234

LaPLANT SURVEYORS, INC.
 1503 BIG HORN DRIVE HOUSTON, TEXAS 77090
 (281) 440-8890 FAX 281-440-8510

Jason Scott Stogdill
 1/11/10

