


NOTE: MAP OR PLAT RECORDED IN FILM CODE NO. 3-45042, HARRIS COUNTY MAP RECORDS.
 THIS TRACT ~~SHOULD~~ ^{WAS} LIE WITHIN THE 100 YEAR FLOOD PLAIN ACCORDING TO
 MAP NO. ~~REC 222. C. 270 6~~ DATED 9-28-90 (ZONE X).

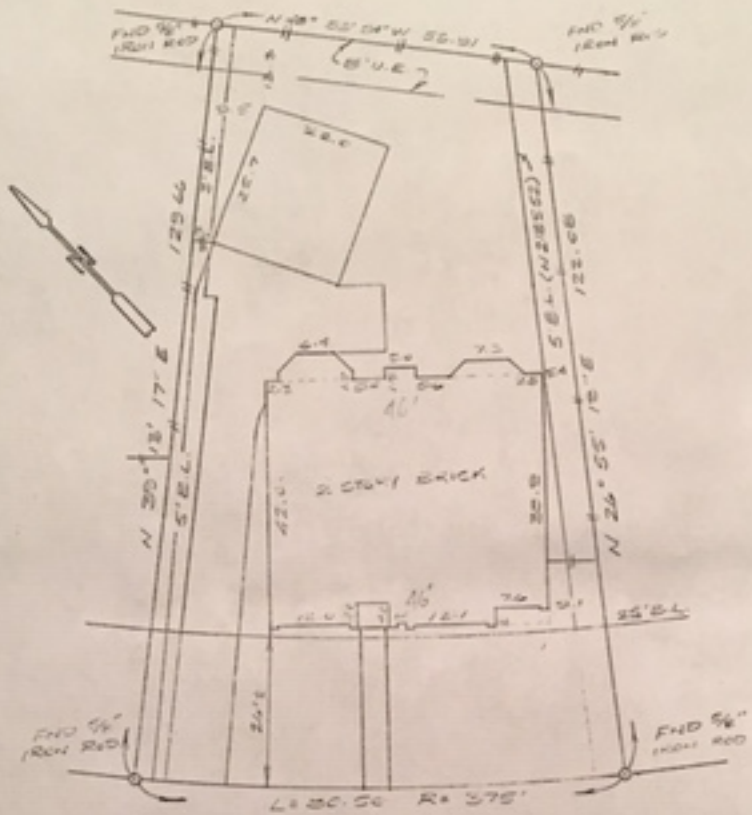

13815 BROOKLET VIEW COURT

LOT SUBJECT TO AUDIO-VIDEO EASEMENT AS RECORDED IN COUNTY CLERK'S FILE# N218952.
 LOT SUBJECT TO H.L.&P. AGREEMENT AS RECORDED IN COUNTY CLERK'S FILE# N269003.

SURVEY

OF LOT 13, BLOCK 11, NORTHFORK, SECTION 1,
 HARRIS COUNTY, TEXAS

SCALE: 1"=20'
 DATE: 7-24-92
 REVISED:
 SURVEY BY: T.S.
 DRAWN BY: D.K.Z.

THIS PLAT REPRESENTS A TRUE AND ACCURATE SURVEY MADE ON THE GROUND UNDER MY SUPERVISION. THERE ARE NO ENCROACHMENTS NOR CONFLICTS ACROSS PROPERTY LINES AT TIME OF THIS SURVEY, EXCEPT AS SHOWN HEREON.

Billy L. Shanks

BILLY L. SHANKS
 REGISTRATION NO. 1821



FOR: STEWART TITLE
 GP# 91121240
 TRANSCOASTAL MORT.
 PURCHASER: LEROY S. JACKSON,
 JR. & CYNTHIA JACKSON
 JOB NO. 92-30465

SHANKS LAND SURVEYORS OF TEXAS, Inc.
 118 SOUTH WALNUT
 WEBSTER, TEXAS 77598 338-2211 FAX 332-0061