


ISSUE:	DATE:	NO:
AS-BUILT	07.12.18	1

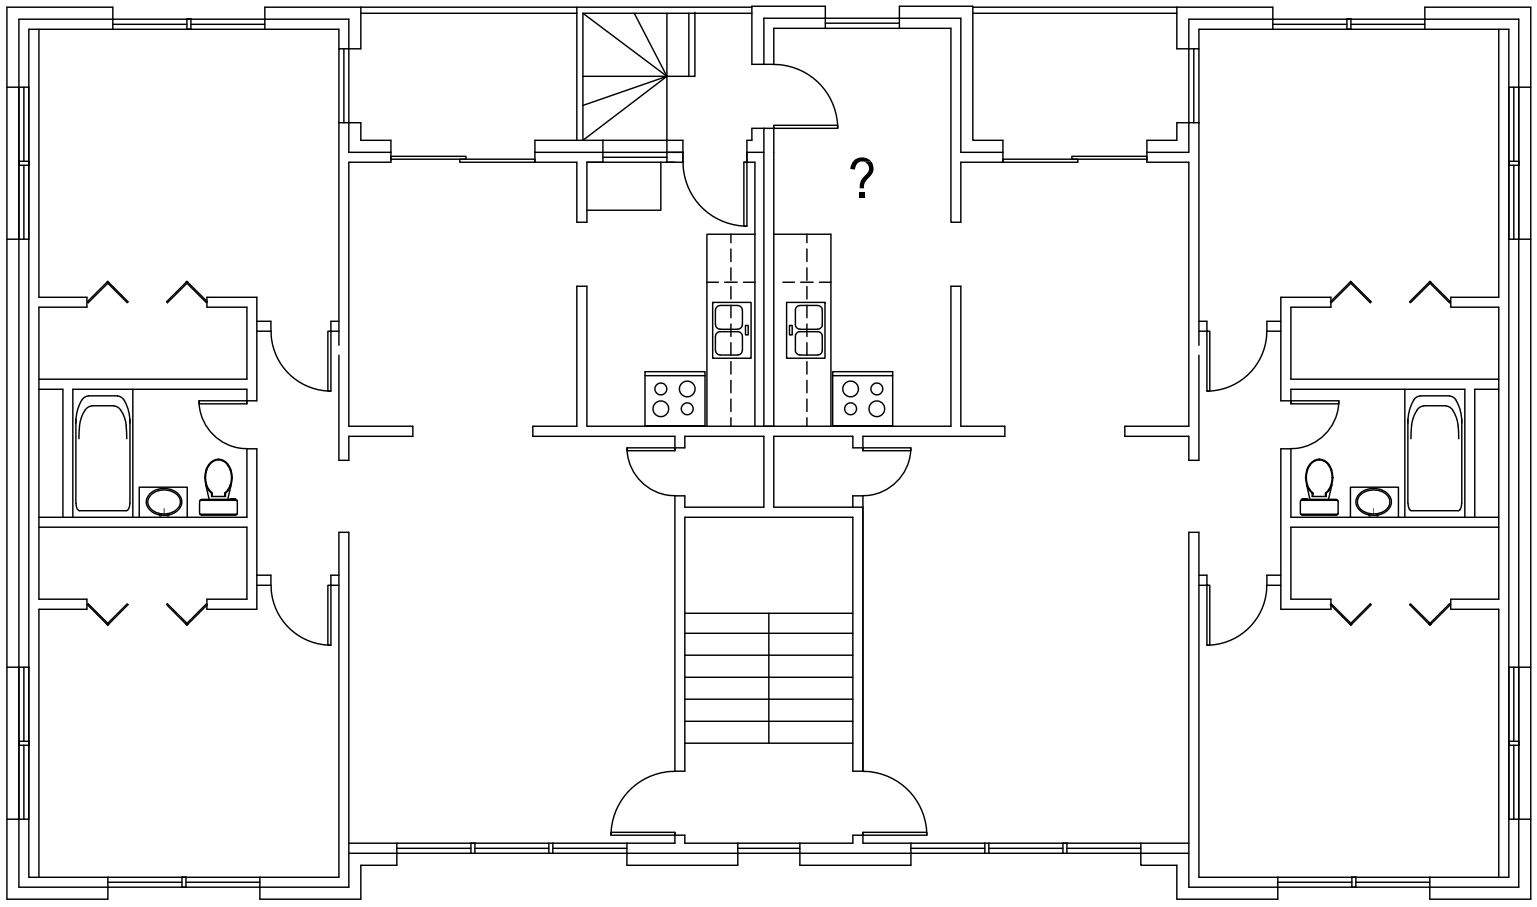

SUITE D
 910 SF

SUITE C
 950 SF

Lv 02

AS-BUILT

 2528 DRISCOLL
 HOUSTON TX, 77019

Legend

	New	Existing	Demo
Partitions	—	—	- - -
Electrical	⊕	⊕	⊕
Telephone	◀	◀	◀

FURNITURE SHOWN IS DIAGRAMMATIC AND DOES NOT REPRESENT ACTUAL DIMENSIONS AND PLACEMENT. IT IS RECOMMENDED THAT THE TENANT CONFIRM THE ACTUAL SIZE OF THE EXISTING FURNITURE. ALL DIMENSIONS ARE TO CENTER OF WALLS AND ARE APPROXIMATE TO THE INCH. ACTUAL DIMENSIONS TO BE CLARIFIED ON CONSTRUCTION DOCUMENTS.

PROJECT MANAGER:	PROJECT DRAFTER:
M. DOUGLASS	C SHEM
PLOT SCALE: 1/8"=1'-0"	
AREA CALCULATION: NA	
PROJECT INFORMATION: AS-BUILT 2528 DRISCOLL	
DRAWING NAME: SCHEMATIC DESIGN	
SHEET NUMBER:	

AB-2

PROJECT #
 18443.01