

John S. Glazman


Jacquelyn S. Willingham 8-31-06



- NOTES:
1. Plat Scale: 1" = 50'
 2. The bearings for this survey are based on the recorded deed as shown on this survey.
 3. Roads dedicated by recorded deed unless otherwise noted
 4. This plat of survey has been performed with reliance upon title examination and abstracting performed by Montgomery County Title Company under GF No.06080902 with an effective date of 08/01/06. This surveyor has not abstracted the subject property.

5. The professional service reflected on this plat of survey is provided in connection with the transaction anticipated by the title search referenced and dated above, it is not to be used for any other purpose. This original work is protected under copyright laws, Title 17 United States Code Sections 101 and 102. All violators will be prosecuted to the fullest extent of the law. This survey is being provided solely for the use of the recipients named below and no license has been created, expressed or implied, to copy the survey except as is necessary in conjunction with the original transaction, which shall take place within thirty (30) days from the date shown hereon.

Line Used for Directional Control
INWOOD ROAD

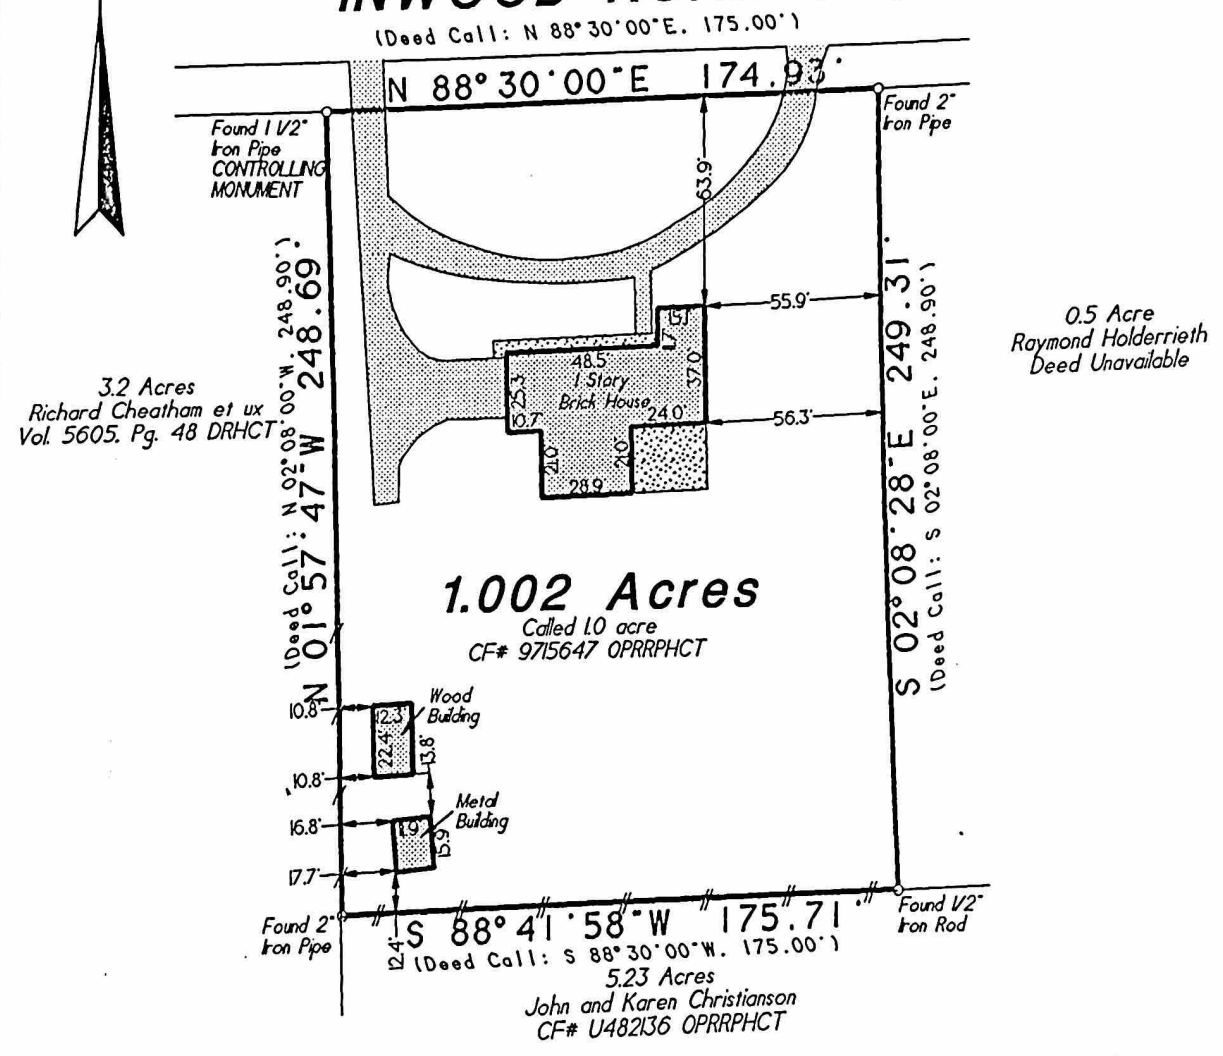

Being 1.002 acres of land situated in the Joseph House Survey, Abstract Number 34, Harris County, Texas, and being called 1.0 acre of land, described in deed recorded under Clerks File Number 9715647 of the Official Public Records of Real Property of Harris County, Texas; said 1.002 acres of land being further described by metes and bounds attached with all bearings being referenced to the South line of Inwood Road and the North line of the herein described tract as monumented on the ground:

If this plat and accompanying description are not sealed with the raised embossing seal of R.P.L.S. whose signature appears on the raised seal and in red ink, it is considered a copy, and not a legal original. See Note 5 above.

Purchaser: Lemons Auctioneers, LLP
Address: 1011 Inwood Street
Tomball, Texas 77375

Date: August 29, 2006 (pb)
GF No.: 06080902 Job No.: 2006-199

RPLS #4627

To: Montgomery County Title Company and Woodforest National Bank

We, Glezman Surveying, Inc., acting by and through Michael Glezman, a Registered Professional Land Surveyor in the State of Texas, hereby certify that this survey and professional service substantially conforms to the Texas Society of Professional Surveyors Standards and Specifications for a Category 1A, Condition II Survey.

© 2006 All Rights Reserved

Surveying Southeast Texas since 1907
GLEZMAN SURVEYING, INC.
1938 Old River Road
Montgomery, Texas 77356
Office: (409) 582-6340 www.glezmansurveying.com

