



- LEGEND:**
- CT COVERED TILE
 - W WATER METER BOX
 - E ELECTRIC METER
 - G GAS METER
 - FC FACE OF CURB
 - P PEDESTAL
 - AC AIR CONDITIONER
 - W WROUGHT IRON FENCE
 - FOUND 1/2" REBAR

Scale: 1" = 20'

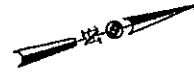

EVERGREEN LANE (50' ROW)

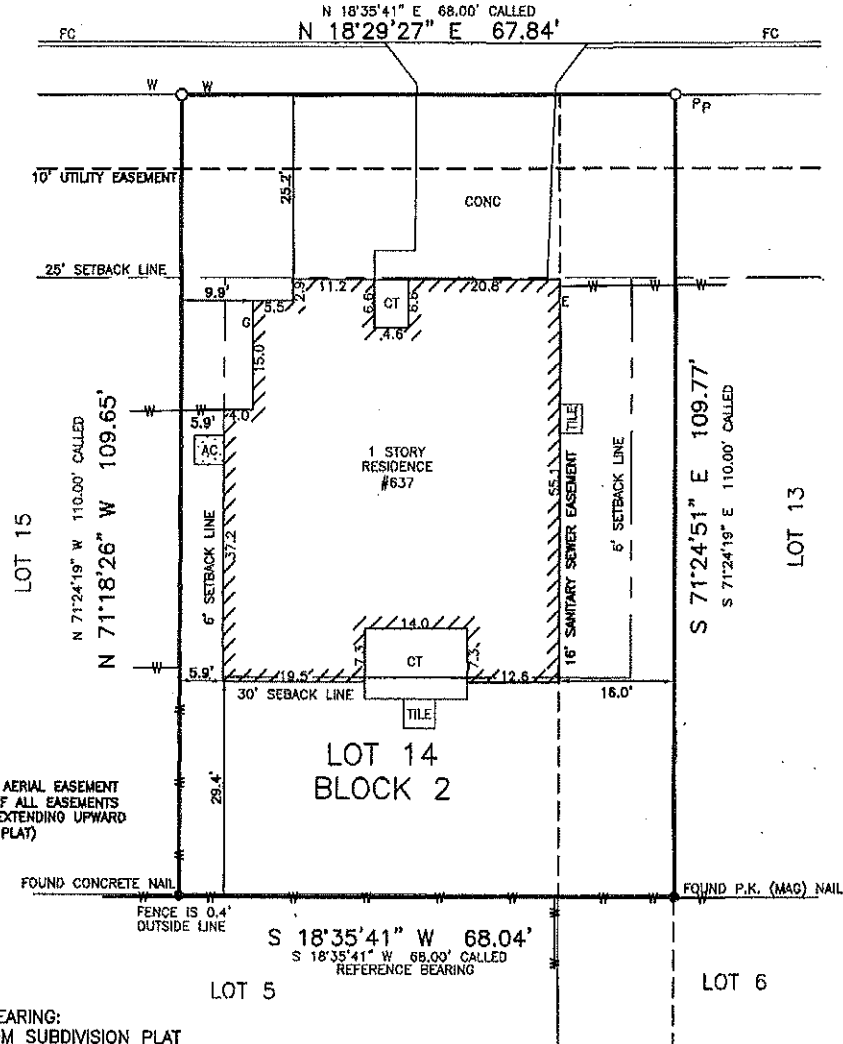

REFERENCE BEARING:
OBTAINED FROM SUBDIVISION PLAT

ADDRESS: 637 EVERGREEN LANE


- REFERENCES:
- VOL. 10, PG. 338
 - VOL. 52, PG. 183 *
 - VOL. 168, PG. 345 *
 - VOL. 170, PG. 568 *
 - VOL. 968, PG. 681
 - DCC# 9806008482
 - DCC# 200006005148
 - * DOES NOT APPLY

SURVEY PLAT SHOWING: LOT 14, BLOCK 2,
MISSION FOREST SUBDIVISION, UNIT ONE,
CITY OF NEW BRAUNFELS, COMAL COUNTY,
TEXAS, AS RECORDED IN VOLUME 10, PAGE
338, MAP AND PLAT RECORDS, COMAL
COUNTY, TEXAS



New Braunfels Branch Office

Texas Survey Firm 10194320
1011 West County Line Road
New Braunfels, Texas 78130
(P) 830/826.0337 (F) 830/826.3601

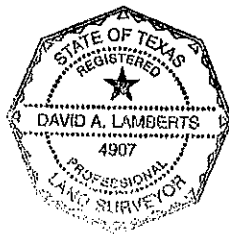

THIS PLAT SHOWS THE LOCATION
OF EASEMENTS, RESTRICTIONS, AND
BUILDING SETBACK LINES AS SET
FORTH IN SCHEDULE B OF
TITLE CO.: PROVIDENCE TITLE
G.F. #128001034
DATED: 06/05/18
THE SURVEYOR HAS NOT ABSTRACTED
THE SUBJECT PROPERTY.

I HEREBY CERTIFY THAT THIS SURVEY WAS MADE ON THE
GROUND, AND THAT TO THE BEST OF MY KNOWLEDGE AND
BELIEF, THIS PLAT CORRECTLY REPRESENTS THE FACTS
FOUND AT THE TIME OF THIS SURVEY AND THAT THERE ARE
NO VISIBLE EASEMENTS OR ENCROACHMENTS OF BUILDINGS
ON ADJOINING PROPERTY AND THAT ALL BUILDINGS ARE
WHOLLY LOCATED ON THIS PROPERTY EXCEPT AS SHOWN
ABOVE.

David A. Lamberts
DAVID A. LAMBERTS
REGISTERED PROFESSIONAL LAND SURVEYOR

4907
TEXAS REGISTRATION NO.
SURVEY NOT VALID UNLESS ORIGINAL
SIGNATURE IS IN RED INK
JOB # 201-800-166
DATE: 06/18/18

**T-47 RESIDENTIAL REAL PROPERTY AFFIDAVIT
(MAY BE MODIFIED AS APPROPRIATE FOR COMMERCIAL TRANSACTIONS)**

Date: 5/26/20

GF No. _____

Name of Affiant(s): Joshua Fuchs, Rachael Fuchs

Address of Affiant: 637 Evergreen Ln, New Braunfels, TX 78130-6679

Description of Property: Mission Forest Block 2 Lot 14

County Comal, Texas

"Title Company" as used herein is the Title Insurance Company whose policy of title insurance is issued in reliance upon the statements contained herein.

Before me, the undersigned notary for the State of Texas, personally appeared Affiant(s) who after by me being sworn, stated:

1. We are the owners of the Property. (Or state other basis for knowledge by Affiant(s) of the Property, such as lease, management, neighbor, etc. For example, "Affiant is the manager of the Property for the record title owners."):

2. We are familiar with the property and the improvements located on the Property.

3. We are closing a transaction requiring title insurance and the proposed insured owner or lender has requested area and boundary coverage in the title insurance policy(ies) to be issued in this transaction. We understand that the Title Company may make exceptions to the coverage of the title insurance as Title Company may deem appropriate. We understand that the owner of the property, if the current transaction is a sale, may request a similar amendment to the area and boundary coverage in the Owner's Policy of Title Insurance upon payment of the promulgated premium.


4. To the best of our actual knowledge and belief, since _____ there have been no:
a. construction projects such as new structures, additional buildings, rooms, garages, swimming pools or other permanent improvements or fixtures;
b. changes in the location of boundary fences or boundary walls;
c. construction projects on immediately adjoining property(ies) which encroach on the Property;
d. conveyances, replattings, easement grants and/or easement dedications (such as a utility line) by any party affecting the Property.

EXCEPT for the following (If None, Insert "None" Below): gate on right side & fence on left side

5. We understand that Title Company is relying on the truthfulness of the statements made in this affidavit to provide the area and boundary coverage and upon the evidence of the existing real property survey of the Property. This Affidavit is not made for the benefit of any other parties and this Affidavit does not constitute a warranty or guarantee of the location of improvements.

6. We understand that we have no liability to Title Company that will issue the policy(ies) should the information in this Affidavit be incorrect other than information that we personally know to be incorrect and which we do not disclose to the Title Company.

Josh Fuchs
Rachael Fuchs

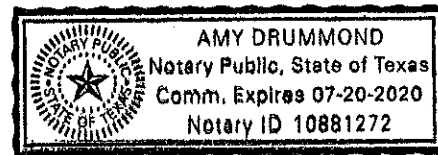

SWORN AND SUBSCRIBED this 26th day of May, 2020
Amy Drummond
Notary Public