


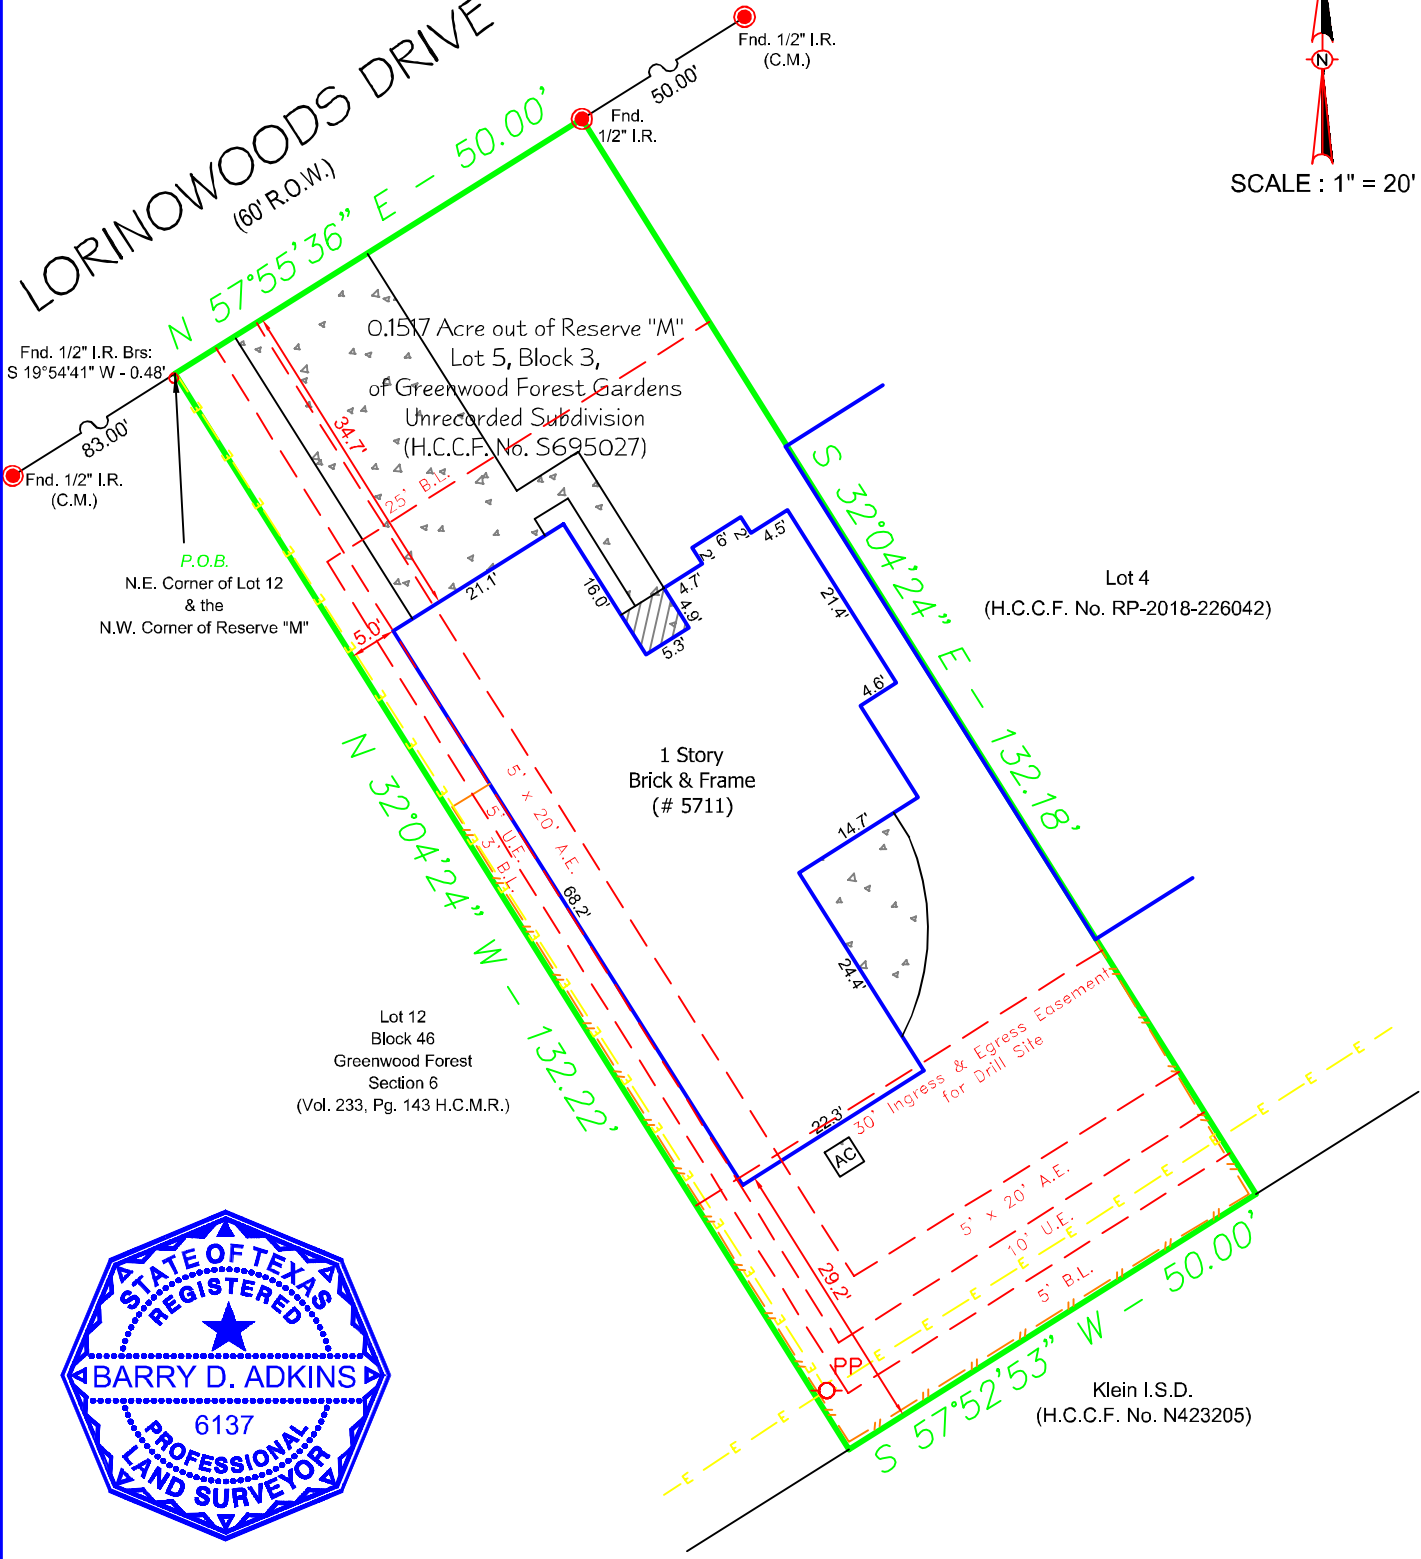

SCALE : 1" = 20'

LORINOWOODS DRIVE

(60' R.O.W.)



Notes :
- Basis for Bearings: Record plat.
- Distances shown are ground distances.
- All abstracting done by title company.
- All B.L.'s & U.E.'s taken from recorded plat unless otherwise noted.
- Dimension ties from improvements to property lines are calculated and should NOT be relied upon for construction and/or removal of any improvements including fences.
- Building dimensions may not be used to calculate square footage.
- This property subject to any and all recorded and unrecorded easements. Surveyor has made no investigation or independent search for easements of record, encumbrances, restrictive covenants or ownership title evidence.
- B.L. per record plat and H.C.C.F. No. D646686.

LEGEND :
U.E. = Utility Easement - - - - = Wood Fence
D.E. = Drainage Easement ○ - ○ = Chain Link
B.L. = Building Line - x - x = Barbed Wire
A.E. = Aerial Easement □ - □ = Wrought Iron
I.R. = Iron Rod ○ - ○ = Power Pole
C.M. = Control Monument - e - e = Overhead Powerline
H.C.M.R. = Harris County Map Record
H.C.C.F.No. = Harris County Clerk File Number

Barry D. Adkins
06/14/2020
BARRY D. ADKINS, R.P.L.S. No. 6137
This survey is certified for this transaction only, is not transferable to additional institutions or subsequent owners. If this survey does not bear an original BLUE seal it is invalid and should not be relied upon for any purpose.

This property appears to be OUT of the 100 year flood plain (Zone X); as per insurance rate map 48201C0435 M, dated 10/16/2013.

This determination to be used for flood insurance rate purposes ONLY and is NOT to be relied upon for ANY other purpose. Surveyor makes no representation as to whether property may Flood.

LOT:	5	BLOCK:	3	SUBDIVISION: GREENWOOD FOREST GARDENS / UNRECORDED SUBDIVISION			
RECORDATION:	HARRIS COUNTY CLERK'S FILE No. S695027			COUNTY:	HARRIS		
ADDRESS:	5711 LORINOWOODS DRIVE		CITY:	HOUSTON	STATE:	TEXAS	ZIP CODE: 77066
TITLE:	OLD REPUBLIC TITLE COMPANY OF HOUSTON		GF NO.:	20005748	PROPOSED INSURED: PM RENOVATIONS, LLC.		

DaRam Engineers, Inc.
11000 Richmond Avenue, Suite 300
Houston, Texas. 77042
(713) 528-1552 * Email: Info@daram.com

Survey firm #: 1194492
Engineering firm #: F-9503

Field Crew: RS
Drafter: TA
Project #: S202077066-Lorinowoods5711