

APRIL WIND SOUTH

Chord used for Directional Control: $S79^{\circ}39'05''W$ 75.26'

Found 5/8" Iron Rod Controlling Monument

Found "PC" 5/8" Iron Rod

Set 5/8" Iron Rod with Survey Cap marked "Glezman RPLS 4627"
 Found 1/2" Iron rod $S86^{\circ}24'08''W$ 4.39'

Set "X" in Concrete
 $N 78^{\circ}30'25'' E 124.82'$

APRIL WIND SOUTH




LEGEND

- Concrete Monument
- Electrical Transformer
- Gas Meter
- Fire Hydrant
- Monument
- Property Corner
- Light Pole
- Manhole
- Power Pole
- Cable Box
- Storm Inlet
- Telephone Pedestal
- Valve Box
- Water Meter

NOTES:

1. Plat Scale: 1" = 30'
2. The bearings for this survey are based on the recorded plat (record deed) shown on this survey.
3. Roads dedicated by recorded plat (record deed) unless otherwise noted.
4. This plat of survey has been performed with reliance upon title examination and abstracting performed by Old Republic Title Company under GF No. 1200252 with an effective date of 01/30/12. This surveyor has not abstracted the subject property.
5. The professional service reflected on this plat of survey is provided in connection with the transaction anticipated by the title search referenced and dated above. It is not to be used for any other purpose. This original work is protected under copyright laws, Title 17 United States Code Sections 101 and 102. All violators will be prosecuted to the fullest extent of the law. This survey is being provided solely for the use of the recipients named below and no license has been created, expressed or implied, to copy the survey except as is necessary in conjunction with the original transaction, which shall take place within thirty (30) days from the date shown hereon.
6. 5/8" Iron Rods with survey cap marked "Glezman 4627" set at all property corners unless otherwise noted.
7. Subject to restrictions as recorded in the RPRMCT under County Clerk's File Nos. 8430795, 8523414, 9567835, 9567836, 9903717L, 2001-011562, 2002-009734, 2002-031570, 2002-11034L, 2003-05284L, 200309972, 2004-066642, 2006-108006, 2006-133880, 2007-013686, 2007-073417, and 2008-001322.
8. Easement granted to Montgomery County Municipal Utility District No. 3, recorded in Vol. 810, Pg. 693 of the DRMCT.

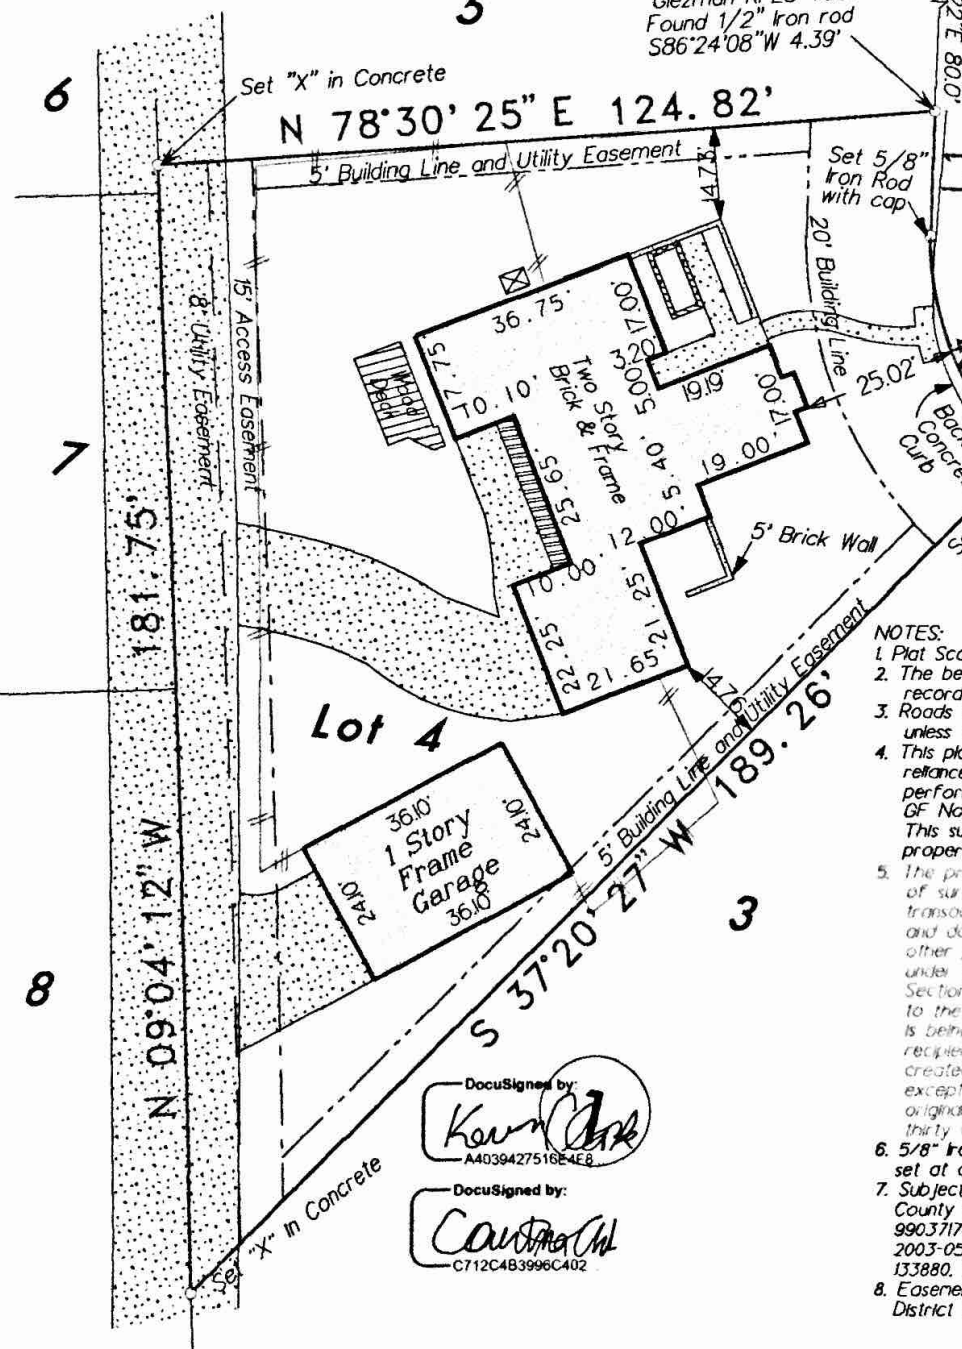

DocuSigned by:

 A4039427516E4E8

DocuSigned by:

 C712C4B3996C402

Lot Four (4), in Block One (1), of April Sound, Section One (1), according to map or plat thereof recorded in Cabinet A, Sheet 88 (formerly recorded in Volume 10, Page 72) of the Map Records of Montgomery County, Texas.

If this plat and accompanying description are not sealed with the raised embossing seal of R.P.L.S. whose signature appears on the raised seal and in red ink, it is considered a copy, and not a legal original. See Note 5 above.

Purchaser: **Kevin William Clark**
 Address: **93 April Wind South**
Montgomery, Texas 77356

GF No.: **1200252** Date: **02/03/12**
 Job No.: **2012-018**

RPLS #4627

To: **Old Republic Title Company and Orange Savings Bank, ssb**
 We, Glezman Surveying, Inc., acting by and through Michael Glezman, a Registered Professional Land Surveyor in the State of Texas, hereby certify that this survey and professional service substantially complies with the Texas Society of Professional