


- LEGEND**
- ⊗ Concrete Monument
 - ⊠ Electrical Transformer
 - ⊞ Gas Meter
 - ⊙ Fire Hydrant
 - ⊙ Monument
 - ⊙ Property Corner
 - ⊙ Light Pole
 - ⊙ Manhole
 - ⊙ Power Pole
 - ⊙ Catch Bas
 - ⊙ Storm Islet
 - ⊙ Telephone Pole/Post
 - ⊙ Traversed Point
 - ⊙ Tree
 - ⊙ Valve Box
 - ⊙ Water Meter
 - L.S.D. Landscape Easement
 - R.L. Right of Way
 - U.E. Utility Easement
 - A.E. Aerial Easement
 - Fence

NOTES:

1. Plat Scale 1" = 20'
2. The bearings for this survey are based on the recorded plat (record deed) shown on this survey.
3. Woods dedicated by record plat (record deed) unless otherwise noted.
4. This survey was performed without benefit of a Title Report and therefore may not reflect all Building Set Back Lines, Easement, Deed Restrictions and other matters of record.

5. The professional services reflected on this plat of survey is provided in connection with the transaction anticipated by the file shown referenced and dated above, it is not to be used for any other purpose. This original work is protected under copy right laws, 17 United States Code Section 101 and 102, All violations will be prosecuted to the fullest extent of the law. This survey is being provided solely for the use of the recipient named below and no license has been created, expressed or implied, in connection with the original transaction, which shall take place within thirty (30) days from the date shown hereon.
6. 5/8" Iron Rods with survey cap marked "Glezman 4627" set at all property corners unless otherwise noted.

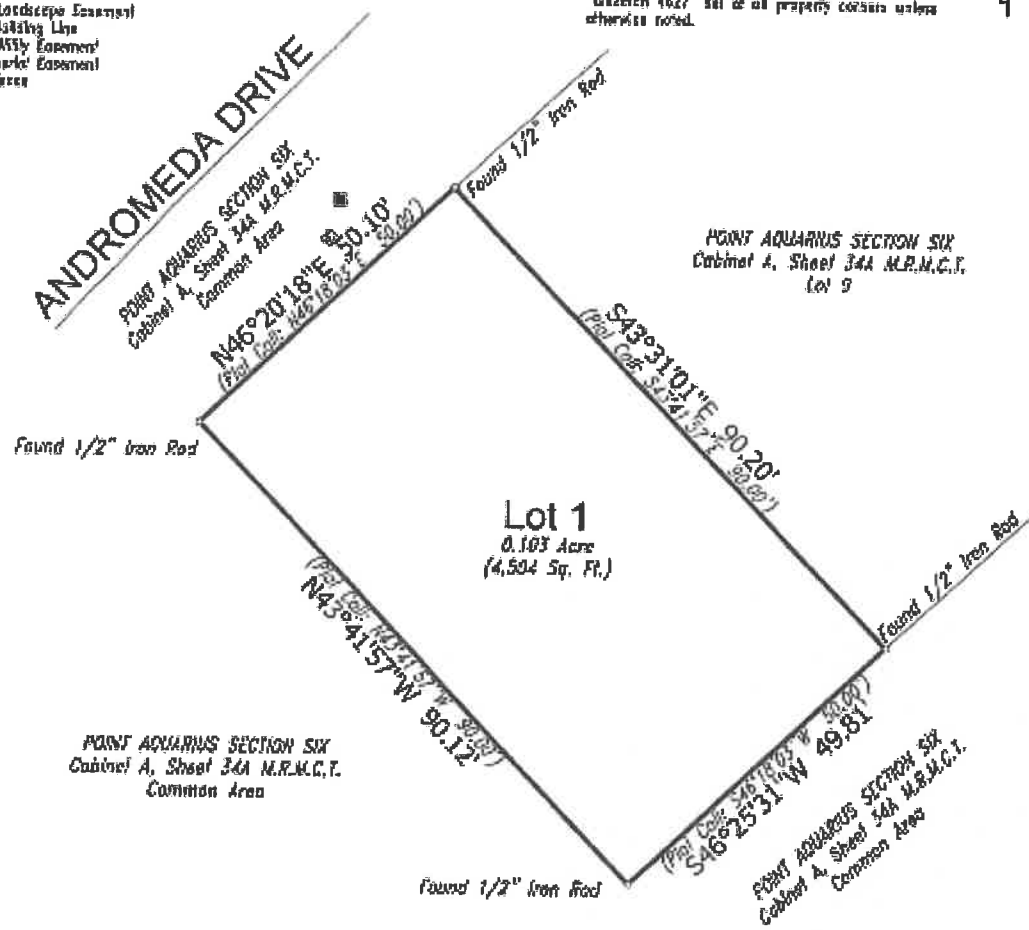

Lot 1, Block 1, of MOREHEAD REPLAT, a Subdivision in Montgomery County, Texas, according to the map or plat thereof recorded in Cabinet Z, Sheet 2563 of the Map Records of Montgomery County, Texas.

If this plat and accompanying description are not sealed with the proper seal of THIS state signature appears on the reverse side and in red ink, it is considered a copy, and not a legal original. See Rule 5 above.

Purchaser: Anthony Malliano
 Address: 12182 Andromeda Drive
 Willis Texas, 77318

Date: 10/09/2014
 Job No.: 2014-217



TO: Anthony Malliano
 We, Glezman Surveying, Inc., acting by and through Michael Glezman, a Registered Professional Land Surveyor in the State of Texas, certify that this survey and professional services substantially complies with the Texas Society of Professional Surveyors Standards and Specifications for a Category 1A, Condition 10 Survey.

© 2014 All Rights Reserved

Surveying Since 1867
GLEZMAN SURVEYING, INC.
 1539 Old River Road
 Montgomery, Texas
 Office (936) 587-6340 www.glezmansurveying.com

