


- The bearings for this survey are based on the recorded plat (record deed) shown on this survey.
- Roads dedicated by recorded plat (record deed) unless otherwise noted.
- This plat of survey has been performed with reliance upon title examination and abstracting performed by Chicago Title Company under GF No. 3346712-1 effective date of 02/11/2016. This surveyor has not abstracted the subject property.

Restriction as set forth in Cabinet C, Sheets 4A and 4B, Map Records and Volume 1 1 10 Page 582, Instrument Nos. 2000-01 0504, 2000-088358, 2002-0028582, 2003-137591, 2004-123560, 2006-043782, 2005-140823, 2006073735, 20061 00598, 2007079838, 20 10076084, 2010080411, 201 1 000758, 201 1000789, 201000780, 201028242, 20 1 1 029243, 201028244, 201035432, 201035433, 201 1 048587, 201 1 069848, 20 1 1 068981, 201068982, 201068772, 201 1 068773, 201068774, 201068775, 201 1 068198, 201068198, 201068200, 201068202, 201 1 1 068508, 2012018444, 2012031548, 2012050548, 2012075548, 2012078547, 2012108414, 2013045048, 2013097533, 2013132434, 201313681 4, 2014104083, 2014119388, 2015027811, 2015087078, 2015070881, 2015078068 and 2015088078, Real Property Records, Montgomery County, Texas.

- The professional service reflected on this plat of survey is provided in connection with the transaction anticipated by the title search referenced and dated above, it is not to be used for any other purpose. This original work is protected under copyright laws, Title 17 United States Code Sections 101 and 102. All violators will be prosecuted to the fullest extent of the law. This survey is being provided solely for the use of the recipients named below and no license has been created, expressed or implied, to copy the survey except as is necessary in conjunction with the original transaction, which shall take place within thirty (30) days from the date shown herein.
- 5/8" Iron Rods with survey cap marked "Glzman 4627" set at all property corners unless otherwise noted.

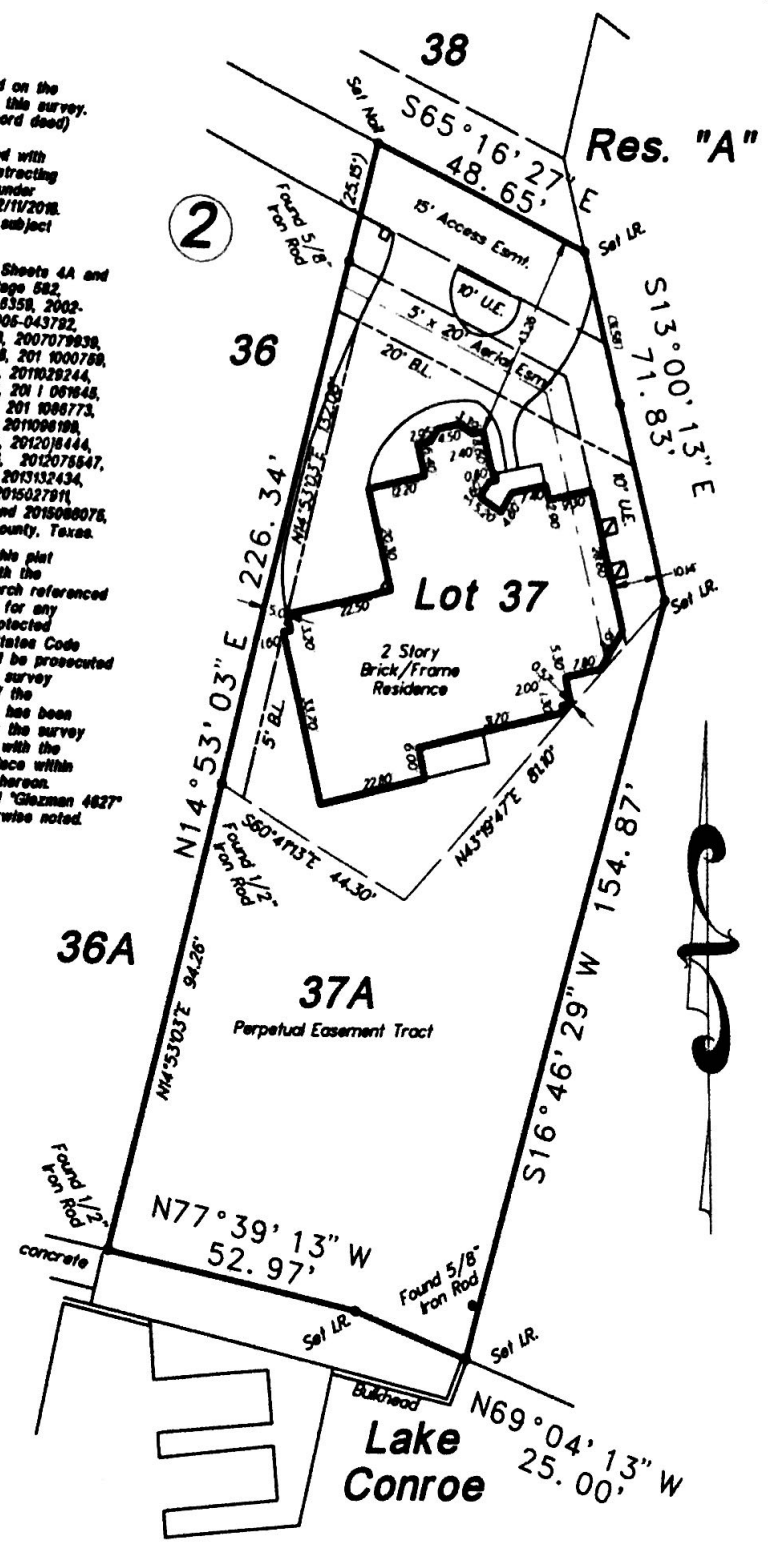


- LEGEND**
- ⊙ Concrete Monument
 - ⊠ Electrical Transformer
 - ⊡ Gas Meter
 - ⊙ Fire Hydrant
 - ⊙ Monument
 - ⊙ Property Corner
 - ⊙ Light Pole
 - ⊙ Manhole
 - ⊙ Power Pole
 - ⊙ Cable Box
 - ⊙ Storm Inlet
 - ⊙ Telephone Pedestal
 - ⊙ Traverse Point
 - Tree
 - Valve Box
 - Water Meter

LOT 37 (TRACT 1-FEE SIMPLE) AND 37-A (TRACT 2-EASEMENT ONLY) IN BLOCK 2, OF WALDEN ON LAKE CONROE, SECTION FOURTEEN (14), A SUBDIVISION IN MONTGOMERY COUNTY, TEXAS, ACCORDING TO THE MAP OR PLAT THEREOF RECORDED IN CABINET C, SHEETS 4A AND 4B OF THE MAP RECORDS OF MONTGOMERY COUNTY, TEXAS.

Purchaser: **William R. Hamilton**
 Address: **2803 Pine Arbor**
Montgomery, Texas 77356

If this plat and accompanying description are not sealed with the raised embossing seal of R.P.L.S. whose signature appears on the raised seal and in red ink, it is considered a copy, and not a legal original. See Note 5 above. Date: **March 8, 2016**
 Job No.: **2016-032**

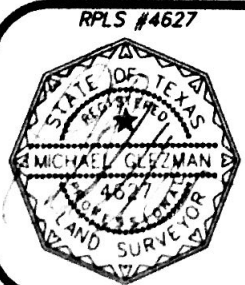

to: **ServiceLink of Texas, LLC, Chicago Title Insurance**
 We, Glzman Surveying, Inc., acting by and through Michael Glzman, a Registered Professional Land Surveyor in the State of Texas, hereby certify that this survey and professional service substantially complies with the Texas Society of Professional Surveyors Standards and Specifications for a Category 1A, Condition 111 Survey.

© 2016 All Rights Reserved FRM 10039200

Surveying Southern Texas since 1957
GLEZMAN SURVEYING, INC.
 1938 Old River Road
 Montgomery, Texas 77356
 Office (409) 502-6340 www.glezmansurveying.com