
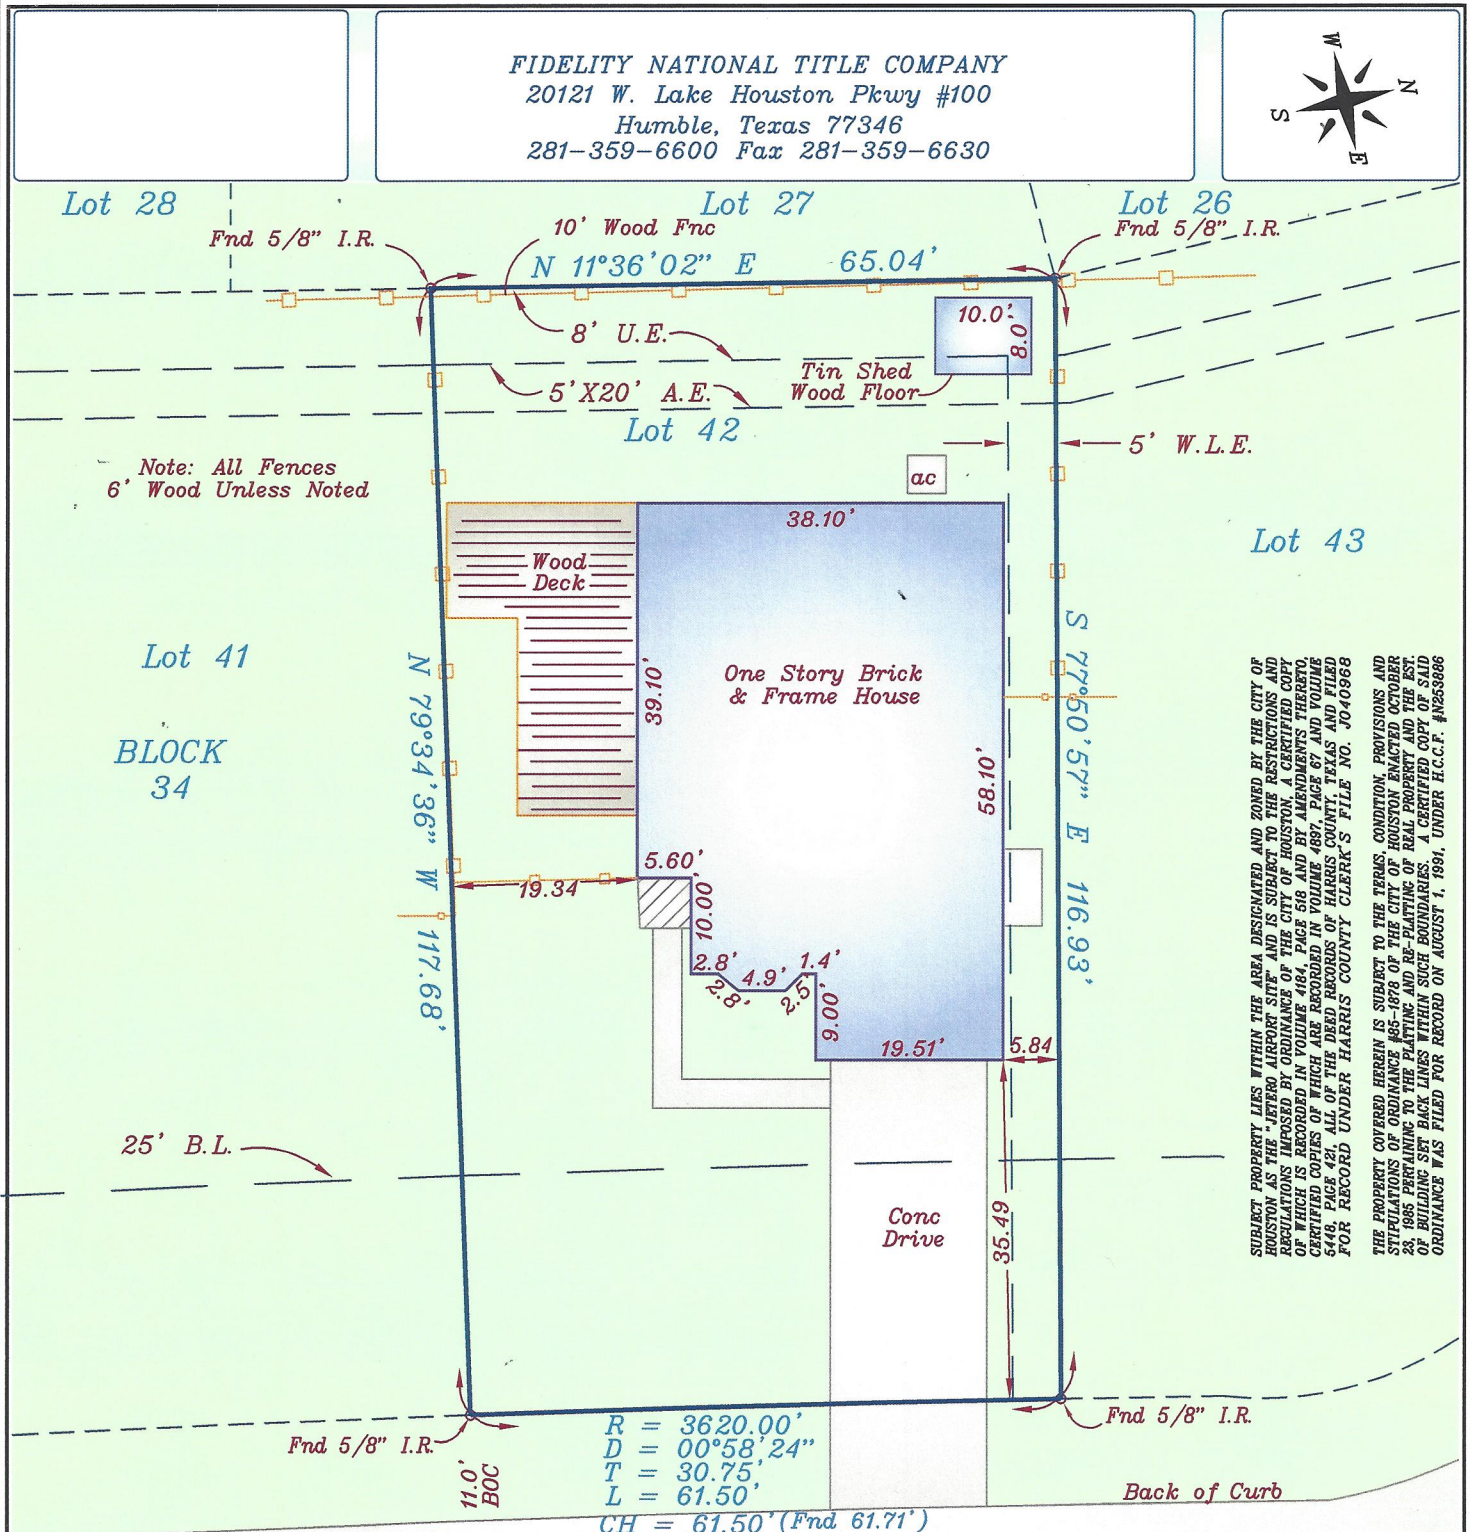


FIDELITY NATIONAL TITLE COMPANY
 20121 W. Lake Houston Pkwy #100
 Humble, Texas 77346
 281-359-6600 Fax 281-359-6630

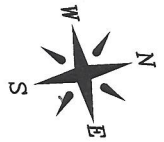

SUBJECT PROPERTY LIES WITHIN THE AREA DESIGNATED AND ZONED BY THE CITY OF HOUSTON AS THE "UTERO AIRPORT SITE" AND IS SUBJECT TO THE RESTRICTIONS AND REGULATIONS IMPOSED BY ORDINANCE OF THE CITY OF HOUSTON, A CERTIFIED COPY OF WHICH IS RECORDED IN VOLUME 484 PAGE 516 AND BY AMENDMENTS THERE TO CERTIFIED COPIES OF WHICH ARE RECORDED IN VOLUME 4897 PAGE 67 AND VOLUME 5449 PAGE 421. ALL OF THE DEED RECORDS OF HARRIS COUNTY, TEXAS AND FILED FOR RECORD UNDER HARRIS COUNTY CLERK'S FILE NO. J040968
 THE PROPERTY COVERED HEREIN IS SUBJECT TO THE TERMS, CONDITION, PROVISIONS AND STIPULATIONS OF ORDINANCE #65-1878 OF THE CITY OF HOUSTON ENACTED OCTOBER 23, 1965 PERTAINING TO THE PLATTING AND RE-PLATTING OF REAL PROPERTY AND THE EST. OF BUILDING SET BACK LINES WITHIN SUCH BOUNDARIES. A CERTIFIED COPY OF SAID ORDINANCE WAS FILED FOR RECORD ON AUGUST 1, 1991, UNDER H.C.C.F. #N253866

GLADE ESTATES DRIVE (50' R.O.W.)

SUBJECT PROPERTY LIES WITHIN THE BOUNDARIES OF HARRIS COUNTY UTILITY DISTRICT NO. 10 AGREEMENT WITH H.L. & P. CO. FOR UNDERGROUND/OVERHEAD ELECTRIC SERVICES AS DESCRIBED IN INSTRUMENT RECORDED IN H.C.C.F. NO. 631804

NOTE:
 - BASIS FOR BEARINGS: ASSUMED AS PLATTED
 - DISTANCES SHOWN ARE GROUND DISTANCES
 - ALL ABSTRACTING DONE BY TITLE COMPANY

LEGEND:
 - U.E. - UTILITY EASEMENT
 - W.L.E. - WATER LINE EASEMENT
 - A.E. - UNOBSTRUCTED AERIAL EASEMENT
 - B.L. - BUILDING LINE
 - C.I.R. - CAPPED IRON ROD
 (ALL AS PER RECORDED PLAT OF SUBDIVISION)
 - □ - WOOD FENCE
 - ○ - CHN. LINK FENCE

3 FOOT UNOBSTRUCTED DRAINAGE EASEMENT ADJACENT AND PARALLEL TO EACH OF THE SIDE LOT LINES PER H.C.C.F. NO. L048435


AN EASEMENT 2 FEET IN WIDTH, CENTERED ALONG THE UNDERGROUND ELECTRIC SERVICE LINE AS INSTALLED FROM THE UTILITY EASEMENT TO THE POINT OF SERVICE ON THE RESIDENTIAL STRUCTURE AS GRANTED TO H.L. & P. CO. BY INSTRUMENT FILED UNDER H.C.C.F. NO. J403550

ANNUAL MAINTENANCE CHARGE AND SPECIAL ASSESSMENTS AS SET FORTH IN INSTRUMENTS FILED FOR RECORD UNDER H.C.C.F. NOS. D757823, E737263, E961352, K025971 AND F211306 (annexed by K025972)

DRAINAGE EASEMENT FIFTEEN (15) FEET IN WIDTH ON EACH SIDE OF THE CENTER LINE OF ALL NATURAL DRAINAGE COURSES AS SHOWN BY THE RECORDED PLAT OF SAID SUBDIVISION.

THE CERTIFICATION SHOWN HEREON IS REVOKED AND THIS SURVEY IS NULL AND VOID IF THIS DOCUMENT IS ALTERED IN ANY MANNER, USED OR RELIED UPON BY ANY PERSON OTHER THAN THOSE ADDRESSED HEREON, OR DOES NOT BEAR AN ORIGINAL SEAL AND SIGNATURE OF THE SURVEYOR ON A BLUELINE COPY

ACCORDING TO FLOOD INSURANCE RATE MAP 4.8.2.0.1.C.0.3.0.5.K DATED 4-20-2000 THIS TRACT HEREBY SURVEYED LIES WITHIN ZONE "X" AND IS NOT IN THE 100 YEAR FLOOD PLAIN. THIS STATEMENT IS BASED ON SCALING THE LOCATION OF SAID SURVEY ON THE ABOVE REFERENCED MAP AND IS FOR FLOOD INSURANCE RATES ONLY AND NOT INTENDED TO IDENTIFY SPECIFIC FLOODING CONDITIONS.

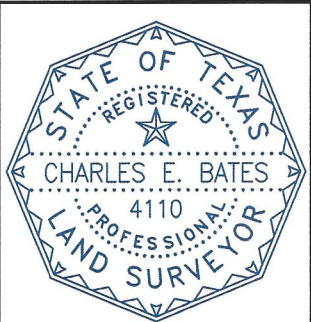

TETRA

SURVEYS & APPRAISALS
 5909 WEST LOOP SOUTH SUITE 600
 BELLAIRE, TEXAS 77401
 (713)462-6100 FAX (713)432-1003

BORROWER: **RONALD RADFORD**

ADDRESS: **3427 GLADE ESTATES DRIVE**

LOT:	42	BLOCK:	34
SUBDIVISION			
ELM GROVE VILLAGE SECTION THREE (3)			
RECORDING			
VOL:	309	PG:	56 M/R
SURVEY & ABSTRACT			
H.T. & B. R.R. CO. SURVEY NO. 5, A-422			
CITY	KINGWOOD	COUNTY	HARRIS
STATE	TEXAS		

THE UNDERSIGNED HEREBY CERTIFIES THAT THIS SURVEY WAS MADE ON THE GROUND UNDER MY SUPERVISION, AND THAT THIS PLAT REPRESENTS THE FACTS AS FOUND AT THE TIME OF THE SURVEY.

SIGNED: *Charles E. Bates*
CHARLES E. BATES
 REGISTERED PROFESSIONAL LAND SURVEYOR NO 4110

SCALE: 1" = 20'
 DATE: 1-27-07
 DRAWN: dbt

G.F. NUMBER: 07-31667
 FIDELITY NATIONAL TITLE

JOB NO.: 087N701