



MONTGOMERY COUNTY
ENVIRONMENTAL HEALTH SERVICES
501 N. THOMPSON, SUITE 1010
CONROE, TEXAS 77301
(936)539-7839 * (281)364-4200, EXT 7839 * FAX (936-)539-7961

REQUEST FOR PUBLIC INFORMATION
(use of this form is not required)

Name: ANN BEETZ
Address: 6700 WOODLANDS PKWY, STE230 #223
Email: INFO@MEINERSSEPTIC.COM

Date of Request: 11/5/2020
City/State/Zip: SPRING
Phone #: 832-856-4003

Please provide as much of the following information as possible in order to identify responsive documents:

Owner's Name (current and /or former):

Address: 12019 Samantha Ln Magnolia TX 77354 Permit Number (if known)
Address City/Zip

Legal Description: _____

Information requested – Select ONE or more of the following (please complete a separate request if you need different types of information).

THE PUBLIC INFORMATION VERSINO OF A REPORT RELATED TO THE FOLLOWING ADDRESS:

Typically provided to requestor within 10 business days at no charge. Failure to select this option could result in documents being sent to Texas Attorney General for an opinion on release of relevant documents and could take up to 60 days to complete.

I AM REQUESTING THE PERMIT NUMBER FOR THE FOLLOWING ADDRESS:

I AM REQUESTING records/permits for issues of environmental concerns for the property listed at the following address:

OTHER. PLEASE IDENTIFY REQUESTED INFORMATION AS FOLLOWS:

Note: Selecting "OTHER" may result in documents being submitted to Texas Attorney General's Office for a ruling as to if documents may be released, a process that may take approximately 60 business days. Charges for copies may be billed as authorized by Chapter 552 of the Texas Government Code.

I agree and authorize redaction of statutorily confidential and discretionary information as recognized under the Texas Public Information Act and reasonable common-privacy practices. Note: failure to select may cause delay in release of documents.

Signature of Requestor: Ann Beetz

ENVIRONMENTAL



MONTGOMERY COUNTY HEALTH DEPARTMENT

ENVIRONMENTAL DIVISION

301 North Thompson, Suites 207 & 208
Conroe, Texas 77301

(409) 539-7839 * (713) 353-9791 x 7839

LICENSE TO OPERATE A SEPTIC SYSTEM

License No: 41617-98

Owner: VENANZIO A. CASSATA

Mailing Address: 12847 HIGHLAND HILLS, CYPRESS, TEXAS 77429

Old Septic #:

Phone H)

W) 281.357.8464

Legal Description: 5

Address: SAMANTHA RD

Lot/Property Size:

Water System: PRIVATE WELL

Bedrooms: 3

Sq. ft. Of Living Area: 2800

Well Distance from:

Line: 100 ft. Tank: 50 ft.

G.P.D. 300

FINAL INSPECTION AND DIAGRAM

Septic System Meets Minimum Montgomery County and State of Texas Standards: Y

Tank Capacity Installed: 1000-500P Gal. Trench Area Installed: 8478 Sq. Ft.

Septic system: RESIDENTIAL-NEW

Type Of System: SURFACE APPLICATION

Installer : Pate, Stephen M.

Design By: SP

Telephone: 281-356-2526

SEE ATTACHED DESIGN.


Comments:

Inspected By: [Signature]

Date: 6/18/98

Permit Issued By: [Signature]

Date: 6/19/98

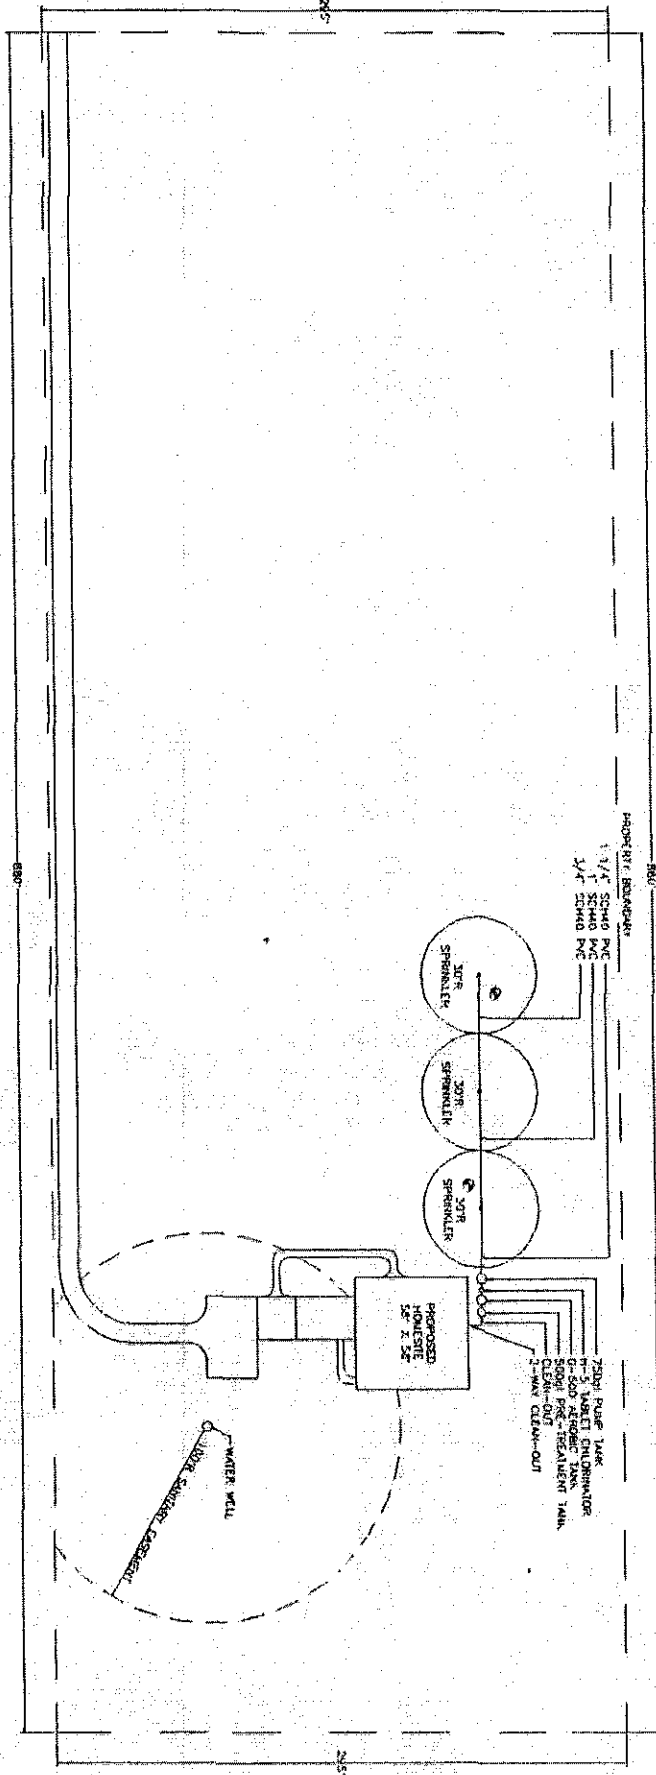

88'-0"

24'-0"

750PSI PUMP TAKE
 5 GAL PER MINUTE CHLORINATOR
 150 GAL PER MINUTE TREATMENT TANK
 CLEAN-OUT
 2-WAY CLEAN-OUT

30" DIAM
 30" DIAM
 30" DIAM
 SEPTIC TANKS


PROPOSED HOUSE
 28' x 52'

WATER WELL

30" DIAM CLEAN-OUT

88'-0"

TEST HOLE FOR SOIL ANALYSIS

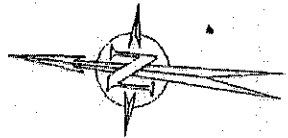

SOIL ANALYSIS PATE SEPTIC DESIGNS 26211 F.M. 2978 CONSTRUCTION MAGNOLIA, TEXAS 77355 INSTALLATIONS OFFICE (281) 356-5526 FAX (281) 356-8853			
SCALE:	DATE:	DRAWN BY:	COUNTY:
1" = 100'	01/06/98	JS	MONTGOMERY
MIKE CASSATA SAMANTHA ROAD MAGNOLIA, TEXAS 77354			