


2006 JR 603594--U AMERICAN TITLE  
 ADDRESS: 1354 TRAILWOOD VILLAGE DRIVE  
 KINGWOOD, TEXAS 77339  
 BORROWER: DONNA LYNN KINCER

# LOT 25, BLOCK 31 TRAILWOOD VILLAGE, SECTION 5

ACCORDING TO THE MAP OR PLAT THEREOF RECORDED  
 IN VOLUME 239, PAGE 87 OF THE MAP RECORDS  
 OF HARRIS COUNTY, TEXAS

SCALE: 1" = 30'

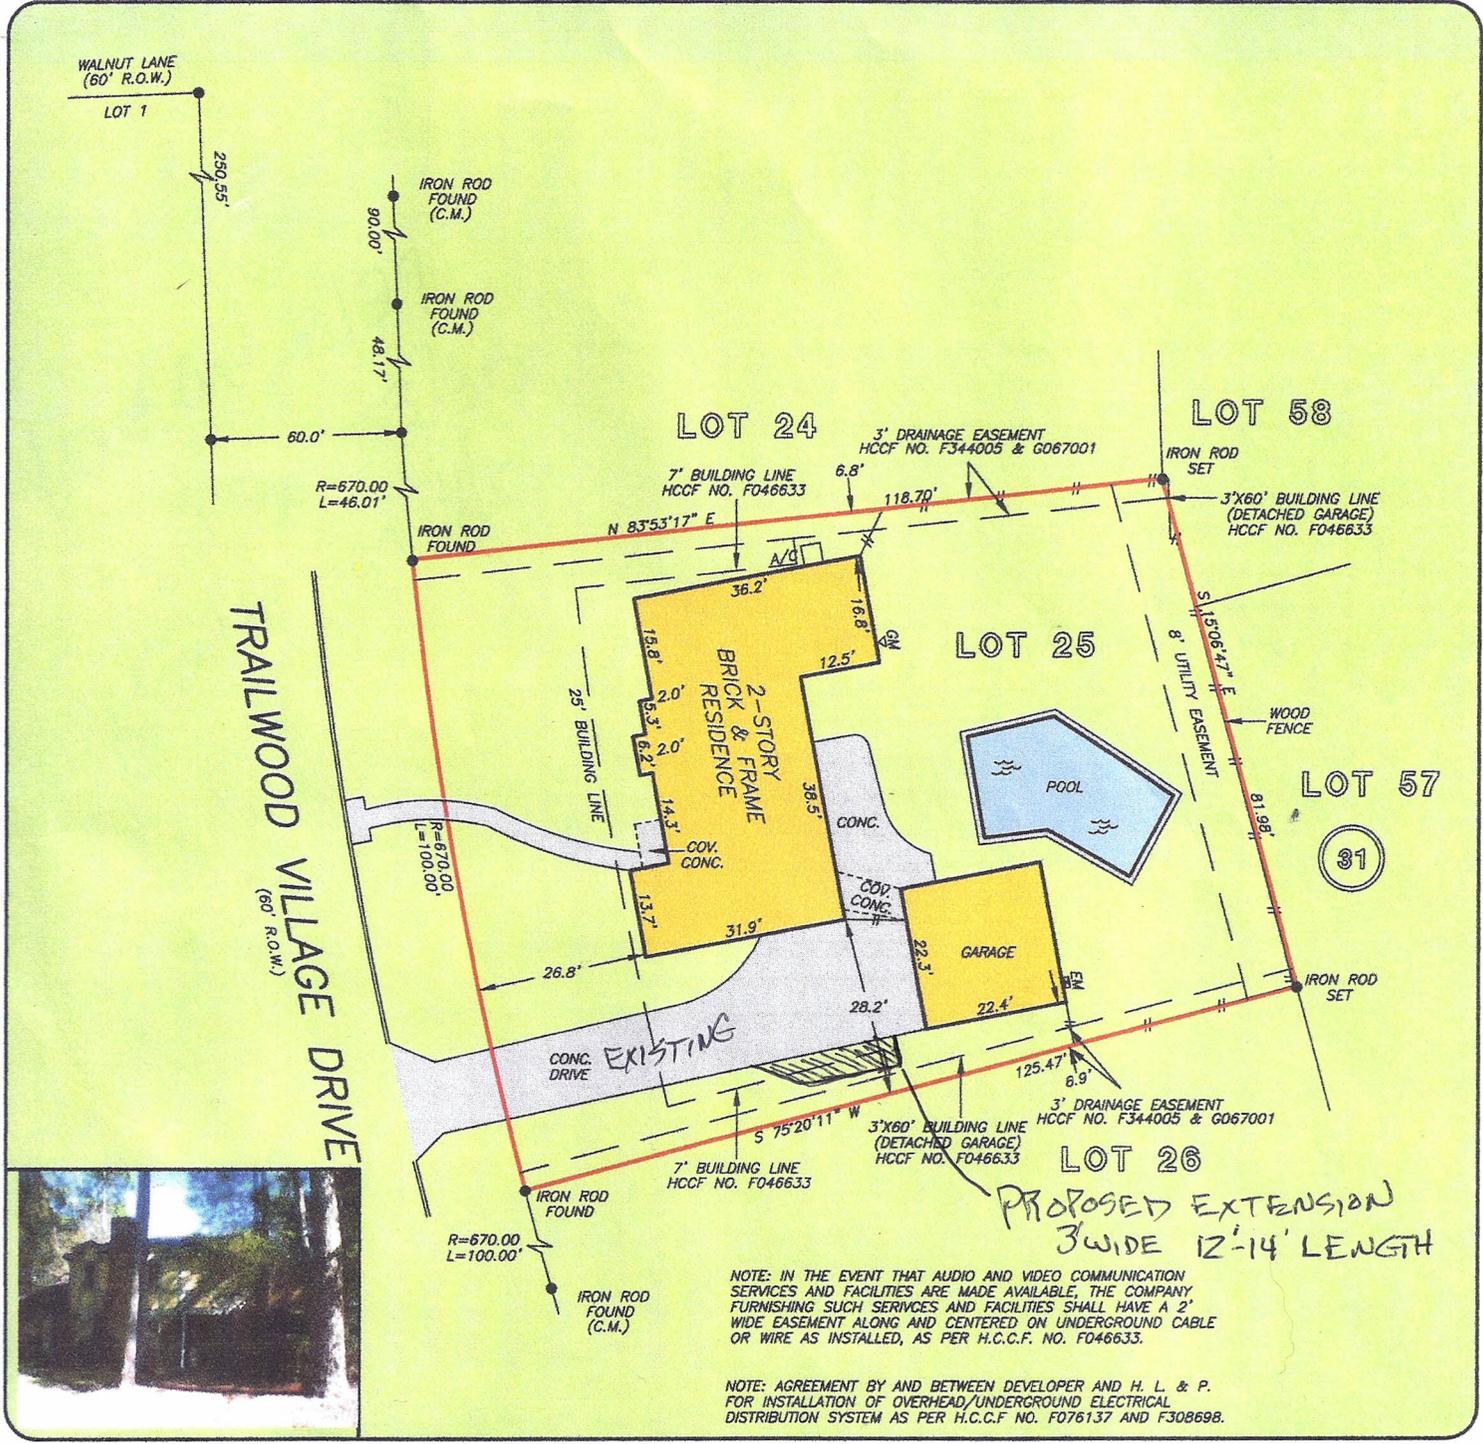

NOTE: IN THE EVENT THAT AUDIO AND VIDEO COMMUNICATION SERVICES AND FACILITIES ARE MADE AVAILABLE, THE COMPANY FURNISHING SUCH SERVICES AND FACILITIES SHALL HAVE A 2' WIDE EASEMENT ALONG AND CENTERED ON UNDERGROUND CABLE OR WIRE AS INSTALLED, AS PER H.C.C.F. NO. F046633.

NOTE: AGREEMENT BY AND BETWEEN DEVELOPER AND H. L. & P. FOR INSTALLATION OF OVERHEAD/UNDERGROUND ELECTRICAL DISTRIBUTION SYSTEM AS PER H.C.C.F. NO. F076137 AND F308698.

PROPOSED EXTENSION  
 3' WIDE 12'-14' LENGTH

THIS PROPERTY DOES NOT LIE WITHIN THE 100 YEAR FLOOD PLAIN AS PER FIRM PANEL NO. 48201C 0315 K

I HEREBY CERTIFY THAT THIS SURVEY WAS MADE ON THE GROUND, THAT THIS PLAT CORRECTLY REPRESENTS THE FACTS FOUND AT THE TIME OF SURVEY AND THAT THERE ARE NO

