


X X
SLATER
12530 JETTY COVE DR - LAGO MAR
JOB #LGM0022
DABNEY
***LAY TILE AT MASTER BATH & BTH #2 -
OFFSET AT 33% SIDE TO SIDE. ***LAY TILE
AT UTILITY & BTH #4 - STRAIGHT

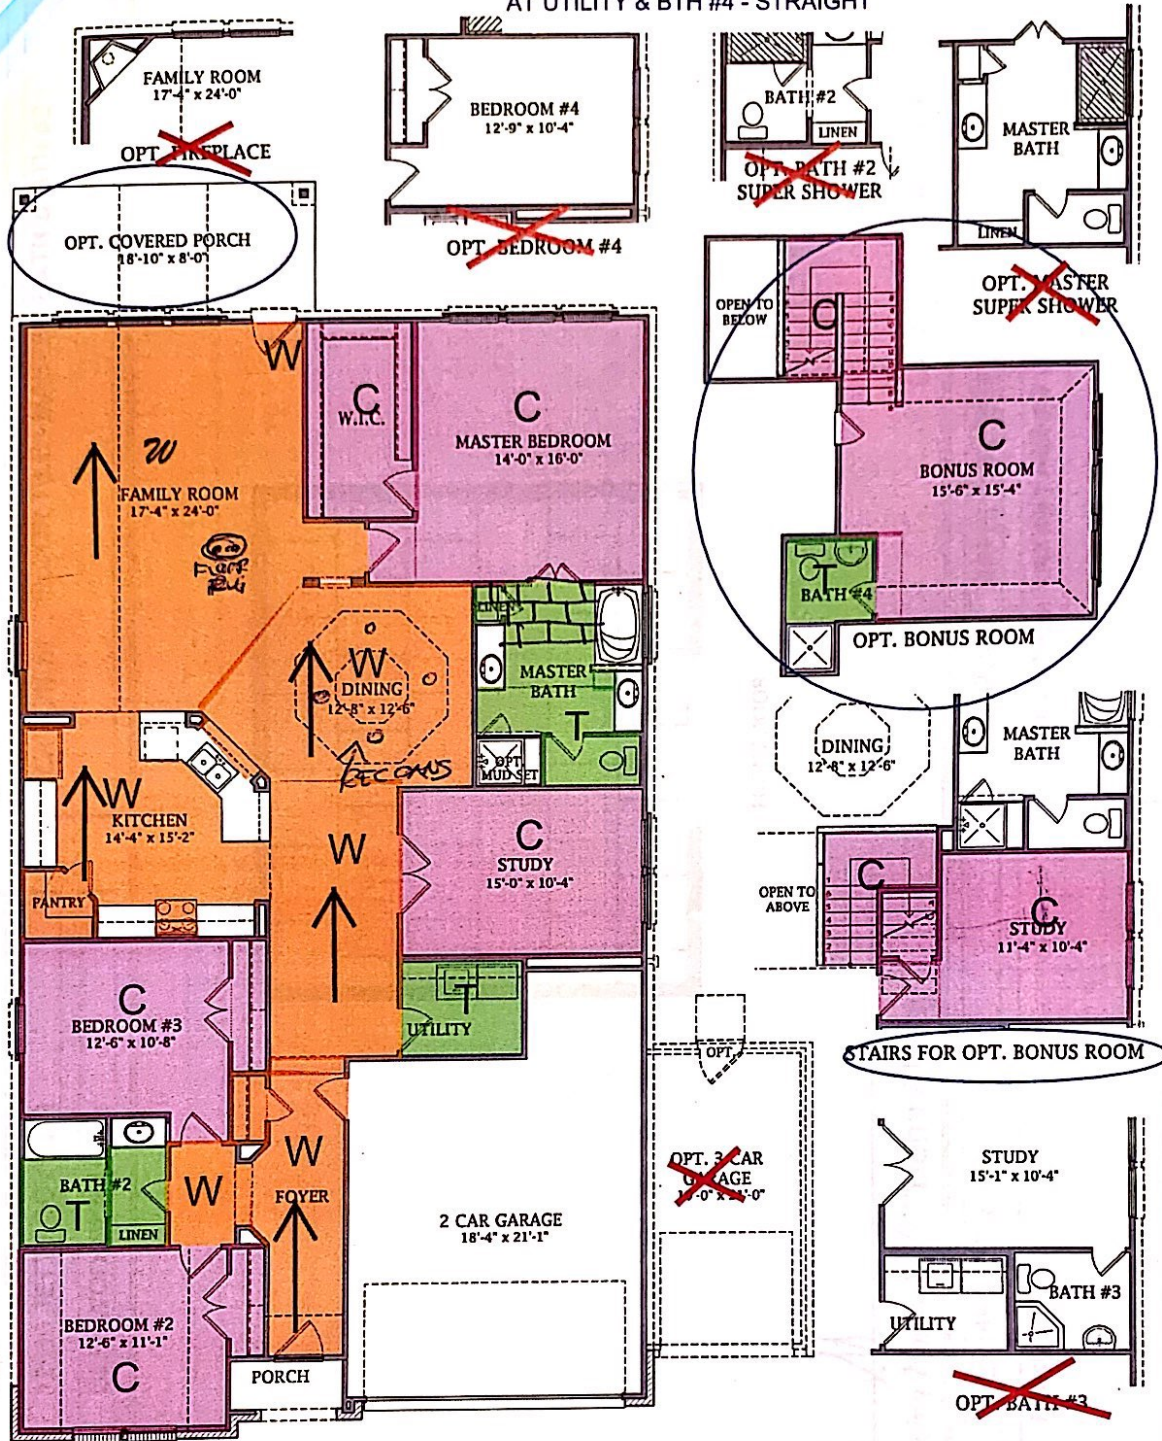

10/17

Elevations are artist renderings and some minor changes may occur after the rendering has been produced. See Sales Consultant for current elevations. Square footage is approximate and may vary per elevation. The designs, as originally designed and prior to any changes you make, are estimated to yield approximately the number of square feet shown. All dimensions are approximate. Square footage may vary based on as-built dimensions, configurations, plan options and/or method of calculation.


12530 Jetty Cove Dr(S) - Slater

PLAN: Glenwood (2264)

FLOOR 1 of 2

LEVEL 3 Security

****CAT6 UPGRADE****

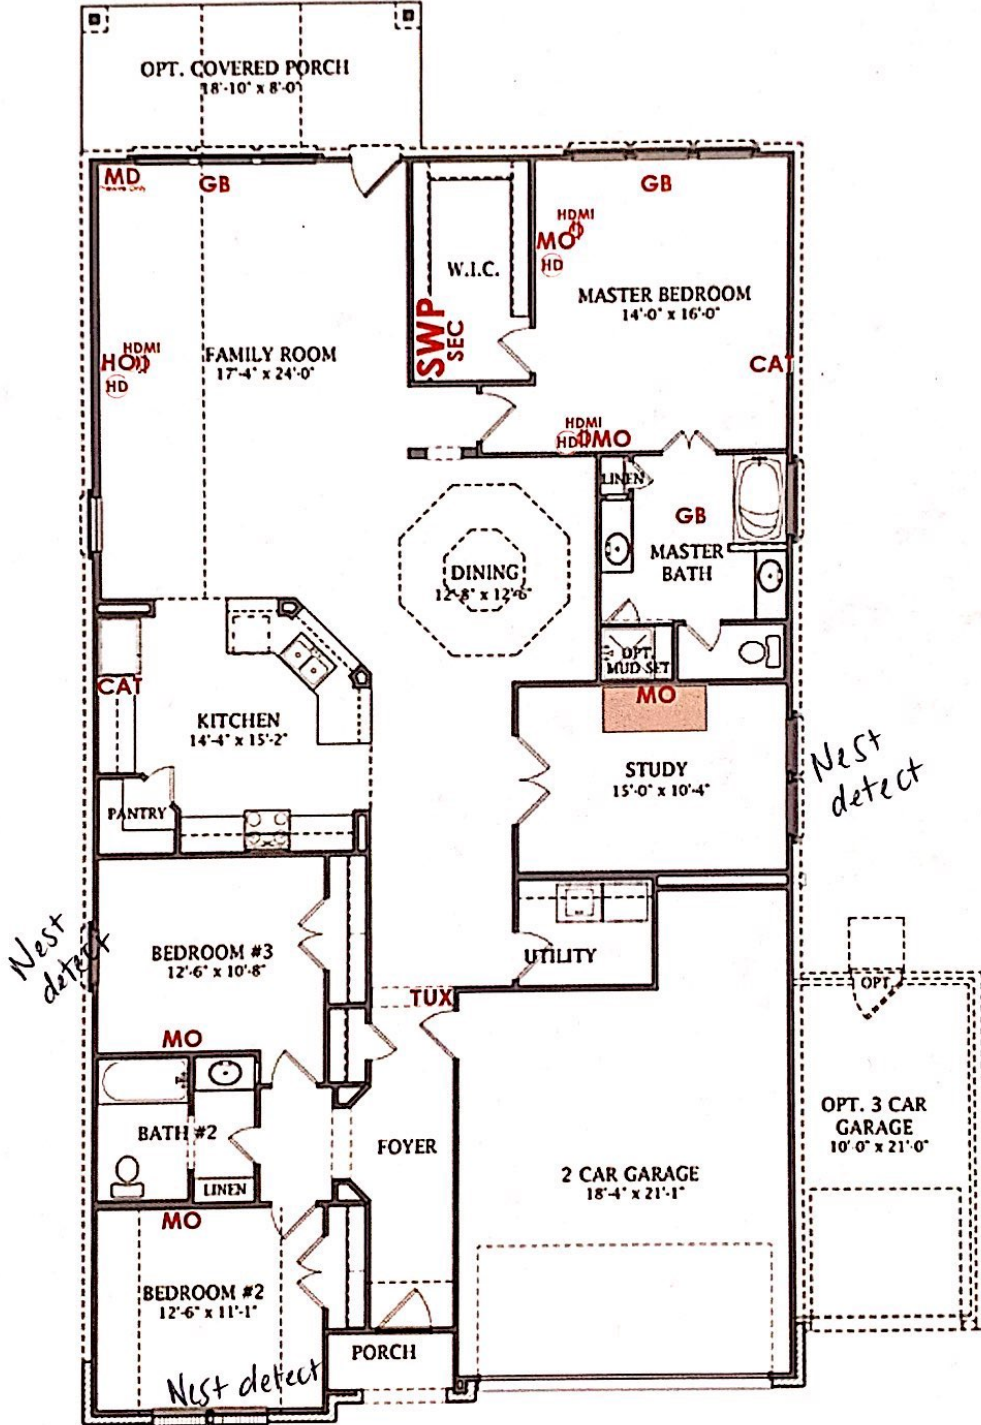

* All markings are PREWIRED ONLY, FINISHED OUT/INSTALLED EQUIPMENT locations will be marked with inverted markings.
EXAMPLES: **CAM** **SP** **SP**

APPROVED
INITIAL: *AS*
DATE: 2/1/18


12530 Jetty Cove Dr(S) - Slater

PLAN: Glenwood (2264)

FLOOR 2 of 2

LEVEL 3 Security

****CAT6 UPGRADE****

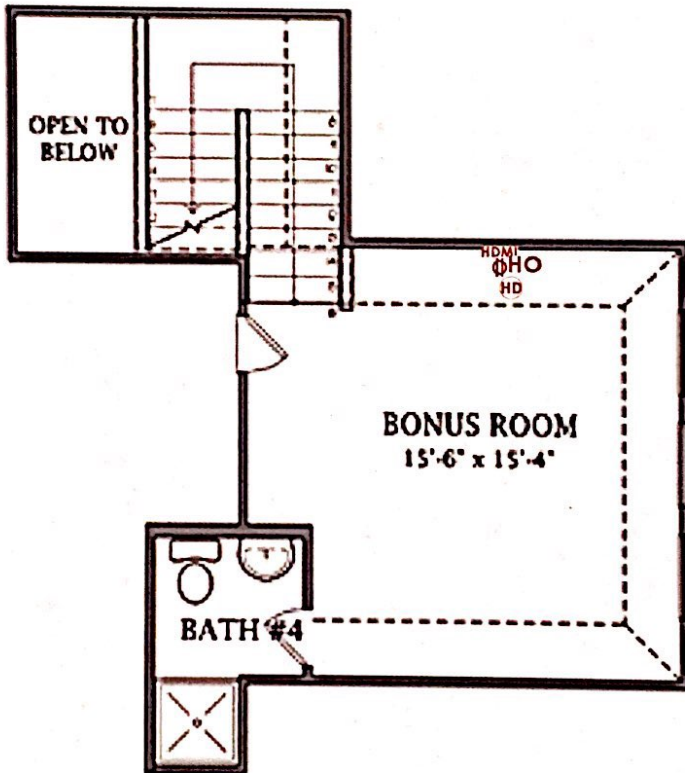

* All markings are PREWIRED ONLY,
FINISHED OUT/INSTALLED EQUIPMENT locations will be
marked with inverted markings.
EXAMPLES: **CAM** **SF** **SP**

APPROVED
INITIAL: *Q JB*
DATE: *2/1/18*