LEGEND . ITEMS THAT MAY APPEAR IN . JULE - MUNICIPAL UTILITY EASIMENT
U.E. - UTILITY EASIMENT
A.E. - ADRAL EASIMENT
D.E. - PRANTARY SEWER EASIMENT
S.S.E. - SANTARY SEWER EASIMENT
STILSE. - STORM SEWER EASIMENT
WILE - WATER LINE EASIMENT

HED FOR, NOT FOUND


(A) CONTROL MONUMENT - - PROPERTY LINE - = EASEMENT LINE - - BUILDING SETBACK LINE

- BUILDING WALL

- WOODEN FENCE - DIAN LINK FENCE - METAL FENCE - WRE FENCE - WHYL FENCE



224 CLEAR LAKE ROAD

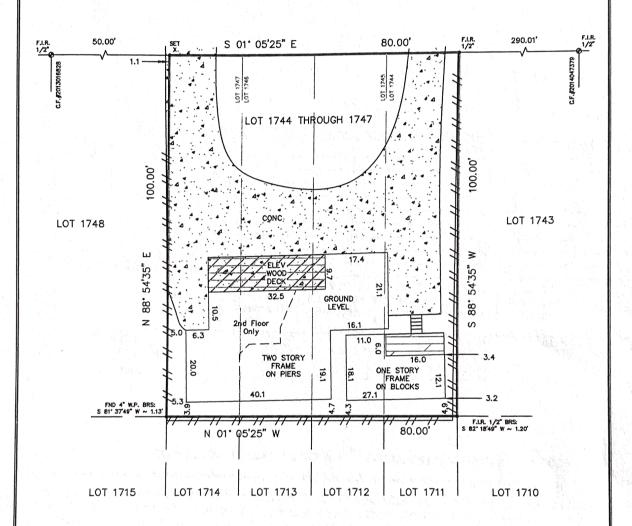

Reviewed & Accepted by:

NOTES:

- BEARING BASIS: PLAT
- SUBJECT TO ANY AND ALL RECORDED AND
UNRECORDED ASSEMBLY:
- SURVEYOR HAS NOT INDEPENDENTLY ABSTRACTED
PROPERTY:
- UNDERGROUND UTILITY
- UNDERGROUND UNITUTY
- UNDERGROUND UNITUTY
- UNDERGROUND UNITUTY
- STRACTICATES, WERE FOR TOO COATED BY THAS SURVEY
STRACTICATES, WERE FOR TOO COATED BY THAS SURVEY
- TRANSACTION ONLY. IT IS NOT THAN THE PROPERTY ONLY THE
- THIS SURVEY WAS COMPLETED WITHOUT THE
BENETIT OF A TITLE REPORT/COAMMITTAIT,
ADDITIONAL BUILDING STERACK LINES, EASEMENTS
OR RIGHTS-OF-WAY MAY APPLY
- SUBJECT TO ZONING AND BUILDING ORDINANCES
- DRYGWAY ENCROACHES OVER NORTH PROPERTY
LINE AS SHOWN

LEGAL DESCRIPTION

LOTS 1744 THROUGH 1747 OF CLEAR LAKE SHORES, A SUBDIVISION IN GALVESTON COUNTY ACCORDING TO THE MAP OR PLAT THEREOF RECORDED IN VOLUME 1, PAGE 57 OF THE MAP OR PLAT RECORDS OF GALVESTON COUNTY, TEXAS.

GAYLYNN SAN MIGUEL

ADDRESS

JOB #

DATE

224 CLEAR LAKE ROAD



GF# N/A

1605200

5-20-16

PRO-SURV

P.O. BOX 1356, FRIENDSWOOD, TX 77549
PHONE: 281-996-1113 FAX: 281-996-0012
EMAIL: order@prosourv.net
T.B.P.L.S. FIRM #10119300
ONLY SURVEY MAPS WITH THE SURVEYOVES GRIGINAL
SORATURE AND GORBORT TIVE AND CORPECT COPIES
OF THE SURVEYOR'S GRIGINAL WORK AND OPINION

© 2016 PRO-SURV - ALL RIGHTS RESERVED

U.S. DEPARTMENT OF HOMELAND SECURITY

ELEVATION CERTIFICATE IMPORTANT: Follow the instructions on pages 1–9.

OMB No. 1660-0008 Expiration Date: July 31, 2015

FEDERAL EMERGENCY MANAGEMENT AGENCY National Flood Insurance Program

	SECTION A – PROPERTY INFORMATION				
A1. Building Owner's Name DAY	1605200			Policy Number:	
A2. Building Street Address (including Apt., Unit, \$ 224 CLEAR LAKE ROAD	Company NAIC Number:				
City CLEAR LAKE SHORES		State TEXA	S	ZIP Code 77565	
A3. Property Description (Lot and Block Numbers, ABST 18 LOTS 1744 THRU 1747 CLEAR LAKE SHOR		egal Description, etc.)			
 A4. Building Use (e.g., Residential, Non-Residential A5. Latitude/Longitude: Lat29*32'55.49"N A6. Attach at least 2 photographs of the building in A7. Building Diagram Number6 A8. For a building with a crawlspace or enclosure(s) 	Long f the Certificate is bein	95°01'57.14"W ng used to obtain flood		Datum: NAD 1927 NAD 198	
a) Square footage of crawlspace or enclosure b) No. of permanent flood openings in the craenclosure(s) within 1.0 foot above adjacent c) Total net area of flood openings in A8.b	(s) 1043 wispace or 7	sq ft a) S b) N w sq in c) To	Square footage of a lumber of permane within 1.0 foot above	ttached garage	
SECTION B	- FLOOD INSURAN	ICE RATE MAP (FIR	M) INFORMATIO	ON THE RESERVE TO THE	
B1. NFIP Community Name & Community Number GALVESTON COUNTY UNINC. 48547	B2.	County Name	GALVESTON	B3. State TEXAS	
		FIRM Panel Effective/ Revised Date 5-2-83	B8. Flood Zone(s	B9. Base Flood Elevation(s) (Zone AO, use base flood depth)	
B11. Indicate elevation datum used for BFE in Item E B12. Is the building located in a Coastal Barrier Reso Designation Date://	urces System (CBRS)	area or Otherwise Prote	☐ Other/Source: cted Area (OPA)?		
SECTION C - B	UILDING ELEVATIO	N INFORMATION (S	URVEY REQUIR	ED)	
*A new Elevation Certificate will be required whe C2. Elevations – Zones A1–A30, AE, AH, A (with BFE) C2.a–h below according to the building diagram	, VE, V1–V30, V (with E specified in Item A7. Ir	BFE), AR, AR/A, AR/AE, A n Puerto Rico only, enter	AR/A1–A30, AR/AH, meters.	Finished Construction , AR/AO. Complete Items	
Benchmark Utilized: TSARP RM NO. 010015 Indicate elevation datum used for the elevations Datum used for building elevations must be the				Other/Source:	
		~ 5		surement used.	
 a) Top of bottom floor (including basement, craw b) Top of the next higher floor 	space, or enclosure in	15 7	⊠ feet ⊠ feet	☐ meters ☐ meters	
c) Bottom of the lowest horizontal structural mer	nber (V Zones only)	N/A . N/A	X feet		
d) Attached garage (top of slab)		7.5	leet	meters	
 e) Lowest elevation of machinery or equipment s (Describe type of equipment and location in Co 		146	⊠ feet	meters	
f) Lowest adjacent (finished) grade next to bulldi	ng (LAG)	7 . <u></u>	🔀 feet	☐ meters	
g) Highest adjacent (finished) grade next to buildh) Lowest adjacent grade at lowest elevation of d		7.3	⊠ feet ⊠ feet	☐ meters ☐ meters	
structural support			· · · · · · · · · · · · · · · · · · ·		
		ER, OR ARCHITECT			
This certification is to be signed and sealed by a land su nformation. I certify that the information on this Certifica understand that any false statement may be punishable	te represents my best e	efforts to interpret the da	ata available.	an a	
☑ Check here if comments are provided on back of form ☐ Check here if attachments.	. Were latitude ar licensed land so	nd longitude in Section Aurveyor? 🛛 Yes	A provided by a] No	TO STEN TO	
Certifier's Name TOBY P COUCHMAN		License Numb	⁵⁵⁶⁵	TOBY P. COUCHMAN	
Title RPLS	Company Name	PRO-SURV		5565	
Address P.O. BOX 1366	City FRIENDSW	OOD State TX	ZIP Code 77549	SURVE	
Signature // / / / / / / / / / / / / / / / / /	Date 05/20/2016	Telephone (28	81) 996-1113		

ELEVATION CERTIFICATE, page 2

IMPORTANT: In these spaces, copy the cor	rresponding information from S	ection A.		I FO	OR INSURANCE COMPANY USE
Building Street Address (including Apt., Unit			lo.	-	olicy Number:
224 CLEAR LAKE ROAD City CLEAR LAKE SHORES	State	ZIP Code	77565	Co	ompany NAIC Number:
				ON (CON	TIME
Copy both sides of this Elevation Certificate	SURVEYOR, ENGINEER, O				
Comments	tor (1) community official, (2) in	surance ageny co	mpany, and (3)	bunuing ow	1101,
THE ELEVATION IN SECTION C2e REFE	ERS TO AN AIR CONDITIONING UNIT (C	ONDENSER)			
Signature Joh P. Carchinea		Date 0	5/20/2016		
SECTION E - BUILDING ELEVATION	ON INFORMATION (SURVE	Y NOT REQUIR	ED) FOR ZON	IE AO AN	D ZONE A (WITHOUT BFE
For Zones AO and A (without BFE), complete For Items E1—E4, use natural grade, if availa E1. Provide elevation information for the foliograde (HAG) and the lowest adjacent grae) Top of bottom floor (including baseme b) Top of bottom floor (including baseme E2. For Building Diagrams 6–9 with permane the next higher floor (elevation C2.b in the E3. Attached garage (top of slab) is E4. Top of platform of machinery and/or equestion E5. Zone AO only: If no flood depth number is ordinance? Yes No Unknown	able. Check the measurement us owing and check the appropriate de (LAG). Int, crawlspace, or enclosure) is ent, crawlspace, or enclosure) is ent flood openings provided in Sene diagrams) of the building is appropriate the servicing the building is	ed. In Puerto Ricc boxes to show wi	oonly, enter met hether the eleva 	ers. Imeters meters meters es 8–9 of meters meters meters meters	ve or below the highest adjacen above or below the HAG above or below the LAG Instructions), above or below the HAG above or below the HAG above or below the HAG
SECTION F -	PROPERTY OWNER (OR OV	VNER'S REPRE	SENTATIVE)	CERTIFIC	ATION
The property owner or owner's authorized rep Zone AO must sign here. The statements in S				ıt a FEMA-i	ssued or community-issued BFE
Property Owner or Owner's Authorized Repres	sentative's Name TOBY P COUC	HMAN			
Address P.O. BOX 1366		City	SWOOD	State TX	ZIP Code 77549
Signature		Date 05/	20/2016	Telephor	ne (281) 996-1113
Comments					
					☐ Check here if attachment
	SECTION G - COMMUNITY	/ INFORMATIO	N (OPTIONAL)	,	
The local official who is authorized by law or or G of this Elevation Certificate. Complete the ap G1. The information in Section C was ta who is authorized by law to certify e G2. A community official completed Sect	rdinance to administer the commu pplicable item(s) and sign below. (lken from other documentation t elevation information. (Indicate th	nity's floodplain m Check the measure hat has been sign ne source and dat	anagement ordin ement used in Ite ned and sealed I te of the elevation	ance can co ms G8–G10 by a license on data in t	 In Puerto Rico only, enter mete ed surveyor, engineer, or archite the Comments area below.)
G3. The following information (Items G4)					ded by Ey of Zone Ao.
34. Permit Number	G5. Date Permit Issued	Ge	6. Date Certificate	e Of Compl	iance/Occupancy Issued
G7. This permit has been issued for:	New Construction	itial Improvement		10 m	
68. Elevation of as-built lowest floor (including					oatum
39. BFE or (in Zone AO) depth of flooding at	the building site:				Patum
G10. Community's design flood elevation:	·			neters D	atum
Local Official's Name		Title			
Community Name		Telephone	·	4.	
Signature		Date			
Comments					1
					☐ Check here if attachments.
					- /