


NOTES

1. Plot Scale: 1" = 30'
2. The bearings for this survey are based on the recorded plat or plats on this survey.
3. Records indicated by recorded plat unless otherwise noted.
4. The plat of survey has been performed with reference upon the construction and observing performed by Fidelity National Title Company under G.L. No. 06-23882 with an effective date of 08/30/06. The surveyor has not observed the subject property.
5. The survey was performed without benefit of a Title Report and therefore may not reflect all existing Set Back Lines, Easements, Deed Restrictions and other matters of record.
6. The professional services reflected on this plat of survey is provided in connection with the transaction contemplated by the file search referenced and should advise it is not to be used for any other purpose. The original work is protected under copyright laws. The U.S. United States Code Sections on said act. All matters will be presented in the Public Record of the law. This survey is being provided solely for the use of the recipient named herein and no access has been granted or expected to copy the survey except or in accordance in connection with the original transaction which shall take place within thirty (30) days from the date shown hereon.

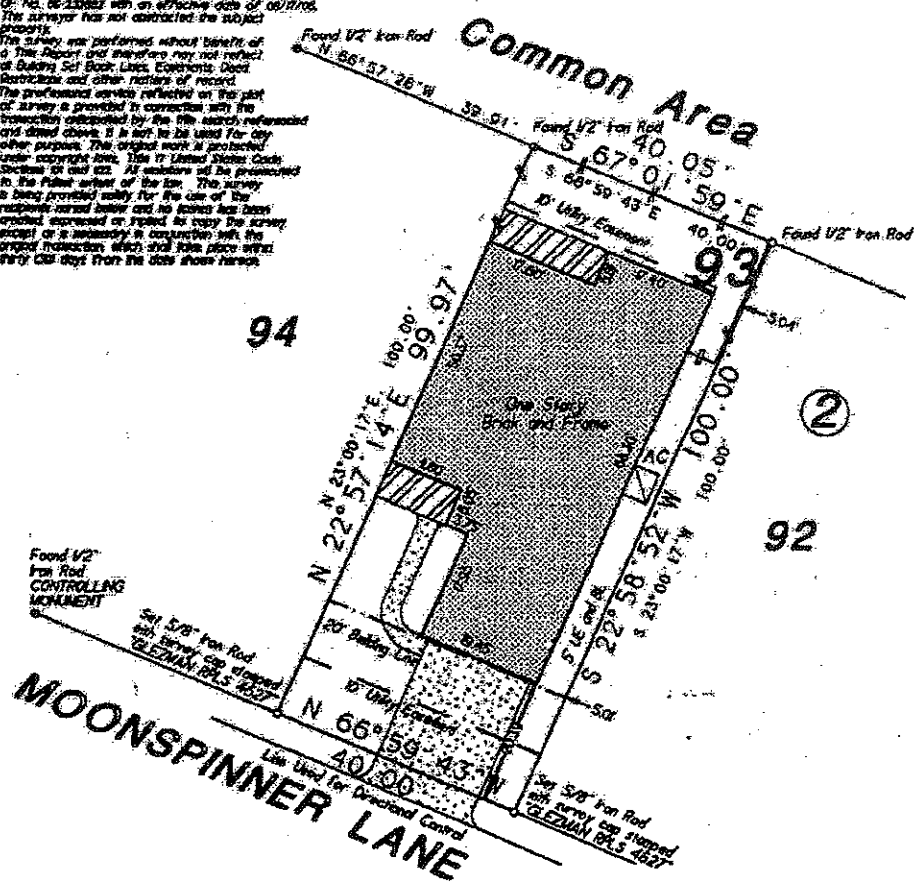

Lot 93, Block 2, of APRIL SOUND, Section 9, a subdivision in Montgomery County, Texas according to the map or plat thereof recorded in Cabinet B, Page 54 of the Map Records of Montgomery County, Texas.

If this plat and accompanying description are not sealed with the raised embossing seal of R.P.L.S. whose signature appears on the raised seal and in red ink, it is considered a copy, and not a legal original. See Note 5 above.

Purchaser: Christopher Munoz
 Address: 108 Moonspinner Lane
 Montgomery, Texas 77356
 GF No.: 06_232882
 Final: August 30, 2006 (pb)
 Site Plan: 03/08/06 (MG)
 Date: February 8, 2006 (pb)
 Job No.: 2006_023

RPLS #4627

In Fidelity National Title Company and USAA

We, Glezman Surveying, Inc., acting by and through Michael Glezman, a Registered Professional Land Surveyor in the State of Texas, hereby certify that this survey and professional service substantially conforms to the Texas Society of Professional Surveyors Standards and Specifications for a Category II, Condition II Survey.

© 2006 All Rights Reserved

Surveying Southern Texas since 1937
GLEZMAN SURVEYING, INC.
 1938 Old River Road
 Montgomery, Texas 77356
 Office (361) 501-6390 www.glezman.com