
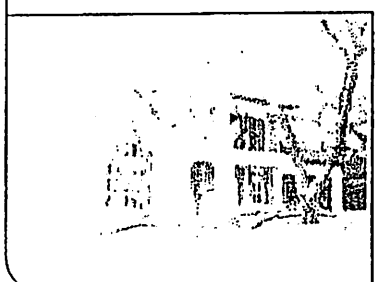


GI NO. 08100731 STEWART TITLE  
 ADDRESS: 6159 PIPING ROCK LANE  
 HOUSTON, TEXAS 77057  
 BORROWER: JOHN S. HANTAK AND  
 KRISTINA M. HANTAK

SCALE: 1" = 30'

# LOT 943, BLOCK 43 BRIARGROVE, SECTION 9

ACCORDING TO THE MAP OR PLAT THEREOF RECORDED  
 IN VOLUME 58, PAGE 62 OF THE MAP RECORDS  
 OF HARRIS COUNTY, TEXAS

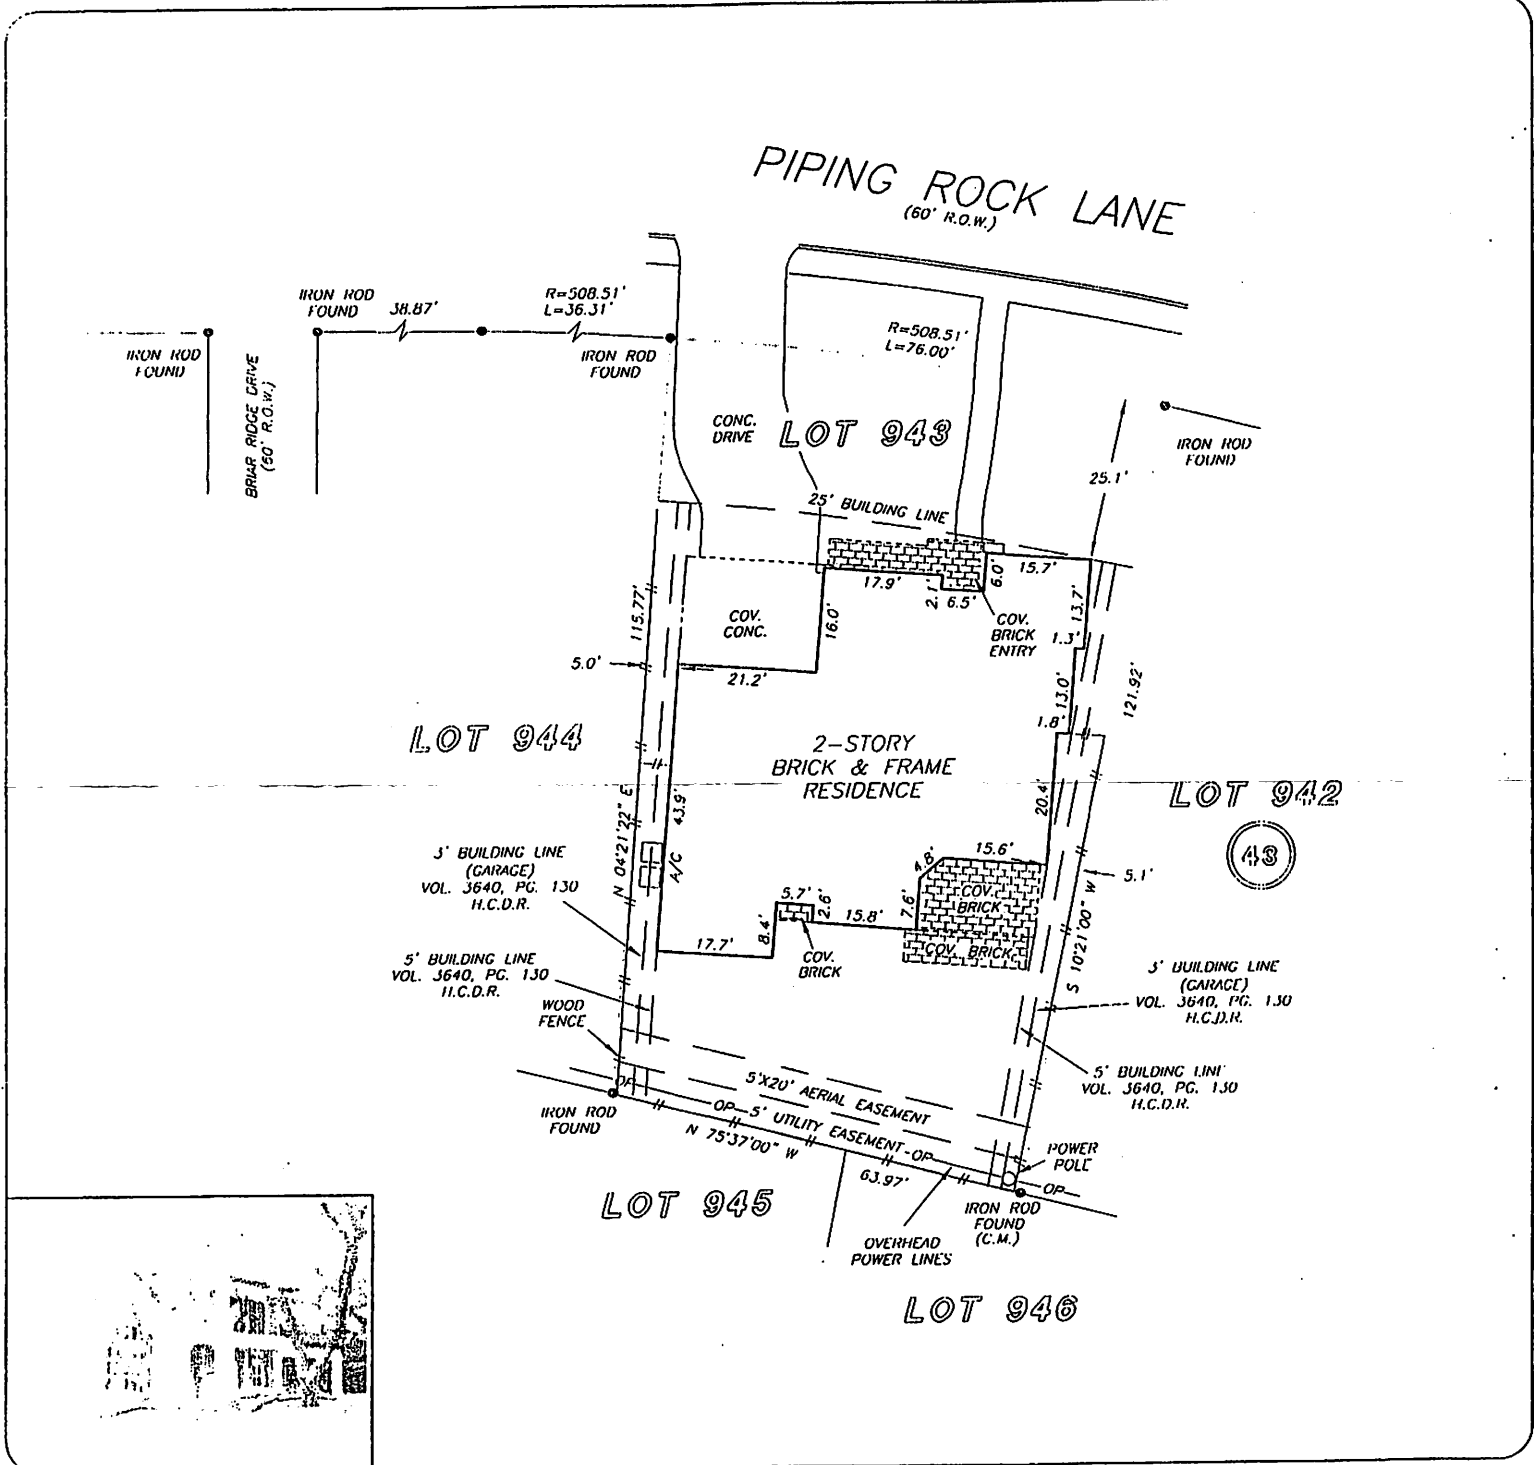

THIS SURVEY DOES NOT LIE WITHIN THE  
 100-YEAR FLOOD PLAIN AS PER FIRM  
 NO. 48201C 0855 I  
 DATE REVISION: 06/18/2007  
 BASED ONLY ON VISUAL EXAMINATION OF MAPS.  
 INACCURACIES OF FEMA MAPS PREVENT EXACT  
 DETERMINATION WITHOUT DETAILED FIELD STUDY


A VISUAL INVESTIGATION  
 WAS BEYOND THE SCOPE OF THIS SURVEY

RECORD DRAWING: VOL. 58, PG. 62 H.C.M.R.


DRAWN BY: JZ/BR/RC/KI

I HEREBY CERTIFY THAT THIS SURVEY WAS MADE  
 ON THE GROUND, THAT THIS PLAT CORRECTLY  
 REPRESENTS THE FACTS FOUND AT THE  
 TIME OF SURVEY AND THAT THERE ARE NO  
 ENCROACHMENTS APPARENT ON THE GROUND,  
 EXCEPT AS SHOWN HEREON. THIS SURVEY IS  
 CERTIFIED FOR THIS TRANSACTION ONLY AND  
 ABSTRACTING PROVIDED IN THE ABOVE  
 REFERENCED TITLE COMMITMENT WAS RIT'ED  
 UPON IN PREPARATION OF THIS SURVEY.

ALLEN D. HUGHES  
 PROFESSIONAL LAND SURVEYOR  
 NO. 3891  
 JOB NO. 08 07172  
 JUNI. 06, 2008

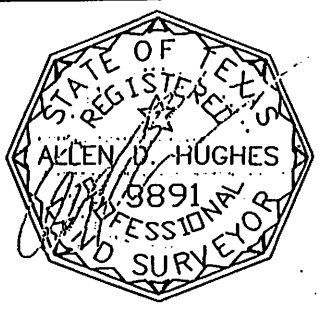

title  
 SONJA MILLER  
 281-275-4438

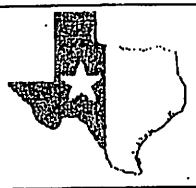

PRECISION SURVEYORS, INC.

1-800 LANDSURVY 281 496 1586  
 1-800 526 3787 FAX 281 496 1867  
 14925 MEMORIAL DRIVE SUITE 11100 HOUSTON, TEXAS 77020