

Meridian



ELEVATION A



ELEVATION B



ELEVATION C



ELEVATION G



ELEVATION H



ELEVATION J

V.6




All information (including, but not limited to prices, views, availability, incentives, floor plans, site plans, features, standards and options, assessments and fees, planned amenities, programs, conceptual artists' renderings and community development plans) deemed reliable as of publication date but not guaranteed and remains subject to change daily or delay without notice. Floor plans and elevations are an artist's conception and are not intended to show specific detailing. As-Built Condition will control. Price(s) shown may not reflect lot premiums, upgrades and options. Lot status "Sold" is an inclusive term that describes the present status of any Contract-submitted, Pending-sale or Closed property. All homes subject to prior sale. Maps and plans are not to scale and all dimensions are approximate. Taylor Morrison received the highest numerical score in the proprietary Life story Research 2016 and 2017 America's Most Trusted® Home Builder study. The 2016 study based on 39,079 new home shoppers from Jan-Dec 2015, and 2017 study based on 31,764 new home shoppers from Jan-Dec 2016 in the United States. Your experiences may vary. Visit [www.lifestorye-search.com](http://www.lifestorye-search.com). Not an offer in any state where prohibited or otherwise restricted by law. Please see a Community Sales Manager and visit [www.taylormorrison.com](http://www.taylormorrison.com) for details. © January 2017, Taylor Morrison of Texas, Inc. All rights reserved.

taylor  
morrison

Homes Inspired by You



# Meridian

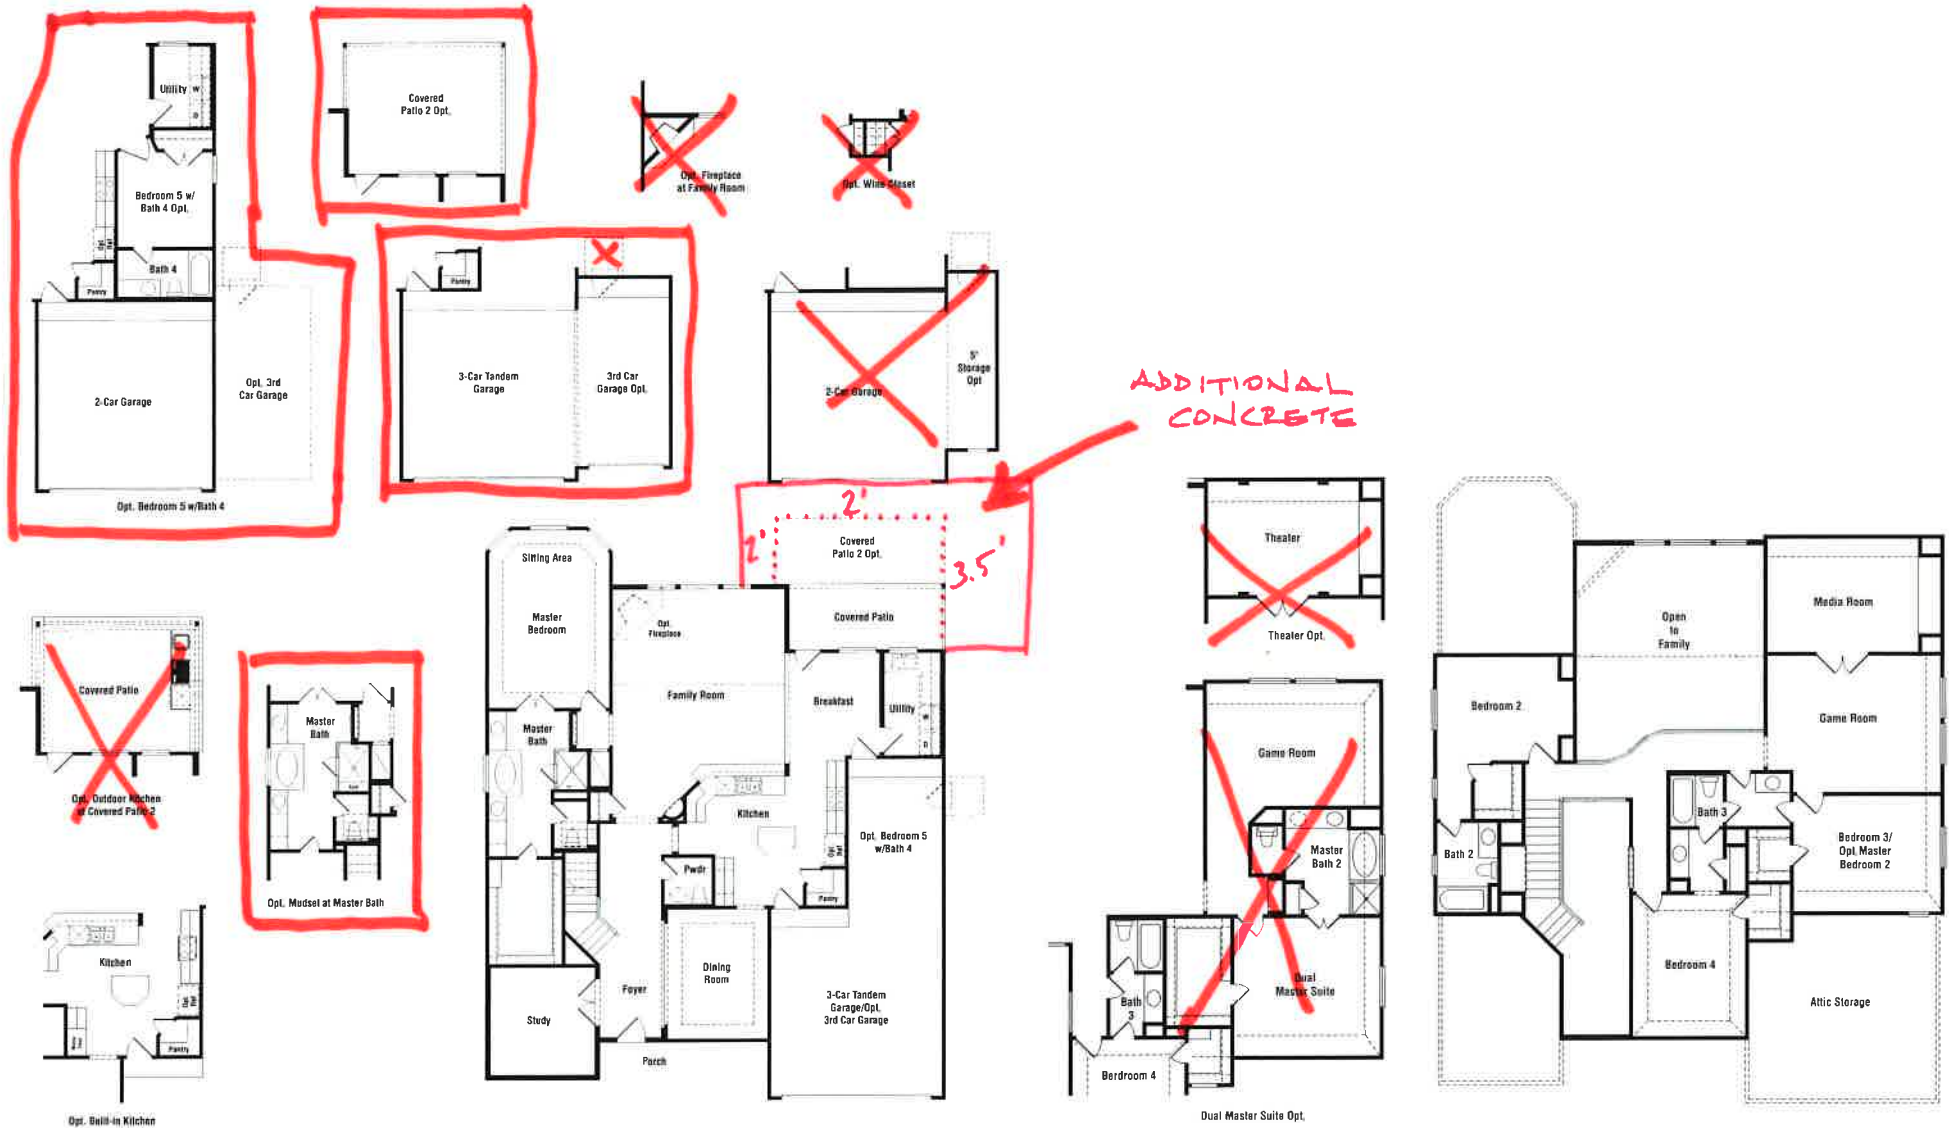

FIRST FLOOR/OPTIONS

SECOND FLOOR/OPTIONS

V.6



All information (including, but not limited to prices, views, availability, incentives, floor plans, site plans, features, standards and options, assessments and fees, planned amenities, programs, conceptual artists' renderings and community development plans) deemed reliable as of publication date but not guaranteed and remains subject to change daily or delay without notice. Floor plans and elevations are an artist's conception and are not intended to show specific detailing. As-Built Condition will control. Prices shown may not reflect lot premiums, upgrades and options. Lot status "Sold" is an inclusive term that describes the present status of any Contract-submitted, Pending-sale or Closed property. All homes subject to prior sale. Maps and plans are not to scale and all dimensions are approximate. Taylor Morrison received the highest numerical score in the proprietary Life story Research 2016 and 2017 America's Most Trusted® Home Builder study. The 2016 study based on 39,079 new home shoppers from Jan-Dec 2015, and 2017 study based on 31,764 new home shoppers from Jan-Dec 2016 in the United States. Your experiences may vary. Visit [www.lifestoryre-search.com](http://www.lifestoryre-search.com). Not an offer in any state where prohibited or otherwise restricted by law. Please see a Community Sales Manager and visit [www.taylormorrison.com](http://www.taylormorrison.com) for details. © January 2017, Taylor Morrison of Texas, Inc. All rights reserved.

[taylormorrison.com](http://taylormorrison.com)