




SCALE : 1" = 30'

# ENTERPRISE STREET

(60' R.O.W. / platted as Golden Street)

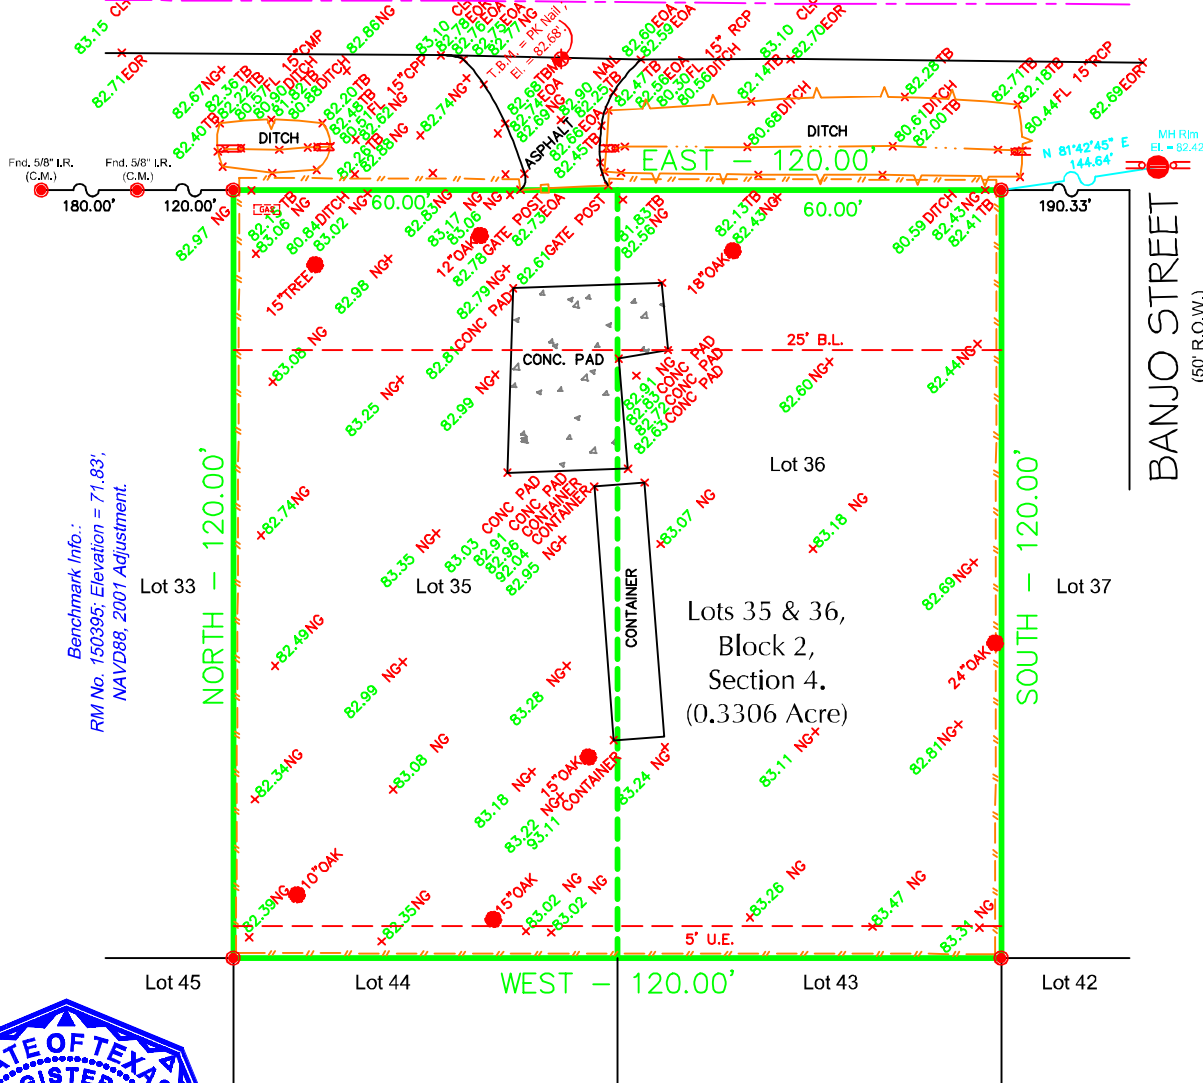

Benchmark Info.:  
 RM No. 160395; Elevation = 71.83';  
 NAVD88, 2001 Adjustment.



### Notes :

- Basis for Bearings: Record plat.
- Distances shown are ground distances.
- All abstracting done by title company.
- All B.L.'s & U.E.'s taken from recorded plat unless otherwise noted.
- Dimension ties from improvements to property lines are calculated and should NOT be relied upon for construction and/or removal of any improvements including fences.
- Building dimensions may not be used to calculate square footage.
- This property subject to any and all recorded and unrecorded easements. Surveyor has made no investigation or independent search for easements of record, encumbrances, restrictive covenants or ownership title evidence.

### LEGEND :

- U.E. = Utility Easement
- D.E. = Drainage Easement
- B.L. = Building Line
- G.E. = Guy Easement
- I.R. = Iron Rod
- I.P. = Iron Pipe
- P.I.P. = Pinch Iron Pipe
- C.M. = Control Monument
- Stm.S.E. = Storm Sewer Easement
- San.S.E. = Sanitary Sewer Easement
- H.C.C.F.No. = Harris County Clerk File Number
- -- = Wood Fence
- o = Chain Link
- x-x = Barbed Wire
- = Wrought Iron

*Barry D. Adkins* 09/01/2021  
 BARRY D. ADKINS, R.P.L.S. No. 6137

This survey is certified for this transaction only, is not transferable to additional institutions or subsequent owners. If this survey does not bear an original BLUE seal it is invalid and should not be relied upon for any purpose.

This property appears to be out of the 100 year flood plain (Zone X); as per insurance rate map 48201C0660 M, dated 06/09/2014.

This determination to be used for flood insurance rate purposes ONLY and is NOT to be relied upon for ANY other purpose. Surveyor makes no representation as to whether property may Flood.

LOTS: 35 & 36	BLOCK: 2	SUBDIVISION: LINCOLN CITY	SECTION: 4
RECORDATION: VOLUME 22, PAGE 43 OF THE MAP RECORDS			COUNTY: HARRIS
ADDRESS: 767 ENTERPRISE STREET	CITY: HOUSTON	STATE: TEXAS	ZIP CODE: 77088

This survey was prepared without the benefit of a title commitment and may not show all building lines, easements or other matters of record.

**DaRam Engineers, Inc.**

11000 Richmond Avenue, Suite 300  
 Houston, Texas. 77042  
 (713) 528-1552 \* Email: Info@daram.com

Survey firm #: 10194492  
 Engineering firm #: F-9503

Field Crew: NB  
 Drafter: NH  
 Project #: S202177088-Enterprise767