

GF. NO. ATCH-26-ATCH22122919E ALAMO TITLE  
 ADDRESS: ALEXANDER LANE  
 PORTER HEIGHTS, TEXAS 77365  
 BORROWER: MINGVA INVESTMENTS LLC

**LOT 32**  
**PORTER HEIGHTS, SECTION 1**  
 A SUBDIVISION SITUATED IN THE WYATT ANDERSON SURVEY  
 A-53 IN MONTGOMERY COUNTY, TEXAS AS IMPOSED  
 BY THE MAP AND DEDICATION THEREOF RECORDED IN  
 VOLUME 5, PAGE 339 OF THE MAP RECORDS  
 OF MONTGOMERY COUNTY, TEXAS

NOTE: MAY BE SUBJECT TO DEED RESTRICTIONS AND/OR  
 ADDITIONAL GOVERNMENTAL BUILDING REQUIREMENTS.




THIS PROPERTY DOES NOT LIE WITHIN THE  
 100 YEAR FLOOD PLAIN AS PER FIRM  
 MAP REVISION: 08/18/2014  
 ZONE X  
 BASED ONLY ON VISUAL EXAMINATION OF MAPS.  
 DETERMINATION WITHOUT DETAILED FIELD STUDY.  
 A SURFACE INVESTIGATION  
 WAS BEYOND THE SCOPE OF THIS SURVEY

D.C.L. = DIRECTIONAL CONTROL LINE  
 RECORD DRAWING VOL. 5, Pgs. 338, 340, 341, 342, 999, 1000


DRAWN BY: RC

1 HEREBY CERTIFY THAT THIS SURVEY WAS MADE  
 ON THE GROUND THAT THIS PLAT CORRECTLY  
 REPRESENTS THE ACTUAL SITUATION AT THE  
 TIME OF SURVEY AND THAT THERE ARE NO  
 ENCUMBRANCES APPARENT ON THE GROUND  
 EXCEPT AS SHOWN HEREON. THIS SURVEY IS  
 BASED ON THE ASSUMPTION THAT THE  
 INSTRUMENTS PROVIDED IN THE ABOVE  
 REFERENCED TITLE COMMITMENT WAS RELIED  
 UPON IN PREPARATION OF THIS SURVEY.

RICHARD S. WILLET  
 PROFESSIONAL LAND SURVEYOR  
 NO. 14012  
 EXPIRES 02-09-2021  
 SEPTEMBER 19, 2020

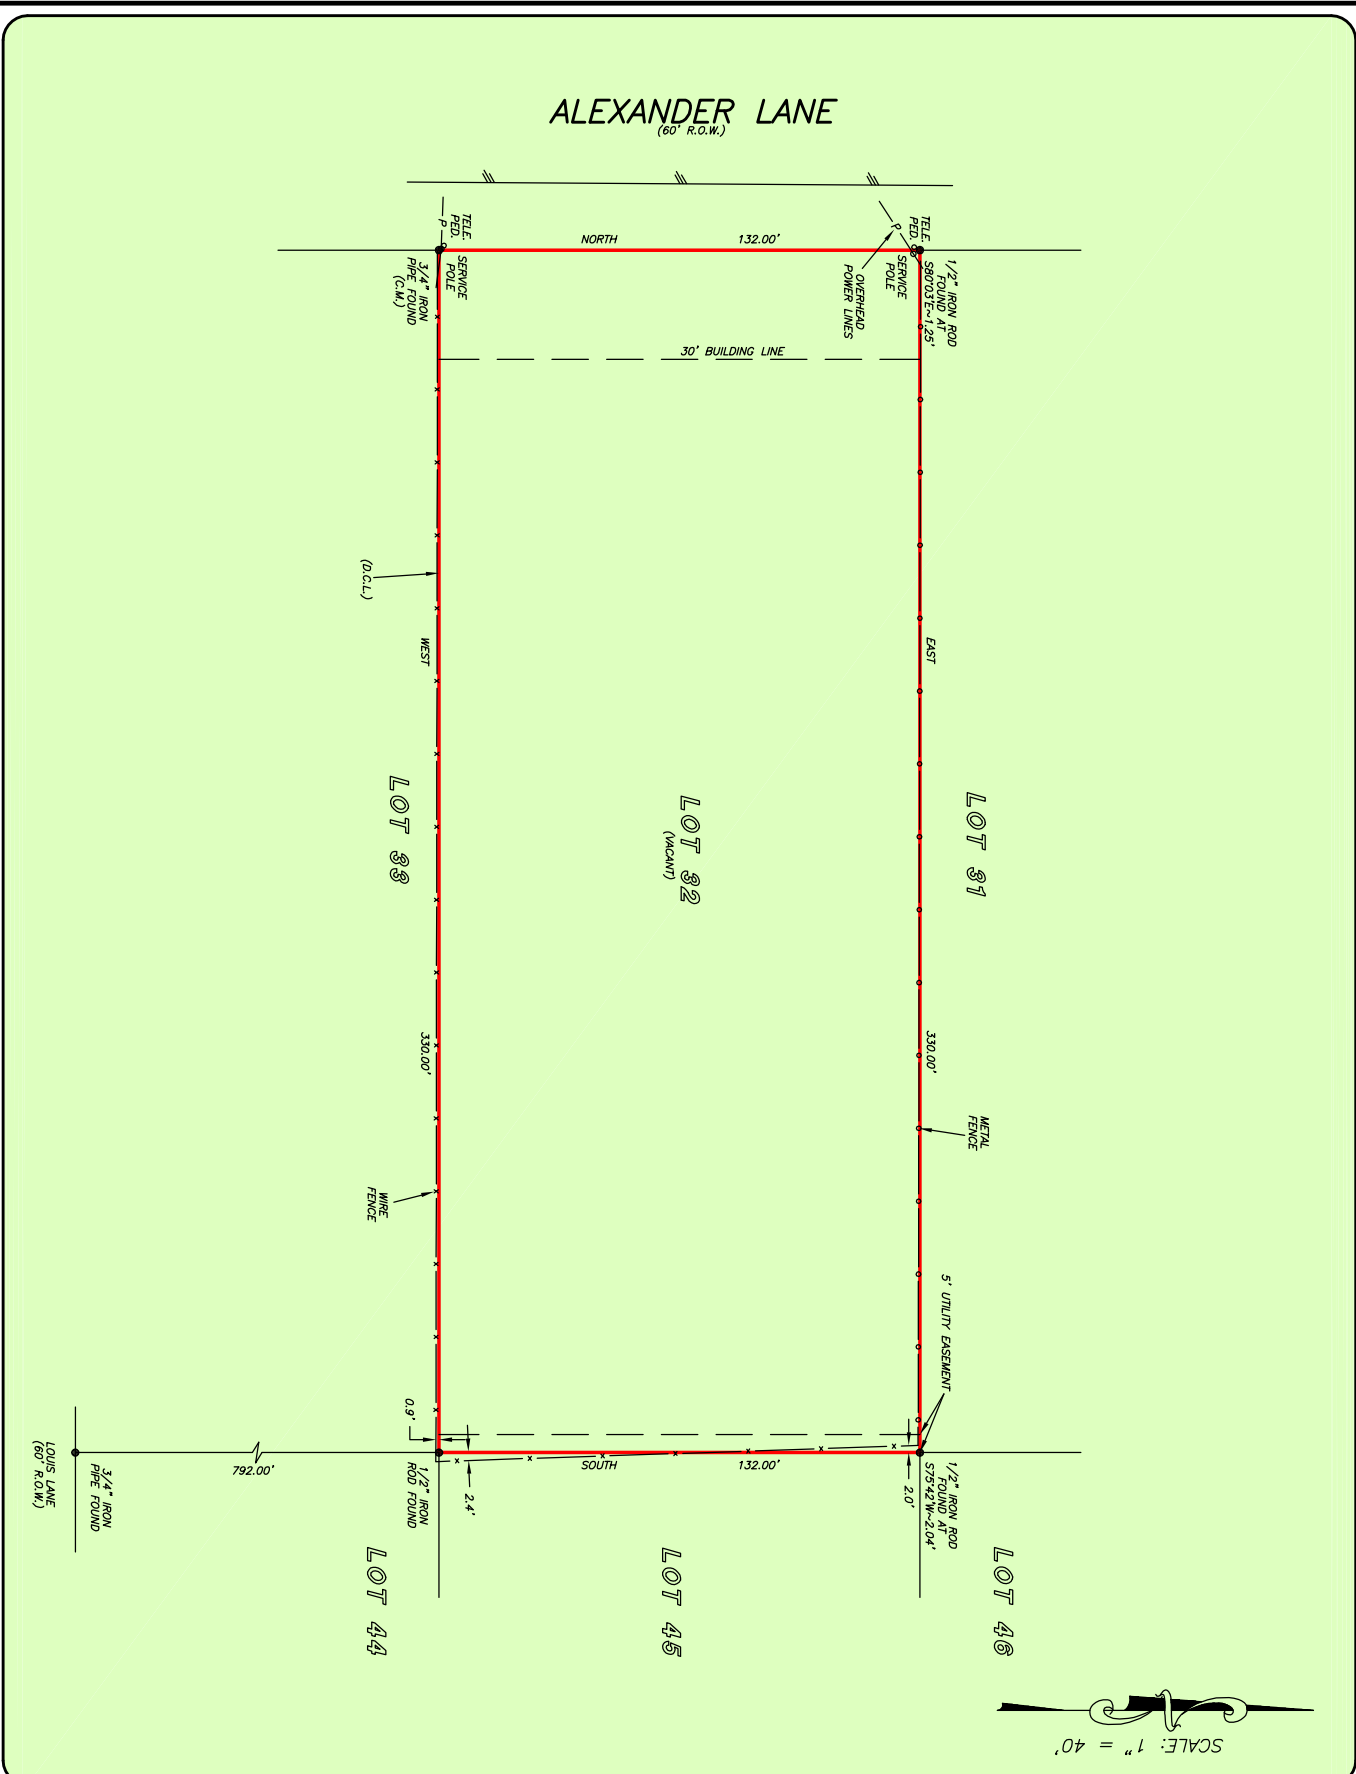

SCALE: 1" = 40'

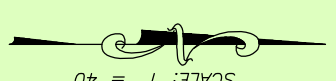

Alamo Title  
 Company  
**VICKY BOU**  
 281-379-6060



**PRECISION**  
 surveyors

281-496-1586  
 950 THEBONNETTE STREET SUITE 150 HOUSTON, TEXAS 77079  
 1-800-LANDSURVEY  
 www.precisionsurveyors.com  
 281-281-1867  
 1777 NE LOOP 410 SUITE 600 SAN ANTONIO, TEXAS 78217  
 210-829-4941  
 210-829-1555