

# **G A Brooks** ENGINEERING LLC

**Greg A. Brooks, P.E.**  
PO Box 2373  
Freeport, TX 77542

March 29, 2023  
979-229-0068

## **PRELIMINARY FOUNDATION INSPECTION REPORT: JOB NO. 23-LJ083**

**LOCATION:** 159 Corkwood  
Lake Jackson, TX

**DATE OF  
INSPECTION:** March 23, 2023

### **OBSERVATIONS:**

This house consists of a single-story brick veneer wood frame structure constructed on a conventional slab foundation. Refer to this write-up and the attached drawing concerning the current state of the foundation and the perimeter foundation stabilization plan.

### **CONCLUSIONS:**

The entire perimeter of the structure shows settlement, with the front, left and right perimeter showing significant foundation movement. The interior of the structure shows over 8" of settlement when comparing the back perimeter to the front perimeter. Exterior deficiencies show multiple brick veneer cracks throughout and multiple windows show significant separation from the brick veneer. See the attached drawing showing deficiency locations in more detail. The interior of the structure shows significant floor slope with sheetrock cracks in the ceilings, above door frames and adjacent to windows. Door misalignment is present throughout the interior of the structure. The foundation movement is due to seasonal moisture changes in the expansive clay soil over the life of the structure. I recommend that pressed piles be installed as shown in the attached drawing both to stabilize the foundation and to aid the house in bearing in a soil zone of constant moisture and firmer stratum of soil.

### **RECOMMENDATIONS:**

I recommend the installation of 47 perimeter and 20 interior pressed piles. The intent of the repair plan is to stabilize the settlement and adjust as necessary to correct door frame misalignment while minimizing cosmetic deficiencies. Due to the amount of settlement, the likelihood that floor slope still exist after the repair is high. Pile locations should be added as noted on the attached drawing. All work should be in accordance with the details and specifications as shown. These repairs should stabilize this part of the foundation for the remaining life of the house. The engineer will not assume any liability for any cracks created during leveling or for any new cracks or damage to the structure which may appear during the leveling procedure. Please note that I shall not control or have charge of, and shall not be responsible for, construction means, methods, techniques, sequences, procedure of repair, health or safety programs or precautions contained with the work and shall not manage, supervise, control, or oversee construction. Further, I shall not be responsible for the acts or omissions of the contractor or other parties on the project. I have provided the service in a professional manner that meets generally accepted practices in residential construction. My entire warranty and liability will be limited to the payment received for my work performed.

Respectfully submitted,



Greg A. Brooks, P.E. #114197  
F-15269

3-29-2023




### Exterior Deficiencies

FR-Sep – Friez Board Separation  
 DS – Door Separation  
 WS – Window Separation  
 HC – Horizontal Crack in Brick  
 DC – Diagonal Crack in Brick  
 BMC – Grade Beam Crack

Slope Readings shown in Red

■ Proposed Pressed Piles

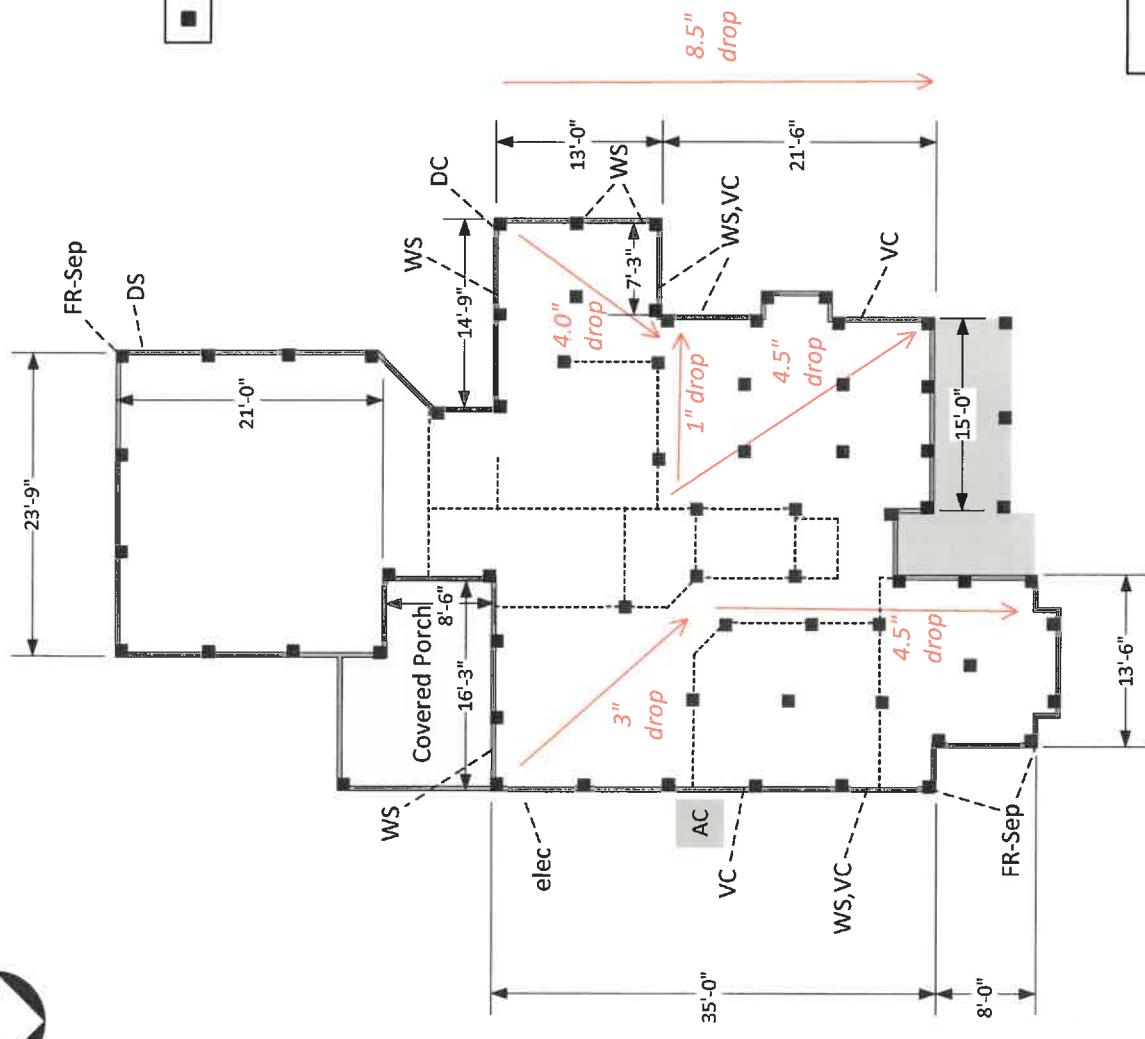

*G.A. Brooks*  
3/28/2023


**G A Brooks ENGINEERING, LLC**

Proposed Foundation Repair  
159 Corkwood  
Lake Jackson, TX

Firm Reg. # F-15269  
This document is the property of G A Brooks Engineering LLC, and the information contained within is confidential and privileged. It may not be copied or distributed without written consent from G A Brooks Engineering LLC.

PO Box 2373 Freeport, TX 77542 gregbrookspe@yahoo.com (979)229-0068	SIZE L	JOB NO 23-LJ083-01	DWG NO 0	REV 0
1in = 15ft. 0in.	SCALE 1in = 15ft.		SHEET 1 of 3	



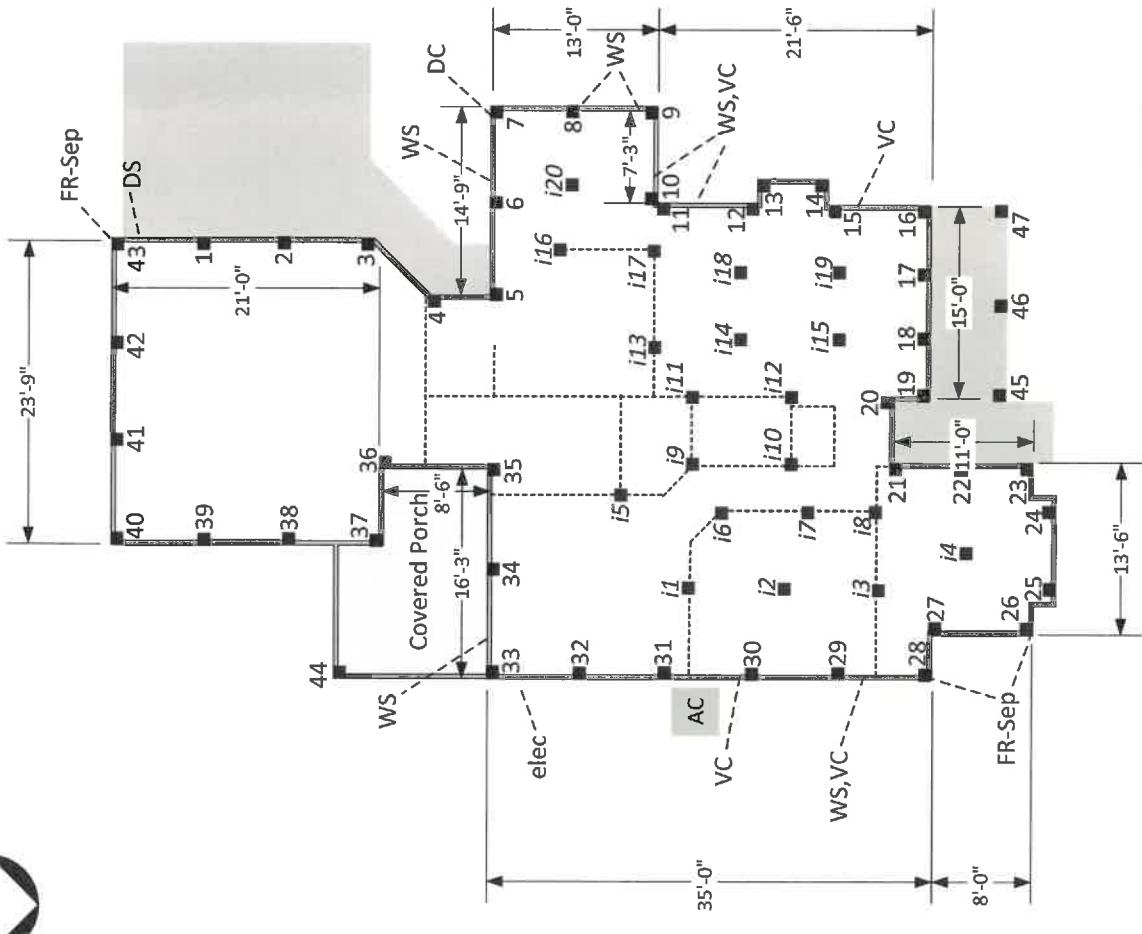

## Proposed Pile Placement

- Piles 1-3 placed on 6'-8" centers
- Piles 3-5,7,9-16, placed at respective corner
- Piles 6,8,22 placed at center of respective wall
- Piles 16-19 placed on 4'-8" centers
- Piles 20,21,23, 26-28 placed at respective corner
- Piles 24-25 placed on 6'-0" centers
- Piles 28-33 placed on 6'-10" centers
- Piles 33-35 placed on 7'-9" centers
- Piles 35-36 placed on 8'-0" centers
- Piles 37-40 placed on 6'-8" centers
- Piles 40-43 placed on 7'-7" centers
- 20 Interior Piles placed at respective location as shown on the drawing. Adjustments should be made once interior grade beams are found

## Exterior Deficiencies

**FR**Sep – Friez Board Separation  
**DS** – Door Separation  
**WS** – Window Separation  
**HC** – Horizontal Crack in Brick  
**DC** – Diagonal Crack in Brick  
**BMC** – Grade Beam Crack

## ■ Proposed Pressed Piles

**G.A. Brooks ENGINEERING** INC.


Proposed Foundation Repair  
159 Corkwood  
Lake Jackson, TX

PO Box 2373 Freeport, TX 77542  <a href="mailto:gregbrookspe@yahoo.com">(979)229-0068</a>	<table border="1" style="width: 100%; border-collapse: collapse;"> <tr> <td style="width: 25%;">SIZE</td><td style="width: 25%;">JOB NO</td><td style="width: 25%;">DWG NO</td><td style="width: 25%;">REV</td></tr> <tr> <td>L</td><td></td><td><b>23-LJ083-02</b></td><td>0</td></tr> <tr> <td>SCALE</td><td>1in = 15ft.</td><td>Qin.</td><td>SHEET</td></tr> </table>	SIZE	JOB NO	DWG NO	REV	L		<b>23-LJ083-02</b>	0	SCALE	1in = 15ft.	Qin.	SHEET
SIZE	JOB NO	DWG NO	REV										
L		<b>23-LJ083-02</b>	0										
SCALE	1in = 15ft.	Qin.	SHEET										
			2 of 3										




 3/28/2023

0 ft. 9 ft. 15 ft. 30 ft.

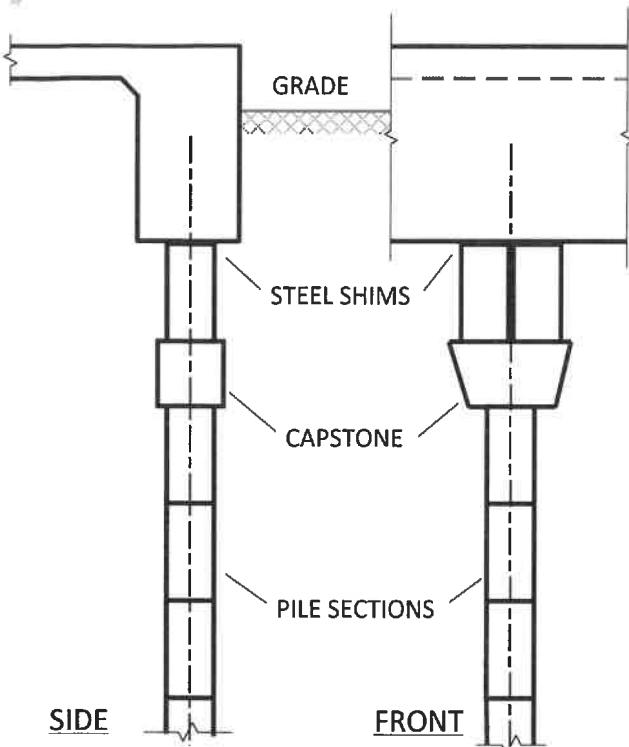

SLABS WITH GRADE BEAM

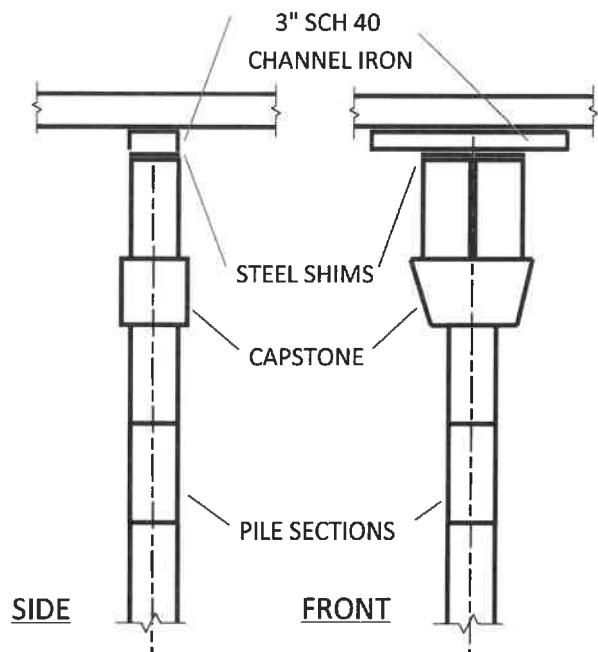

SLABS WITH NO GRADE BEAM

NOTES:

1. Piles shall be placed at a maximum of 8'-0" in single story areas, 6' 0" in two story areas.
2. Pile sections shall consist of 6" diameter x 12" long cylinders. Square or rectangular blocks will not be permitted for use as pile sections.
3. Pile sections shall be installed by jack or hydraulic ram using the weight of the structure to provide the driving load.
4. Piles shall be driven until the foundation starts to lift or the driving load exceeds 6,500 psig
5. Elevate foundation on hydraulic jacks, hold in place with steel shims placed on top of 6" diameter cylinders placed on top of a rectangular solid 6"x6"x12" concrete capstone
6. Contractor to verify underground obstructions, and obtain required permits before beginning job.
7. After leveling, fill voids created, backfill holes and replant where applicable



3/28/2023

Firm Reg. # F-15269  
This document is the property of  
G A Brooks Engineering LLC, and  
the information contained within is  
confidential and privileged. It may  
not be copied or distributed  
without written consent from  
G A Brooks Engineering LLC.

PO Box 2373  
Freeport, TX 77542  
gregbrookspe@yahoo.com  
(979)229-0068

**G A Brooks** ENGINEERING LLC

Proposed Foundation Repair

159 Corkwood  
Lake Jackson, TX

DWG NO  
**23-LJ083-03**

REV  
0

SCALE	1in = 15ft. 0in.	SHEET	3 of 3
-------	---------------------	-------	--------