


- NOTES:
1. Plat Scale: 1" = 20'
 2. Bore of Bearings: Recorded Plat
 3. Roads dedicated by recorded plat unless otherwise noted
 4. Record data as shown was relied on in part from Comptroller for Title Insurance as issued by Chicago Title Company
OF No. 000440602 Dated October 13, 2006
 5. Gulf States Utility Easement recorded in CF# 8929629, 8929630, 8709575 & 9156485
 6. All elevations referenced to water level recorded by SAN JACINTO RIVER AUTHORITY Elev. + 20122.06 of November 8, 2006.
 7. The professional services reflected on this plat of survey is provided in connection with the transaction contemplated by the title search referenced and dated above. It is not to be used for any other purposes. This original work is protected under copyright laws. Title 17 United States Code Sections 101 and 102. All violators will be prosecuted to the fullest extent of the law. The survey is being provided solely for the use of the recipient's name below and no license has been created, expressed or implied to copy the survey except as is necessary in conjunction with the original transaction, which shall take place within thirty (30) days from the date shown hereon.

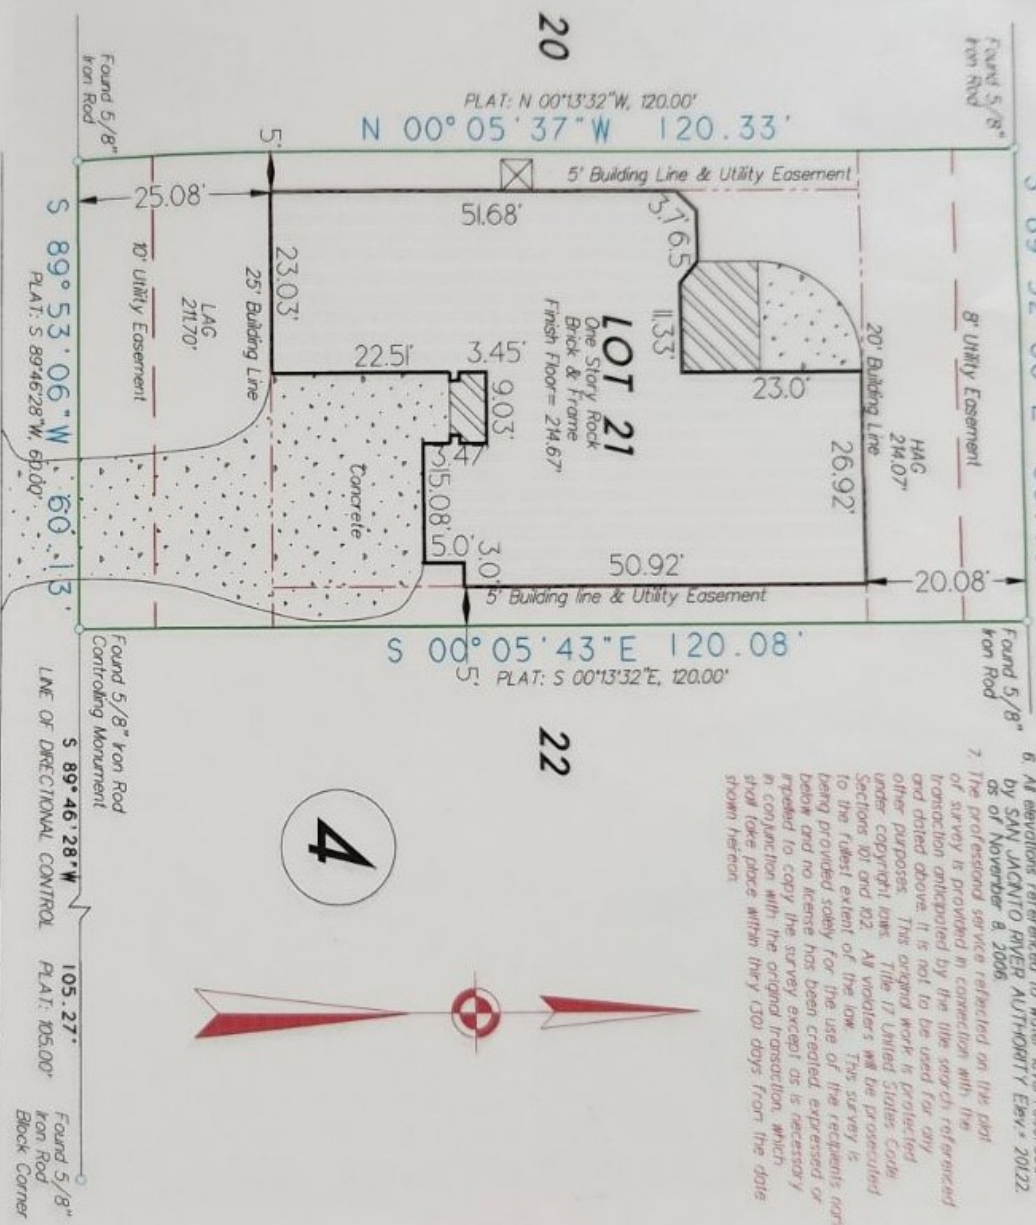

Lot Twenty-One (21), in Block Four (4), of BENTWATER, SECTION SIX (6), a subdivision in Montgomery County, Texas, according to the map or plat thereof recorded in Cabinet F, Sheets 16A and 17A of the Map Records of Montgomery County, Texas.

If this plat and accompanying description are not sealed with the raised embossing seal of R.P.L.S. whose signature appears on the raised seal and in red ink, it is considered a copy, and not a legal original. See Note 6 Above.

Purchaser: Patrick and Suzanne Horsley
 Address: 63 Waterford Way
 Montgomery, Texas 77356

Revision: November 9, 2006
 Final: November 1, 2006
 Form: March 31, 2006
 Date: May 25, 2005

GF No. 000440602
 Job No. 05-135

Chicago Title Co.
 The G & G Surveying, acting by and through Michael Deanna, a Registered Professional Land Surveyor in the State of Texas, hereby certifies that the survey and professional service substantially conforms to the Texas Society of Professional Surveyors Standards and Specifications for a Category M, Condition III Survey.
 This document is the property of G&G Surveying. G&G Surveying accepts no responsibility for the content of an authorized agent of G&G Surveying. G&G Surveying accepts no responsibility for the use of this drawing for any purpose after its creation from the data indicated on the drawing. All rights reserved.
 Copyright 2006, G & G Surveying

G & G SURVEYING
 1938 OLD RIVER ROAD
 MONTGOMERY, TEXAS 77356
 OFFICE: (936) 582-6844 FAX: (936) 582-6845

G & G Surveying

