
Survey of 1.63 Acres (70,955 Sq. Ft.), lying and situated in the T. TOBY SURVEY, A-462, the same land described in Volume 560, Page 494 as recorded in the Real Public Records of Grimes County, Texas (R.P.R.G.C.T.)

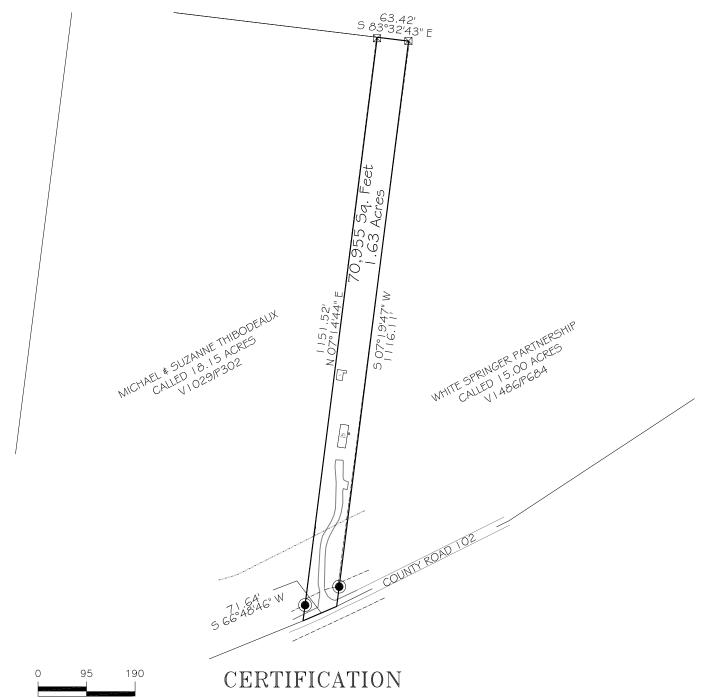

Basis of Bearings for this Survey is **Grid North from GPS Observation TEXAS CENTRAL 4203 NAD83** 

I, XAVIER SANDOVAL, REGISTERED PROFESSIONAL LAND SURVEYOR OF TEXAS, DO HEREBY CERTIFY THAT THIS PLAT REPRESENTS AN ON THE GROUND SURVEY, PERFORMED UNDER MY SUPERVISION THIS THE 3RD DAY OF JUNE, 2022

## Site Address: **TBD CR 102** North Zulch, TX 77872

LEGEND <del>X</del> = Fence <del>G</del> = Gas Line

MB = Mail Box 🔘 = Sewer Cleanout

www = Water Meter

T = Telephone Pedestal• = Bollard

--= Utility Easement R.O.W.

-SB-= Building Setback
U&E= Utilities & Easements

OHP = Overhead Pwr. Ln.

<del>T</del>= Buried Telephone Line

(P) = Plat

(M)= Measured

(M&R)= Measured and Record ● = Find 1/2" Iron Rod ⊠ = Set. 1/2" Iron Rod

= Fnd 5/8" Iron Rod

PAGE 1 OF 1



Xavier D. Sandoval, R.P.L.S. NO. 5886 DATE: 06.03.2022

TEXAS REGISTERED PROFESSIONAL LAND SURVEYOR

## **CURRENT LISTED OWNER: MICHAEL & HEATHER JORDAN PO BOX 400 CUSHING, TX** 75760

SCALE:1"=190' DRAWING NO: 2021-161 DRAWN BY: TCC CHECKED BY: XDS SURVEYED BY: C.MCKINLEY

TBPELS FIRM NO.: 10194595





Campbell Land Services 100 West Main St. Madisonville, TX 77864 Office: 936.241.5020 Land Surveyors & Right of Way Professionals www.clslandservices.com