

SYMBOLS LEGEND

○ IRON ROD FOUND



ABBREVIATIONS LEGEND NOTES:

A ABSTRACT
 B.L. BUILDING LINE
 G.B.L. GARAGE BUILDING LINE
 F.C. FILM CODE
 FND FOUND
 H.C.D.R. HARRIS COUNTY DEED RECORDS
 H.C.M.R. HARRIS COUNTY MAP RECORDS
 I.R. IRON ROD
 R.O.W. RIGHT OF WAY
 VOL. VOLUME
 PG. PAGE

1. This survey was prepared without the benefit of a title commitment; no additional research regarding the existence of easements or restrictions of record has been performed by DVJ Land Surveying.

2. This tract lies in Zone "X" determined to be outside of the 0.2% annual chance floodplain, as per the National Flood Insurance Program FIRM Map Panel Number 48201C0880M, effective date: January 6, 2017.

3. Bearings shown hereon are based on the Calhoun Paris Homes subdivision of record in Film Code No. 699107, H.C.M.R.

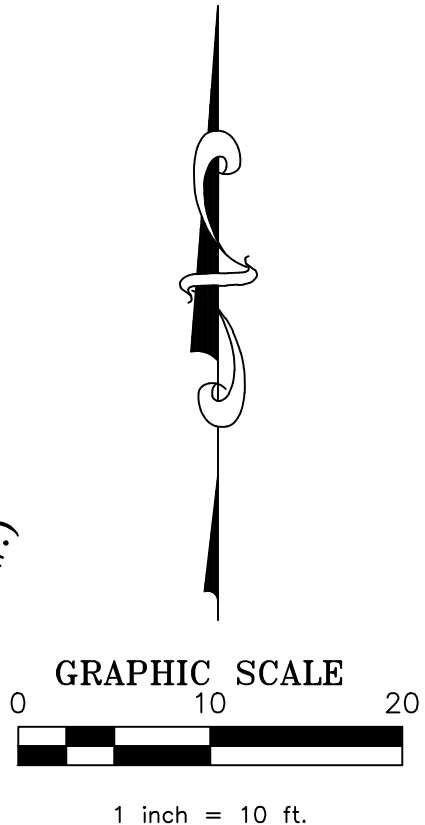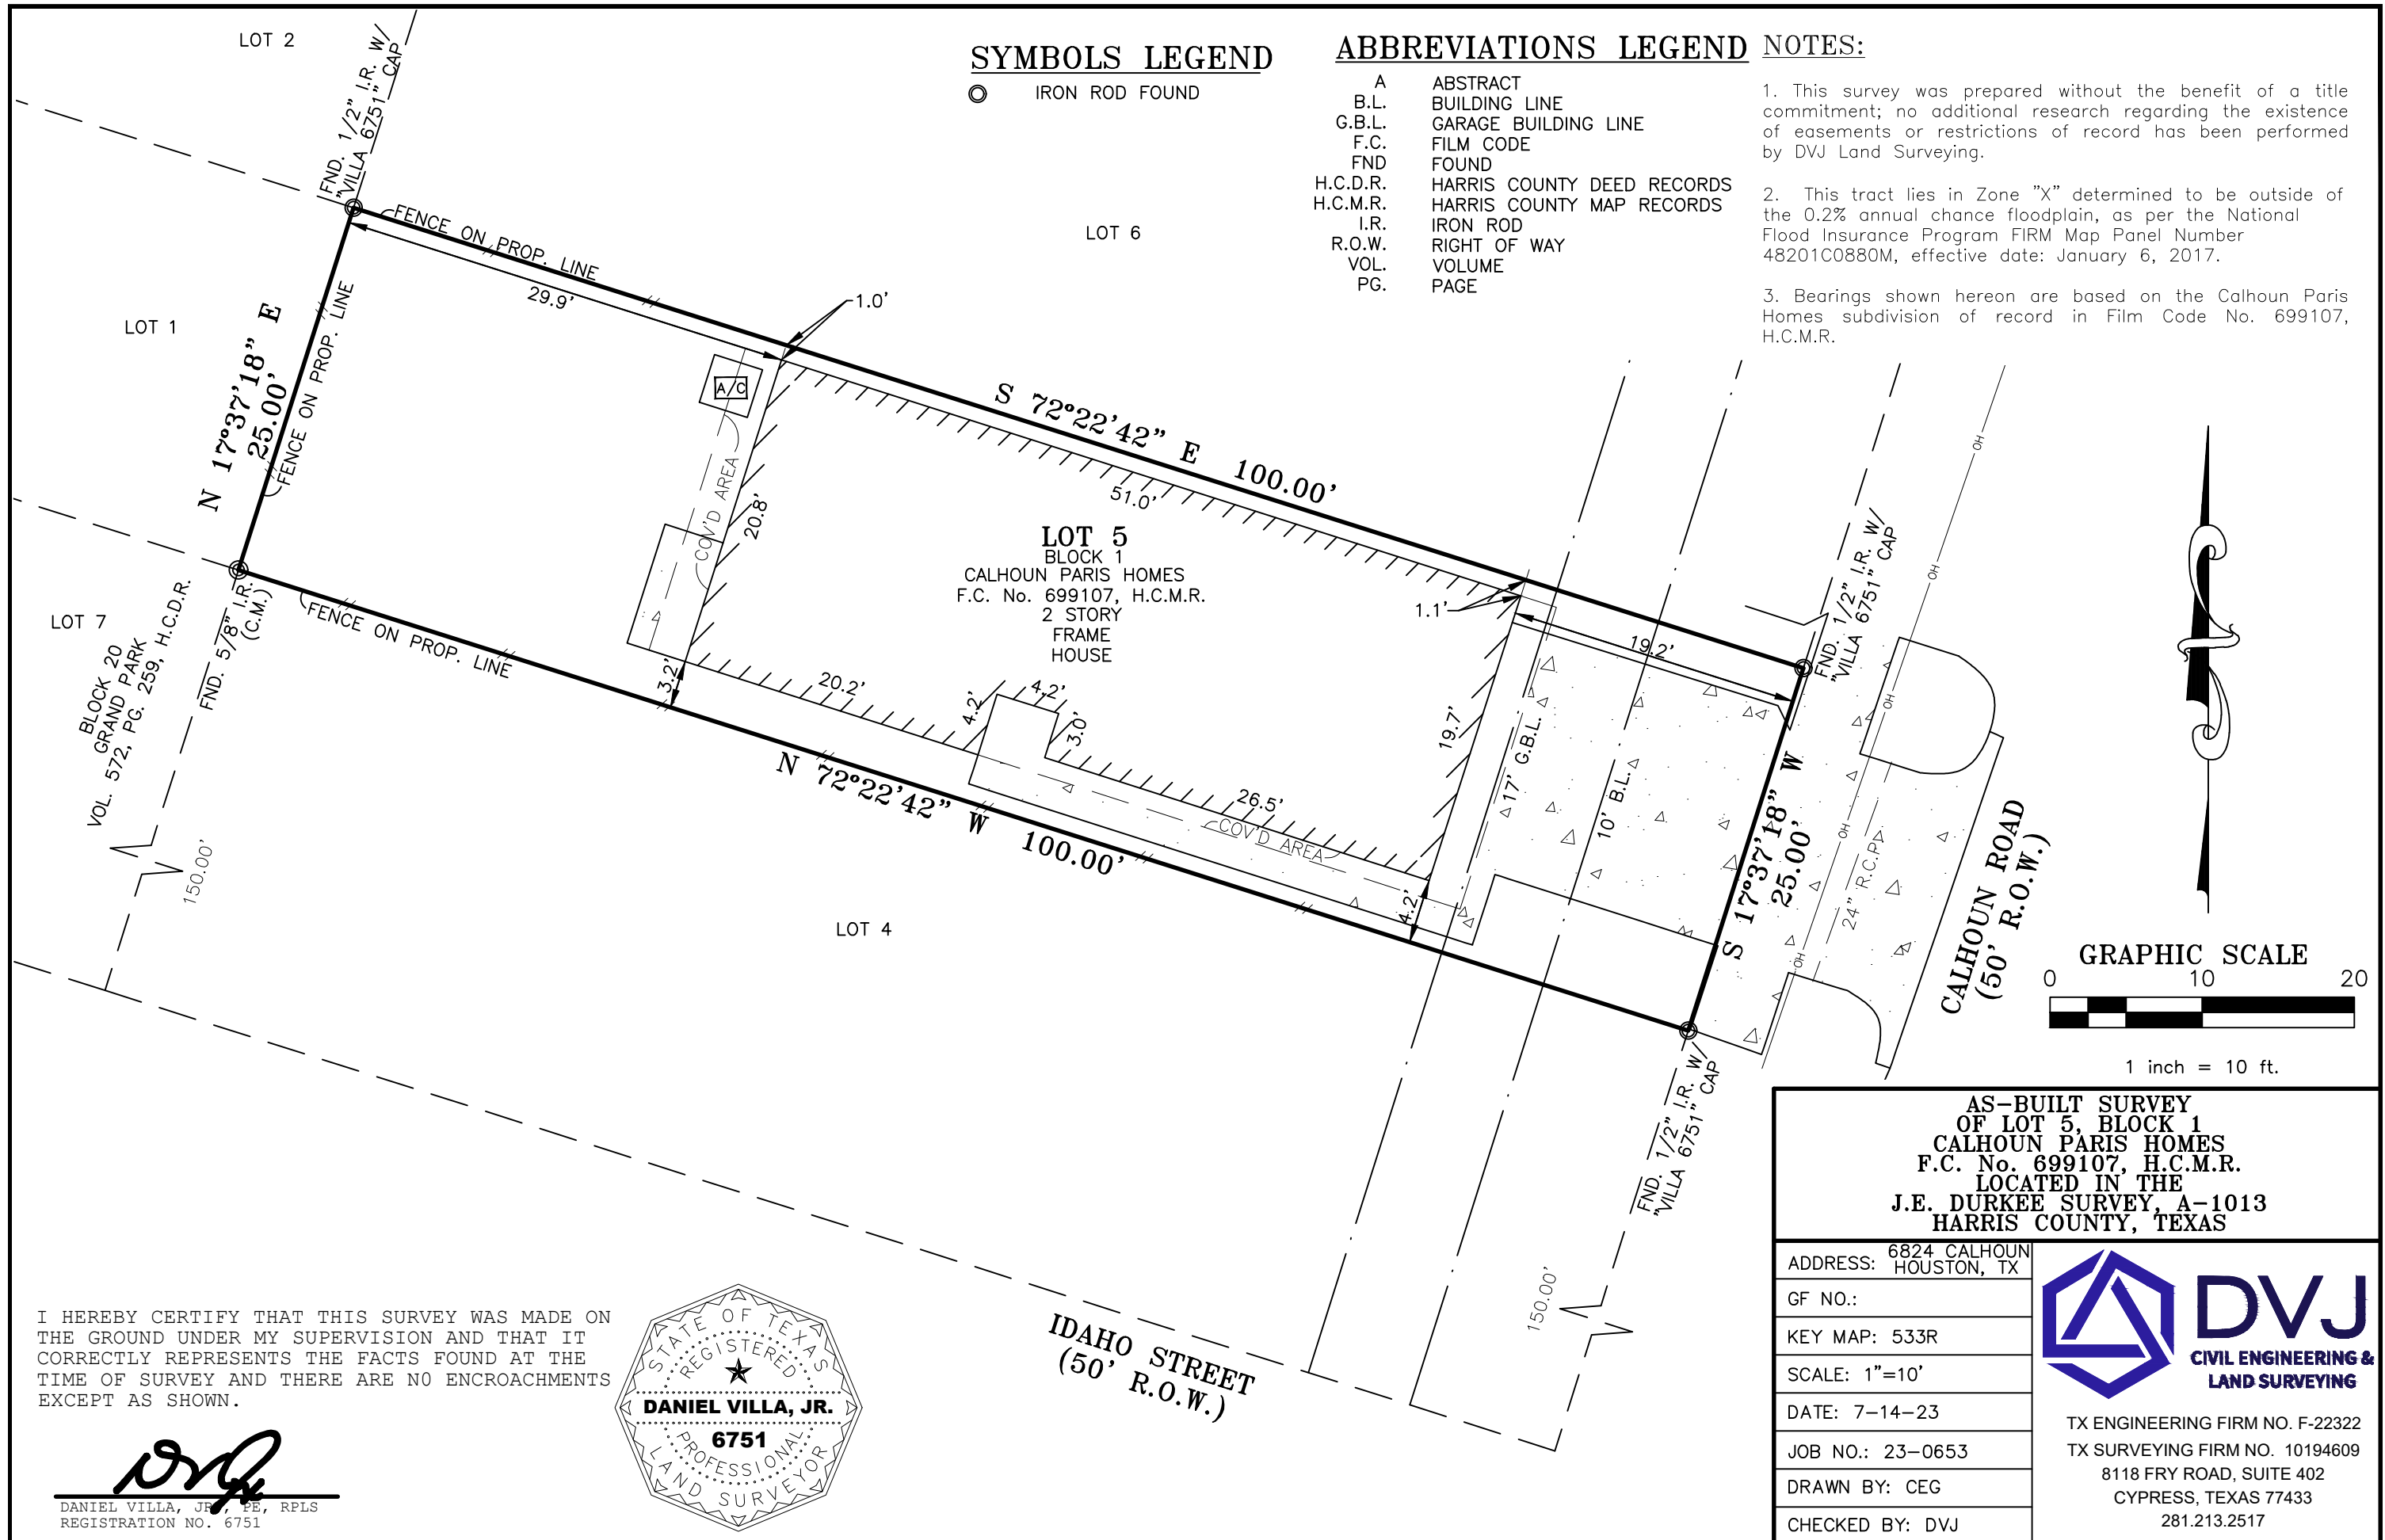

**AS-BUILT SURVEY
 OF LOT 5, BLOCK 1
 CALHOUN PARIS HOMES
 F.C. No. 699107, H.C.M.R.
 LOCATED IN THE
 J.E. DURKEE SURVEY, A-1013
 HARRIS COUNTY, TEXAS**

ADDRESS:	6824 CALHOUN HOUSTON, TX
GF NO.:	
KEY MAP:	533R
SCALE:	1"=10'
DATE:	7-14-23
JOB NO.:	23-0653
DRAWN BY:	CEG
CHECKED BY:	DVJ



TX ENGINEERING FIRM NO. F-22322
 TX SURVEYING FIRM NO. 10194609
 8118 FRY ROAD, SUITE 402
 CYPRESS, TEXAS 77433
 281.213.2517

I HEREBY CERTIFY THAT THIS SURVEY WAS MADE ON THE GROUND UNDER MY SUPERVISION AND THAT IT CORRECTLY REPRESENTS THE FACTS FOUND AT THE TIME OF SURVEY AND THERE ARE NO ENCROACHMENTS EXCEPT AS SHOWN.

[Signature]
 DANIEL VILLA, JR., PE, RPLS
 REGISTRATION NO. 6751



IDAHO STREET
 (50' R.O.W.)