


ADDRESS: 717 A HERKIMER STREET  
HOUSTON TX, 77008

# ASBUILT SURVEY OF LOT 24, BLOCK 268 OF HOUSTON HEIGHTS

BUYER: ELIZABETH A. SMITH

EIGHT STREET

ACCORDING TO THE MAP OR PLAT THEREOF RECORDED  
UNDER VOLUME 1A, PAGE 115 OF THE MAP RECORDS OF  
HARRIS COUNTY, TEXAS

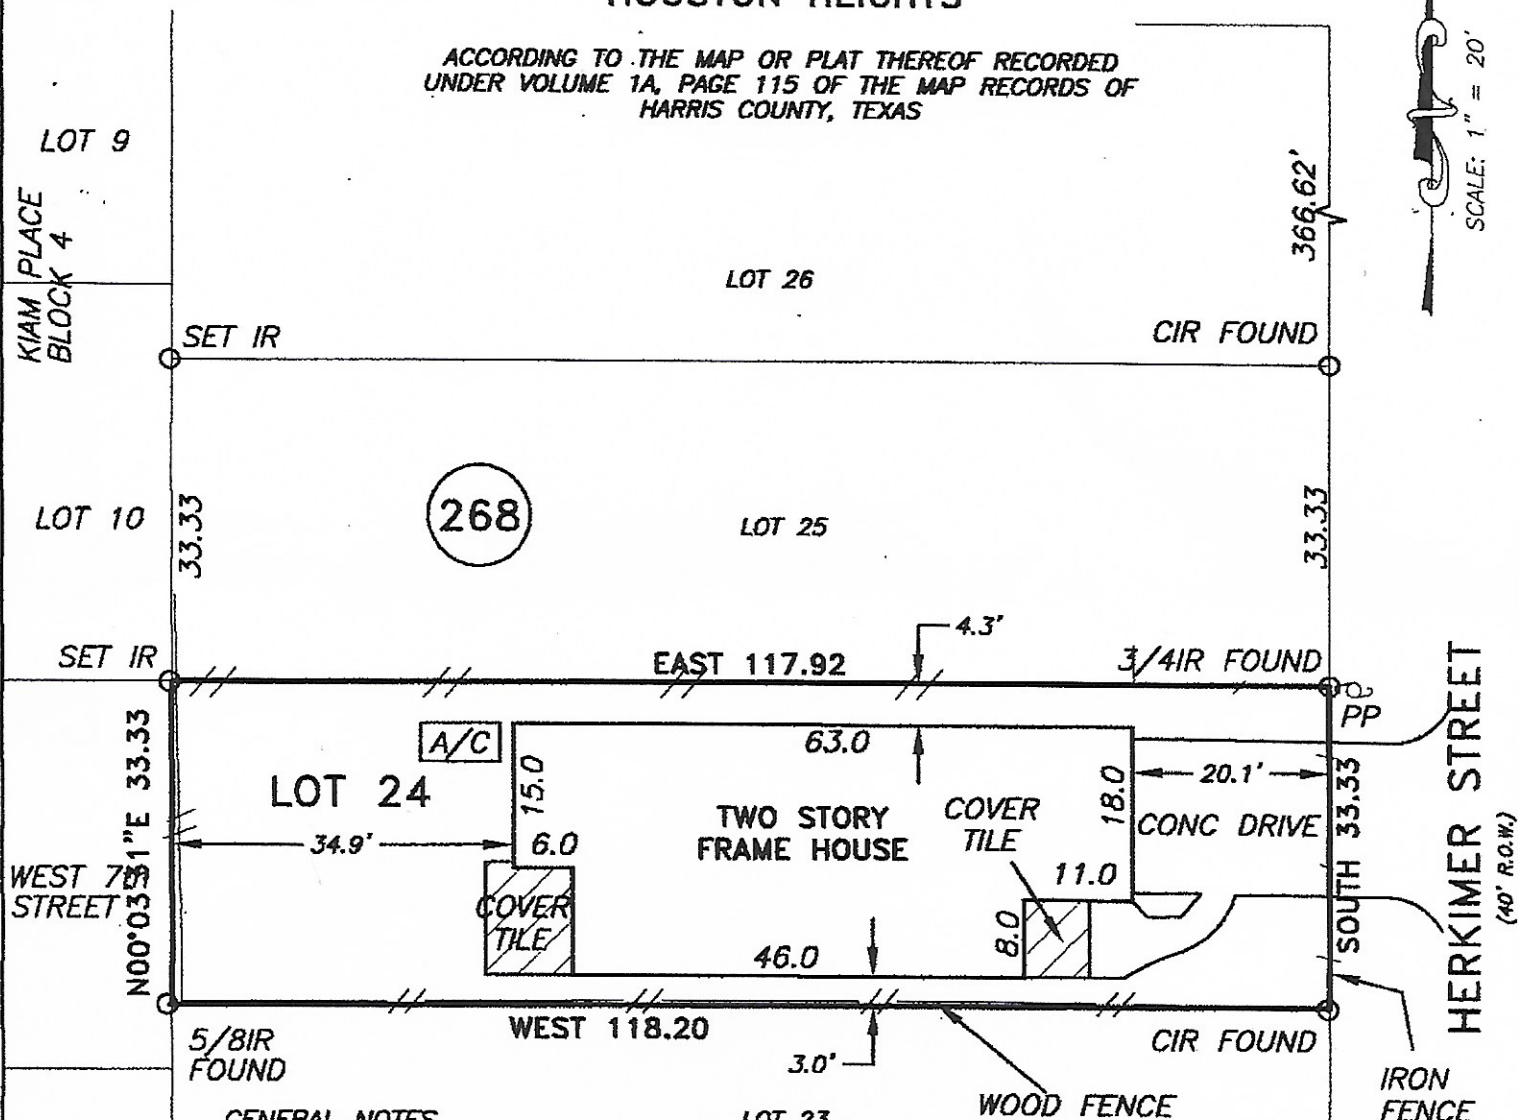

### GENERAL NOTES

A: THIS PROPERTY DOES NOT LIE WITHIN THE 100 YEAR FLOOD PLAIN AS ESTABLISHED BY THE U.S. DEPT. OF HOUSING & URBAN DEVELOPMENT. COMMUNITY/PANEL NO. 48201C 0670 L MAP JUNE 18, 2007 ZONE X

B: BEARING SHOWN ARE BASED ON RECORD PLAT


C: THIS SURVEY WAS PREPARED AND RELIED ON TITLE COMMITMENT No. 1370921-H029, TITLE ABSTRACTING PROVIDED BY FIRST AMERICAN TITLE INSURANCE COMPANY. OTHER EASEMENTS AND/OR BUILDING LINES MAY AFFECT THIS TRACT.

I HEREBY CERTIFY THAT THIS SURVEY WAS MADE ON THE GROUND, THAT THIS PLAT CORRECTLY REPRESENTS THE FACTS FOUND AT THE TIME OF SURVEY AND THAT THERE ARE NO ENCROACHMENTS APPARENT ON THE GROUND, EXCEPT AS SHOWN HEREON.

10 H. THE PROPERTY COVERED HEREIN IS SUBJECT TO THE TERMS, CONDITIONS, PROVISIONS AND STIPULATIONS OF ORDINANCE #1999-262, OF THE CITY OF HOUSTON, PASSED MARCH 24, 1999, AND AMENDMENTS, PERTAINING TO THE PLATTING AND REPLATTING OF REAL PROPERTY AND THE ESTABLISHMENT OF BUILDING SET BACK LINES ALONG MAJOR THOROUGHFARES WITHIN SUCH BOUNDARIES.

*Elizabeth A. Smith*  
28 Aug 09

DON TED MALER  
PROFESSIONAL LAND SURVEYOR

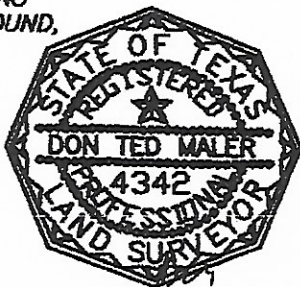

**D.T. MALER  
& ASSOCIATES**

10134 HAMMERLY BLVD, SUITE 110 HOUSTON, TEXAS 77080  
PHONE: 713-505-6417 FAX: 713-465-3442

DRAWING NO. 09-136 A LT 24  
8-24-2009