

# ELEVATION CERTIFICATE

Important: Read the instructions on pages 1 - 7.

<b>SECTION A - PROPERTY OWNER INFORMATION</b>			For Insurance Company Use:
BUILDING OWNER'S NAME Steve Milligan and Gisela Carillo			Policy Number
BUILDING STREET ADDRESS (Including Apt., Unit, Suite, and/or Bldg. No.) OR P.O. ROUTE AND BOX NO. 10114 Willowgrove Drive			Company NAIC Number
CITY Houston	STATE TX	ZIP CODE 77035	
PROPERTY DESCRIPTION (Lot and Block Numbers, Tax Parcel Number, Legal Description, etc.) Lot 11, Block 22, of WILLOW MEADOWS, Section 8			
BUILDING USE (e.g., Residential, Non-residential, Addition, Accessory, etc. Use a Comments area, if necessary.) Residential			
LATITUDE/LONGITUDE (OPTIONAL) (##° - ##' - ###.###" or ###.#####°)		HORIZONTAL DATUM: <input type="checkbox"/> NAD 1927 <input checked="" type="checkbox"/> NAD 1983	SOURCE: <input type="checkbox"/> GPS (Type): _____ <input type="checkbox"/> USGS Quad Map <input type="checkbox"/> Other: _____

## SECTION B - FLOOD INSURANCE RATE MAP (FIRM) INFORMATION

B1. NFIP COMMUNITY NAME & COMMUNITY NUMBER City of Houston, 40287		B2. COUNTY NAME Harris		B3. STATE TX	
B4. MAP AND PANEL NUMBER 48201C0865	B5. SUFFIX K	B6. FIRM INDEX DATE 11/06/96	B7. FIRM PANEL EFFECTIVE/REVISED DATE 04/20/00	B8. FLOOD ZONE(S) AE	B9. BASE FLOOD ELEVATION(S) (Zone AO, use depth of flooding) 52.0

B10. Indicate the source of the Base Flood Elevation (BFE) data or base flood depth entered in B9.

- FIS Profile  FIRM  Community Determined  Other (Describe): \_\_\_\_\_

B11. Indicate the elevation datum used for the BFE in B9:  NGVD 1929  NAVD 1988  Other (Describe): \_\_\_\_\_

B12. Is the building located in a Coastal Barrier Resources System (CBRS) area or Otherwise Protected Area (OPA)?  Yes  No Designation Date \_\_\_\_\_

## SECTION C - BUILDING ELEVATION INFORMATION (SURVEY REQUIRED)

C1. Building elevations are based on:  Construction Drawings\*  Building Under Construction\*  Finished Construction

\*A new Elevation Certificate will be required when construction of the building is complete.

C2. Building Diagram Number 1 (Select the building diagram most similar to the building for which this certificate is being completed - see pages 6 and 7. If no diagram accurately represents the building, provide a sketch or photograph.)

C3. Elevations - Zones A1-A30, AE, AH, A (with BFE), VE, V1-V30, V (with BFE), AR, AR/A, AR/AE, AR/A1-A30, AR/AH, AR/AO

Complete Items C3.-a-i below according to the building diagram specified in Item C2. State the datum used. If the datum is different from the datum used for the BFE in Section B, convert the datum to that used for the BFE. Show field measurements and datum conversion calculation. Use the space provided or the Comments area of Section D or Section G, as appropriate, to document the datum conversion.

Datum 1983 Conversion/Comments

Elevation reference mark used SEE COMM Does the elevation reference mark used appear on the FIRM?  Yes  No

- o a) Top of bottom floor (including basement or enclosure) 52.1 ft.(m)
- o b) Top of next higher floor N/A . ft.(m)
- o c) Bottom of lowest horizontal structural member (V zones only) NA . ft.(m)
- o d) Attached garage (top of slab) NA . ft.(m)
- o e) Lowest elevation of machinery and/or equipment servicing the building (Describe in a Comments area) NA . ft.(m)
- o f) Lowest adjacent (finished) grade (LAG) 50.4 ft.(m)
- o g) Highest adjacent (finished) grade (HAG) 51.2 ft.(m)
- o h) No. of permanent openings (flood vents) within 1 ft. above adjacent grade NA
- o i) Total area of all permanent openings (flood vents) in C3.h NA sq. in. (sq. cm)

License Number, Embossed Seal, Signature, and Date



## SECTION D - SURVEYOR, ENGINEER, OR ARCHITECT CERTIFICATION

This certification is to be signed and sealed by a land surveyor, engineer, or architect authorized by law to certify elevation information.

I certify that the information in Sections A, B, and C on this certificate represents my best efforts to interpret the data available.

I understand that any false statement may be punishable by fine or imprisonment under 18 U.S. Code, Section 1001.

CERTIFIER'S NAME Earl N. Strom

LICENSE NUMBER 4123

TITLE R.P.L.S.	COMPANY NAME National Survey Specialist of Houston		
ADDRESS 5115 FM 1960 E	CITY Humble	STATE Tx	ZIP CODE 77346
SIGNATURE <i>Earl N. Strom</i>	DATE 01/30/06	TELEPHONE 281-812-6120	



<b>IMPORTANT: In these spaces, copy the corresponding information from Section A.</b>			For Insurance Company Use:
BUILDING STREET ADDRESS (Including Apt., Unit, Suite, and/or Bldg. No.) OR P.O. ROUTE AND BOX NO. 10114 Willowgrove Drive			Policy Number
CITY Houston	STATE TX	ZIP CODE 77071	Company NAIC Number

**SECTION D - SURVEYOR, ENGINEER, OR ARCHITECT CERTIFICATION (CONTINUED)**

Copy both sides of this Elevation Certificate for (1) community official, (2) insurance agent/company, and (3) building owner.

COMMENTS

BM-D1120335, ELEV. 51.77

Check here if attachments

**SECTION E - BUILDING ELEVATION INFORMATION (SURVEY NOT REQUIRED) FOR ZONE AO AND ZONE A (WITHOUT BFE)**

For Zone AO and Zone A (without BFE), complete Items E1 through E4. If the Elevation Certificate is intended for use as supporting information for a LOMA or LOMR-F, Section C must be completed.

- E1. Building Diagram Number \_\_ (Select the building diagram most similar to the building for which this certificate is being completed – see pages 6 and 7. If no diagram accurately represents the building, provide a sketch or photograph.)
- E2. The top of the bottom floor (including basement or enclosure) of the building is \_\_ ft.(m) \_\_ in.(cm)  above or  below (check one) the highest adjacent grade. (Use natural grade, if available).
- E3. For Building Diagrams 6-8 with openings (see page 7), the next higher floor or elevated floor (elevation b) of the building is \_\_ ft.(m) \_\_ in.(cm) above the highest adjacent grade. Complete items C3.h and C3.i on front of form.
- E4. The top of the platform of machinery and/or equipment servicing the building is \_\_ ft.(m) \_\_ in.(cm)  above or  below (check one) the highest adjacent grade. (Use natural grade, if available).
- E5. For Zone AO only: If no flood depth number is available, is the top of the bottom floor elevated in accordance with the community's floodplain management ordinance?  
 Yes  No  Unknown. The local official must certify this information in Section G.

**SECTION F - PROPERTY OWNER (OR OWNER'S REPRESENTATIVE) CERTIFICATION**

The property owner or owner's authorized representative who completes Sections A, B, C (Items C3.h and C3.i only), and E for Zone A (without a FEMA-issued or community-issued BFE) or Zone AO must sign here. *The statements in Sections A, B, C, and E are correct to the best of my knowledge.*

PROPERTY OWNER'S OR OWNER'S AUTHORIZED REPRESENTATIVE'S NAME

ADDRESS \_\_\_\_\_ CITY \_\_\_\_\_ STATE \_\_\_\_\_ ZIP CODE \_\_\_\_\_

SIGNATURE \_\_\_\_\_ DATE \_\_\_\_\_ TELEPHONE \_\_\_\_\_

COMMENTS

Check here if attachments

**SECTION G - COMMUNITY INFORMATION (OPTIONAL)**

The local official who is authorized by law or ordinance to administer the community's floodplain management ordinance can complete Sections A, B, C (or E), and G of this Elevation Certificate. Complete the applicable item(s) and sign below.

- G1.  The information in Section C was taken from other documentation that has been signed and embossed by a licensed surveyor, engineer, or architect who is authorized by state or local law to certify elevation information. (Indicate the source and date of the elevation data in the Comments area below.)
- G2.  A community official completed Section E for a building located in Zone A (without a FEMA-issued or community-issued BFE) or Zone AO.
- G3.  The following information (Items G4-G9) is provided for community floodplain management purposes.

G4. PERMIT NUMBER	G5. DATE PERMIT ISSUED	G6. DATE CERTIFICATE OF COMPLIANCE/OCCUPANCY ISSUED
-------------------	------------------------	---

G7. This permit has been issued for:  New Construction  Substantial Improvement

G8. Elevation of as-built lowest floor (including basement) of the building is: \_\_\_\_\_ ft.(m) Datum: \_\_\_\_\_

G9. BFE or (in Zone AO) depth of flooding at the building site is: \_\_\_\_\_ ft.(m) Datum: \_\_\_\_\_

LOCAL OFFICIAL'S NAME \_\_\_\_\_ TITLE \_\_\_\_\_

COMMUNITY NAME \_\_\_\_\_ TELEPHONE \_\_\_\_\_


SIGNATURE \_\_\_\_\_ DATE \_\_\_\_\_

COMMENTS



Check here if attachments

**Boundary Survey**

\*\*\*744294\*\*\*  
\*\*\*744294\*\*\*

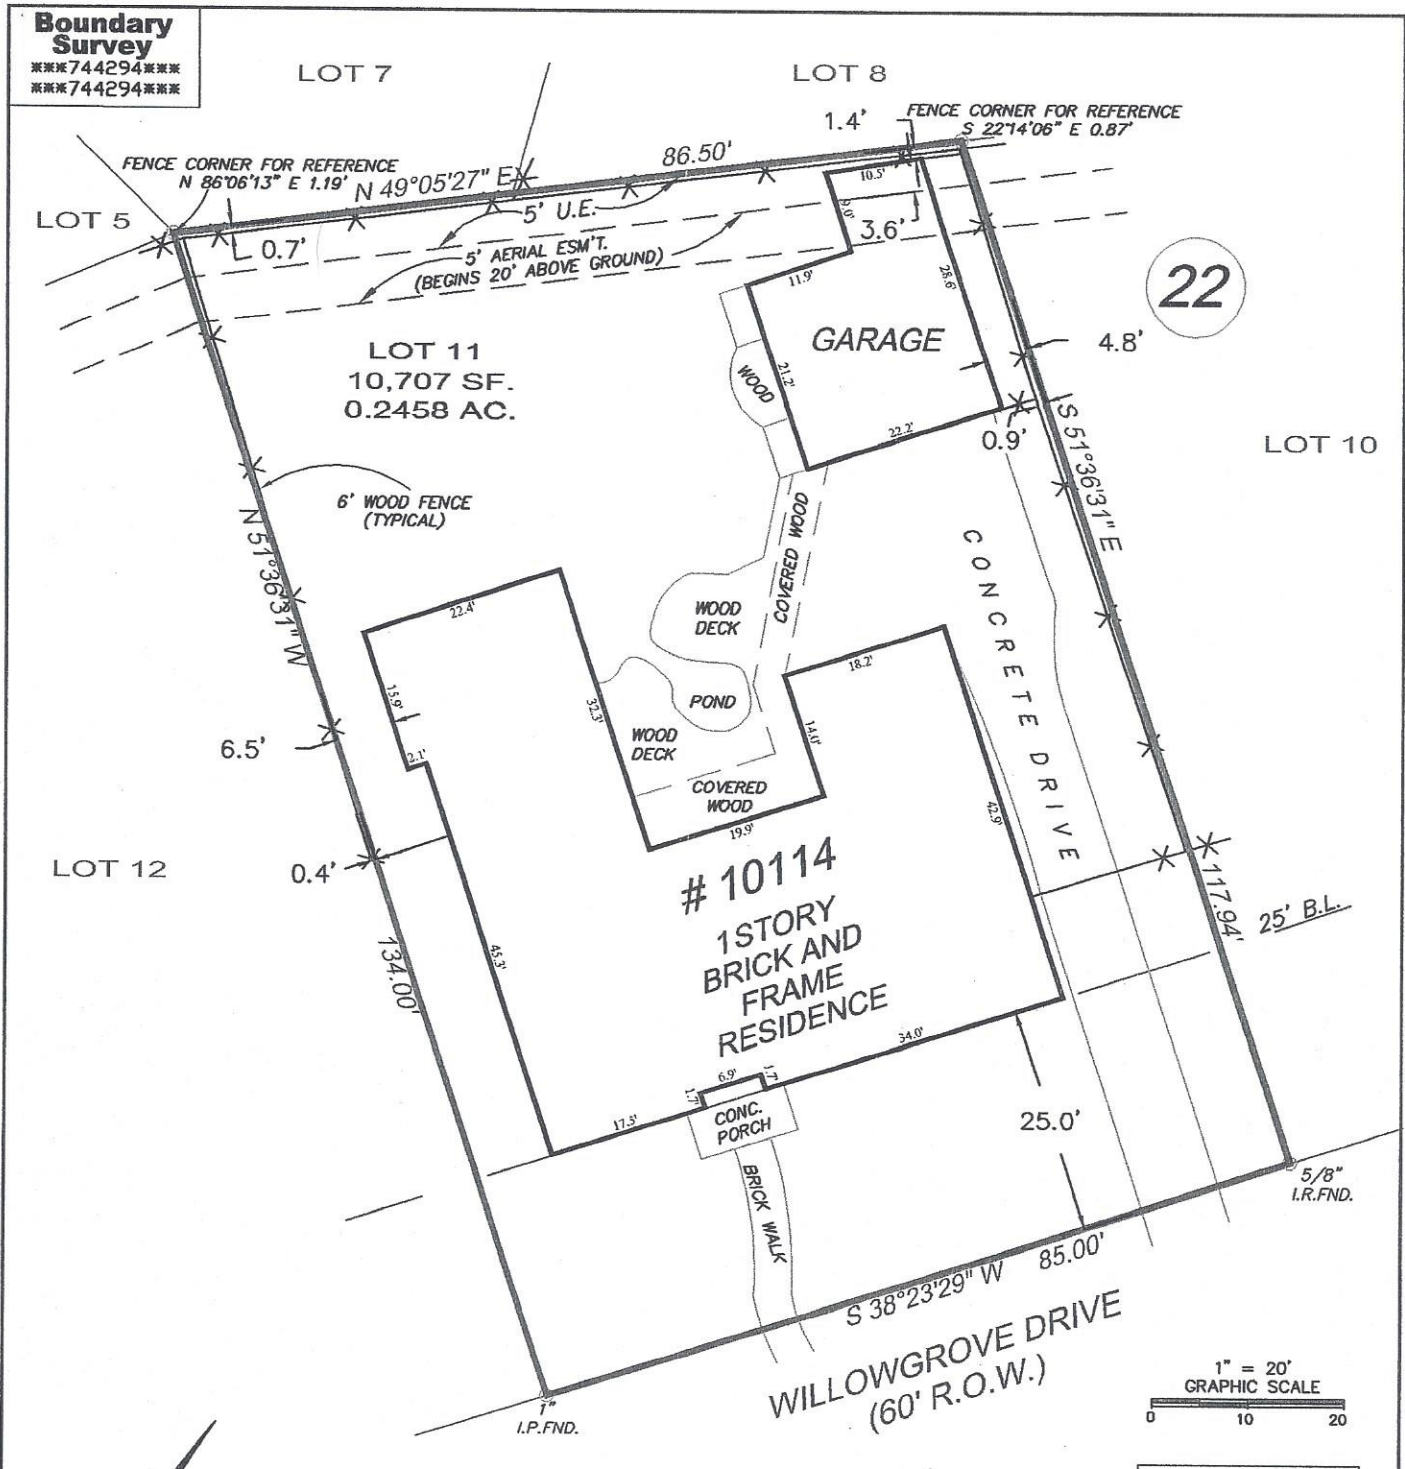

22

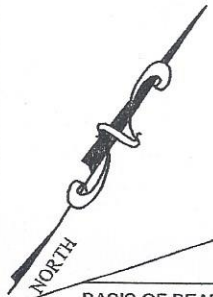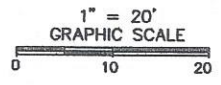

**ADDRESS**

10114 WILLOWGROVE DRIVE  
HOUSTON, TX 77035

**LEGAL DESCRIPTION: (AS FURNISHED)**

Lot 11, Block 22, of WILLOW MEADOWS, Section 8, a subdivision in Harris County, Texas, according to the map or plat thereof recorded in Volume 53, Page 4, of the Map Records of Harris County, Texas.

BASIS OF BEARINGS: RECORDED PLAT

LIST OF POSSIBLE ENCROACHMENTS: FENCE PROTRUSION AS SHOWN ABOVE, UTILITY EASEMENT PROTRUSION AS SHOWN ABOVE

**SURVEYOR INFORMATION:**



National Surveying Specialists of Houston, Inc.  
5115 F.M. 1960 E - Humble, Texas 77346  
281-812-6120 - 281-966-1649 (Fax)  
email: NSS@Surveytx.com

**COORDINATED BY:**

**RESIDENTIAL  
LAND SERVICES, INC.**

a part of the *Outland*  
621 24TH AVENUE S.W.  
NORMAN, OKLAHOMA 73069  
FAX: (405) 701-1002  
PHONE (405) 701-1100  
WWW.RLSNOW.COM



RLS #:	06-01-1490
CLIENT #:	744294-H016
FIELD DATE:	01/24/06
DRAFTER:	JNK
APPROVED:	TPM
SCALE:	1" = 20'