




SCALE: 1" = 20'  
 DWN. BY: FAN ARTS  
 DATE: AUGUST 12, 2002

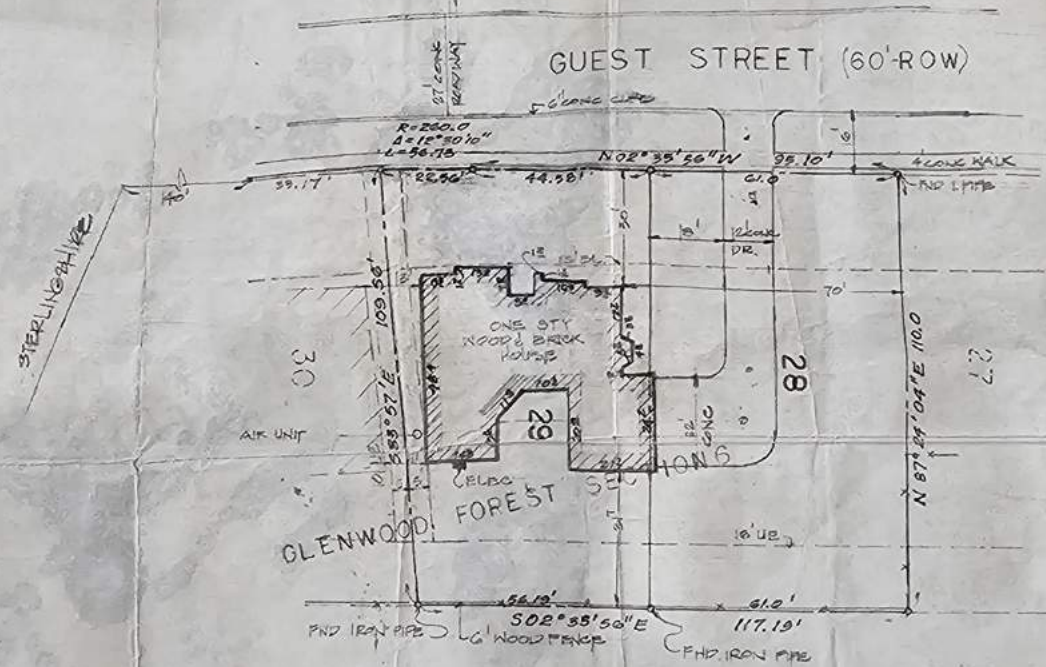

ACREAGE

"AS BUILT SURVEY"

of  
 HOUSE CONSTRUCTION ON LOTS 28 AND 29,  
 IN GLENWOOD FOREST, SECTION 6, AN  
 ADDITION IN HARRIS COUNTY, TEXAS  
 ACCORDING TO THE MAP OR PLAT THERE OF  
 RECORDED IN VOLUME 256, PAGE 28, MAP  
 RECORDS OF HARRIS COUNTY, TEXAS.

WE HEREBY CERTIFY THE INFORMATION SHOWN IS THE  
 FIELD CONDITIONS FOUND OF HOUSE CONSTRUCTION  
 AT THE SITE.



ALBERT NATHAN, JR., P.E., P.R.L.S.  
 CONSULTING ENGINEERS-SURVEYORS  
 2912 PAVISON ST.  
 HOUSTON, TX 77021-2022