




Benchmark Info.:
RM No. 010175; Elevation = 50.55'
NAVD88; 2001 Adjustment.

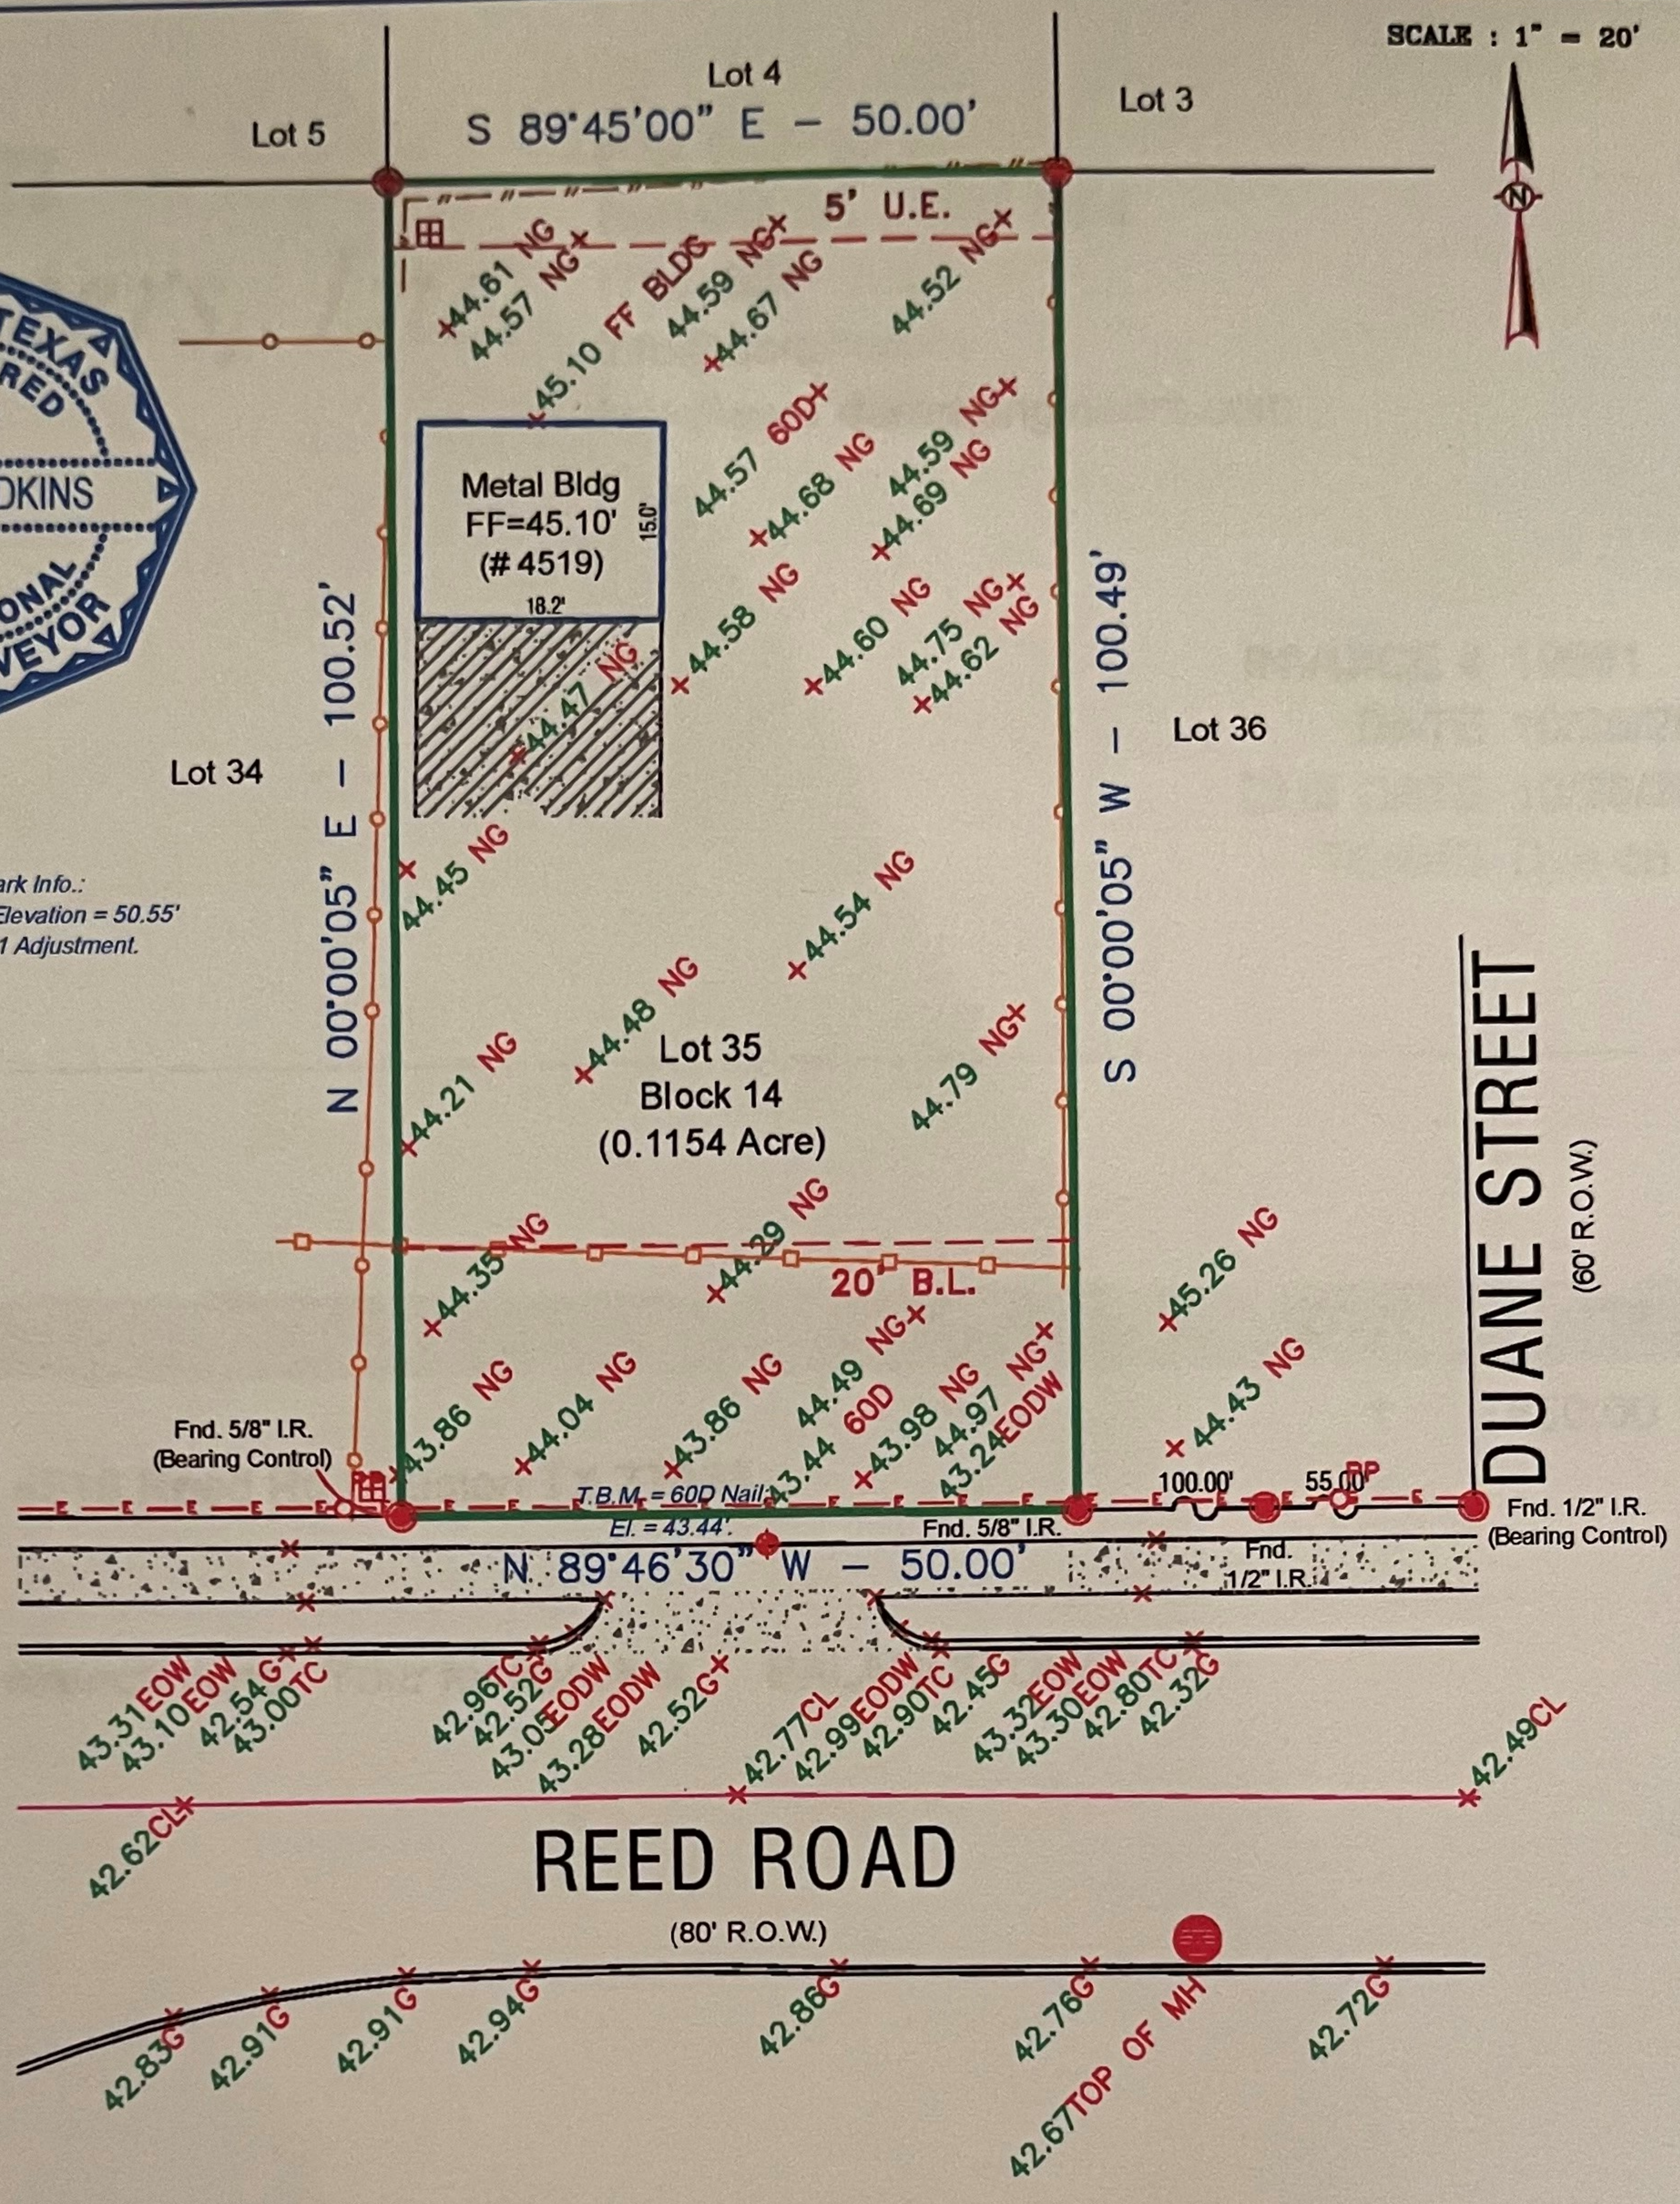

Notes:
 - Basis for Bearings: RECORD PLAT.
 - Distances shown are ground distances.
 - All abstracting done by title company.
 - All B.L.'s & U.E.'s taken from recorded plat unless otherwise noted.
 - Dimension ties from improvements to property lines are calculated and should NOT be relied upon for construction and/or removal of any improvements including fences.
 - Building dimensions may not be used to calculate square footage.
 - This property subject to any and all recorded and unrecorded easements. Surveyor has made no investigation or independent search for easements of record, encumbrances, restrictive covenants or ownership title evidence.

LEGEND:
 --- = Wood Fence
 --- = Chain Link
 --- = Wrought Iron
 --- = Overhead Powerline
 ● = Tree
 ○ = Power Pole
 ○ = Service Pole
 U.E. = Utility Easement
 D.E. = Drainage Easement
 B.L. = Building Line
 G.E. = Guy Easement
 L.R. = Iron Rod
 I.P. = Iron Pipe
 P.I.P. = Pinch Iron Pipe
 P.P. = Power Pole
 S.S.E. = Storm Sewer Easement
 San.S.E. = Sanitary Sewer Easement
 H.C.C.F.No. = Harris County Clerk File Number

Barry D. Adkins
 10/18/2017
 BARRY D. ADKINS, R.P.L.S. No. 6137

This survey is certified for this transaction only, is not transferable to additional institutions or subsequent owners. If this survey does not bear an original BLUE seal it is invalid and should not be relied upon for any purpose.

This property appears to be OUT of the 100 year flood plain (Zone X); as per insurance rate map 48201C0890 L, dated 06/18/2007.
 This determination to be used for flood insurance rate purposes ONLY and is NOT to be relied upon for ANY other purpose. Surveyor makes no representation as to whether property may Flood.

LOT: 35	BLOCK: 14	SUBDIVISION: FLOWER CITY	COUNTY: HARRIS
RECORDATION: VOLUME 23, PAGE 12 OF THE MAP RECORDS			ZIP CODE: 77051
ADDRESS: 4519 REED ROAD	CITY: HOUSTON	STATE: TEXAS	

This survey was performed without benefit of a title commitment and may not show all deed restrictions, easements, building lines and other matters of record.

DaRam Engineers, Inc.
 5420 Dashwood Drive, Suite 206
 Houston, Texas 77081
 (713) 528-1552 * Email: Info@daram.com

Field Crew: BS
 Drafter: TA
 Project #: S201777051-Reed4519