


NOTES:

1. Plat Scale: 1" = 30'
2. The bearings for this survey are based on the recorded plat (record deed) shown on this survey.
3. Roads dedicated by recorded plat (record deed) unless otherwise noted
4. This plat of survey has been performed with reliance upon title examination and abstracting performed by Old Republic Title Company under GF No. 1000945 with an effective date of 05/06/10. This surveyor has not abstracted the subject property.

5. The professional service reflected on this plat of survey is provided in connection with the transaction anticipated by the title search referenced and dated above, it is not to be used for any other purpose. This original work is protected under copyright laws, Title 17 United States Code Sections 101 and 102. All violators will be prosecuted to the fullest extent of the law. This survey is being provided solely for the use of the recipients named below and no license has been created, expressed or implied, to copy the survey except as is necessary in conjunction with the original transaction, which shall take place within thirty (30) days from the date shown hereon.



Bonnie Sue Butler
Residual of
40 x 110 yrs
CF 2002-064134
RPRMCT

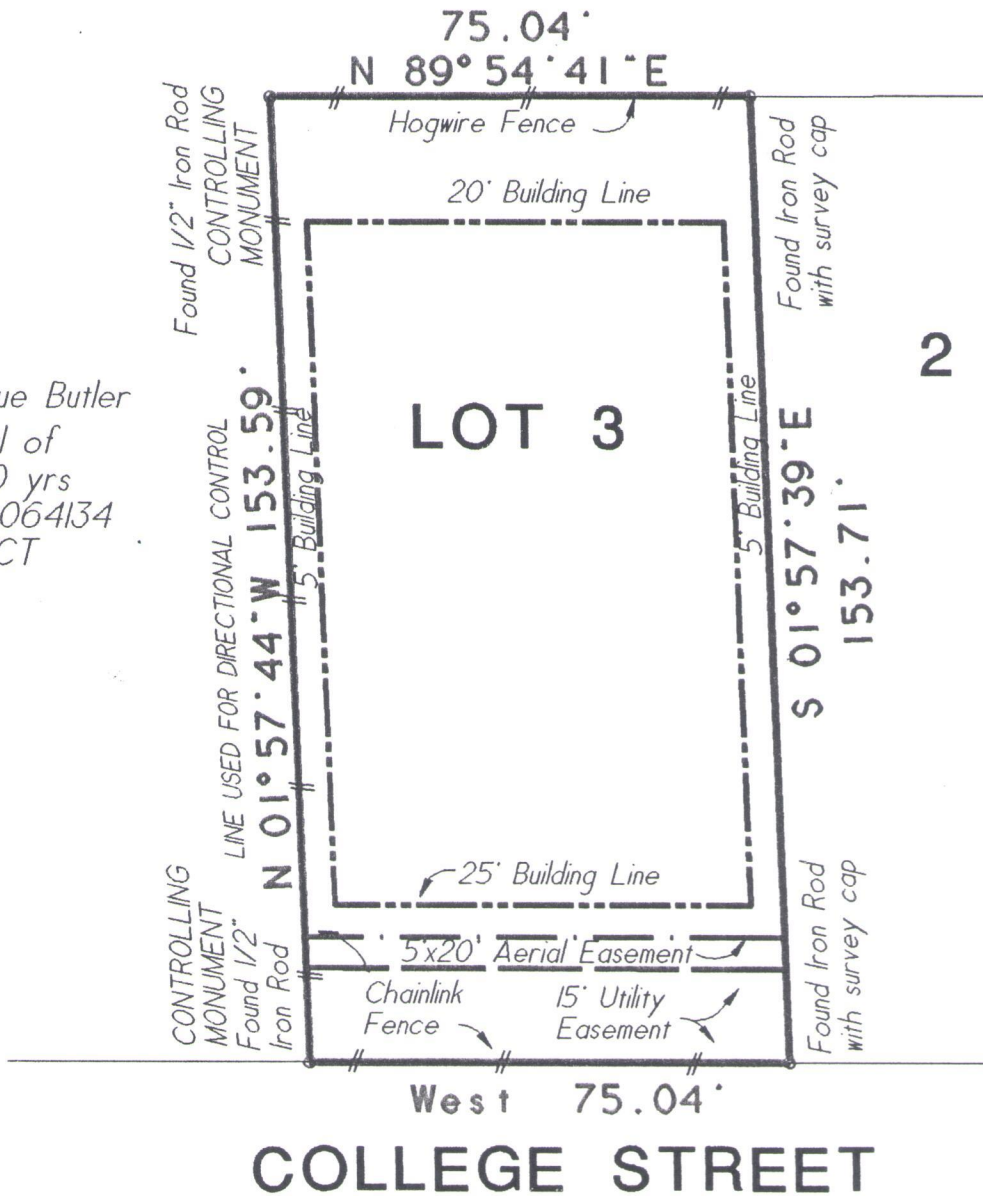

Lot 3, Suber Subdivision, a subdivision of 0.886 acre of land situated in the John Corner Survey, A-8, of Montgomery County, Texas, according to the map or plat thereof recorded under Cabinet Y, Sheet 167 of the Map Records of Montgomery County, Texas.

If this plat and accompanying description are not sealed with the raised embossing seal of R.P.L.S. whose signature appears on the raised seal and in red ink, it is considered a copy, and not a legal original. See Note 5 above.

Purchaser: Frank W. Gault and spouse, Elizabeth K. Gault
Address: 606 College Street
Montgomery, Texas 77356

Revised: 05/25/10 (DG)
Date: 05/18/10 (DG)

GF No.: 1000945

Job No.: 2010-052

RPLS #4627

To: Old Republic Title Company

We, Glezman Surveying, Inc., acting by and through Michael Glezman, a Registered Professional Land Surveyor in the State of Texas, hereby certify that this survey and professional service substantially conforms to the Texas Society of Professional Surveyors Standards and Specifications for a Category 1A, Condition 111 Survey.

© 2010 All Rights Reserved

Surveying Southeast Texas since 1987

GLEZMAN SURVEYING, INC.

1938 Old River Road
Montgomery, Texas 77356

Office: (936) 582-6340 www.glezmansurveying.com

