



JILL KAKA HARRIS

 936-521-2000



PRECISION



 surveyors

2811-436-1538

 2811-436-1537

 2710-273-4841

 1797 W. LOOP 430 SUITE 800 SAN ANTONIO, TEXAS 78213

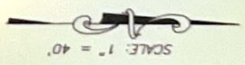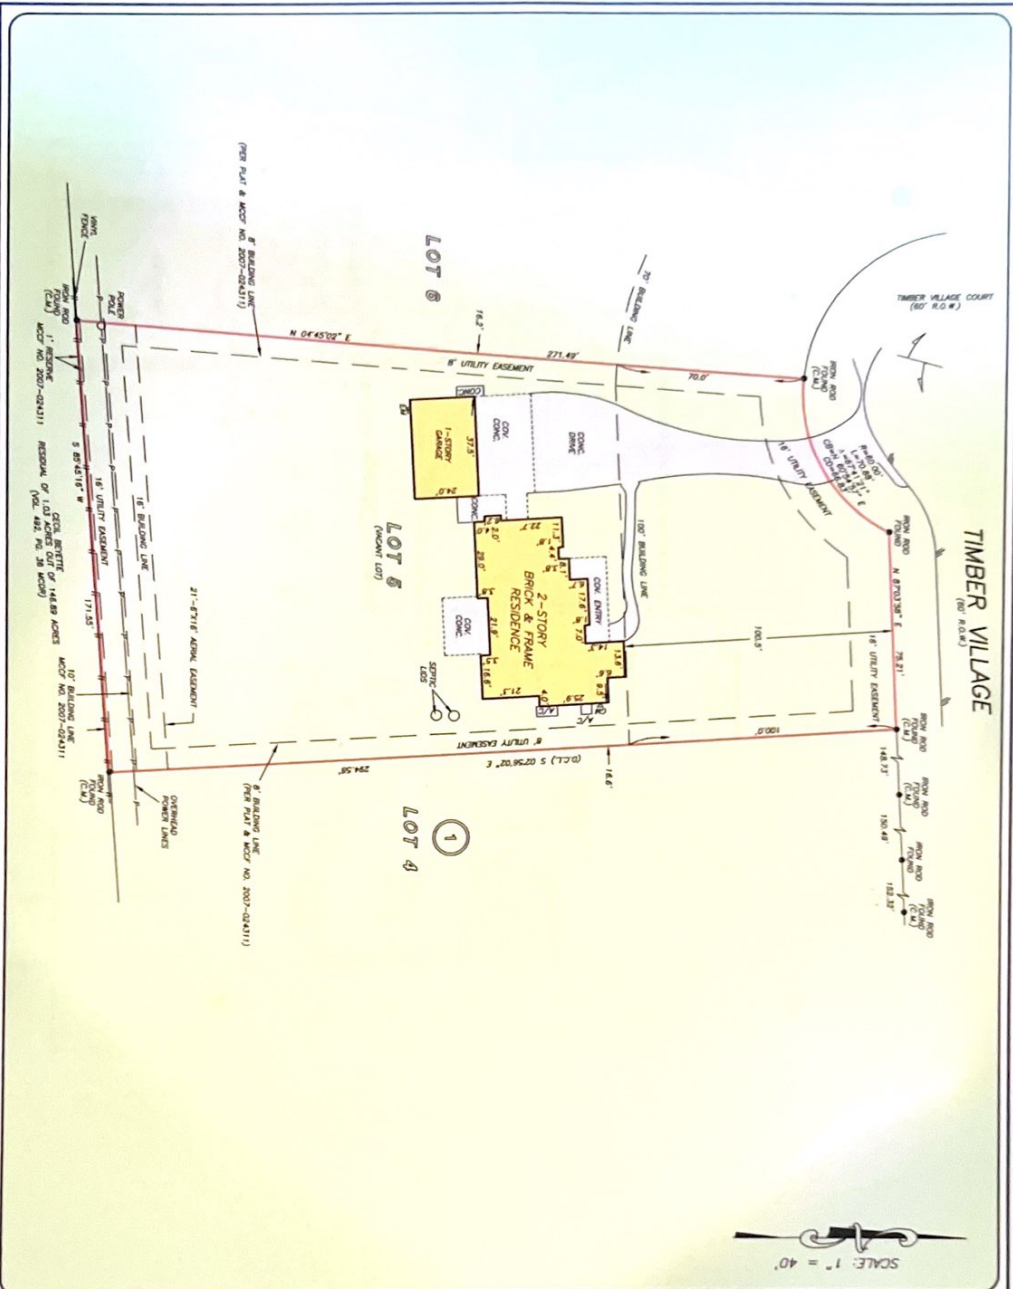

OF NO. ATH-16C-ATH12021898CN ALAMO TITLE

 ADDRESS: 28222 TIMBER VILLAGE

 MAGNOLIA, TEXAS 77355

 BORROWER: BRIAN E. FORD AND

 EMILY J. FORD

LOT 5, BLOCK 1

THE VILLAGE AT HIGH MEADOW

SECTION 5-4

ACCORDING TO THE MAP OR PLAT THEREOF RECORDED

 IN CABINET 2, SHEET 648 OF THE MAP RECORDS

 OF MONTGOMERY COUNTY, TEXAS

WITH ASSURANCE BY AND DIRECT SUPERVISION AND A. L. & A.

 FOR REGISTRATION OF UNDERGROUND ELECTRIC

 CABLES BY A. L. & A. ENGINEERS AND SURVEYORS

 DOES NOT AFFECT SAID PROPERTY



THIS PROPERTY WAS NOT IN EXISTENCE THE

 1900 YEAR FLOOD PLAIN AS PER FEMA

 MAP RECORD NO. 17838

 AND RECORD NO. 17838

 AND RECORD NO. 17838

 ACCORDING TO VISUAL EXAMINATION OF AIRS

 PHOTOGRAPHS OF THIS LAND PROPERTY EARLY

 IN THE 1900'S, THERE IS NO EVIDENCE OF

 FLOODING WHICH WOULD BECOME FLOOD STAGE

 AND SURFACE INTERSECTION

 AND BEYOND THE SCOPE OF THIS SURVEY

D.C.L. - DIRECTIONAL CONTROL LINE

 RECORD DRAWING NUMBER 2, SHEET 648, ALAMO

 TITLE

 1. ANYBODY CARRYING THIS SURVEY MUST TAKE

 CARE TO PROTECT THE SURVEY MARKS AND

 MONUMENTS AND NOT REMOVE OR ALTER THEM

 OR IN ANY MANNER INTERFERE WITH THE

 ACCURACY OF THIS SURVEY. ANY PERSON

 WHO DOES THIS SHALL BE LIABLE TO THE

 SURVEYOR FOR ALL DAMAGES AND COSTS

 INCURRED IN REPAIRING OR REPLACING THE

 SAME.


 GEORGE PAUL

 MONTGOMERY COUNTY LAND SURVEYOR

 NO. 00812

 EXPIRES 08/31/2012



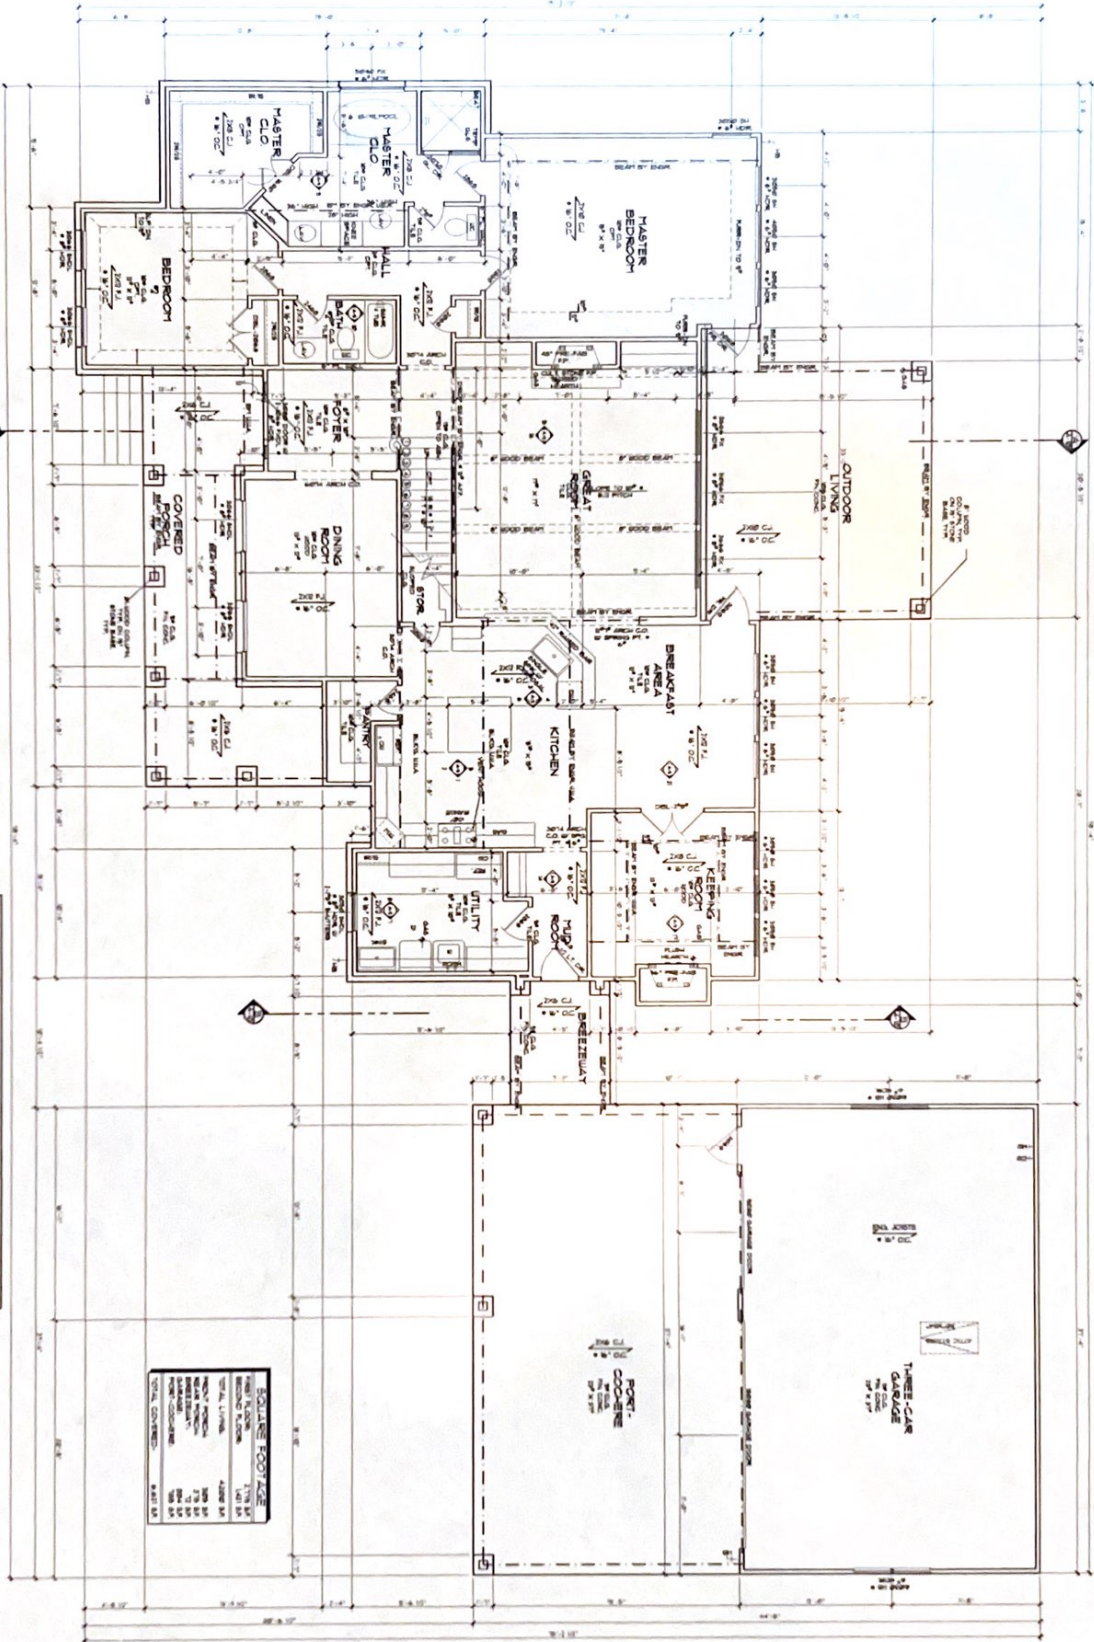

THESE PLANS SHALL COMPLY WITH THE PROVISIONS SET FORTH IN CHAPTER 11 OF THE INTERNATIONAL RESIDENTIAL CODE 2003.

FIRST FLOOR PLAN

SCALE: 1/4" = 1'-0"

SQUARE FOOTAGE	
GRAND TOTAL	3,450 SF
COVERED PORCH	1,100 SF
SCREENED PORCH	1,100 SF
SCREENED PATIO	1,100 SF
SCREENED DECK	1,100 SF
SCREENED PERGOLA	1,100 SF
SCREENED BALCONY	1,100 SF
SCREENED TERRACE	1,100 SF
SCREENED WALKWAY	1,100 SF
SCREENED DRIVEWAY	1,100 SF
SCREENED GARAGE	1,100 SF
SCREENED STAIRS	1,100 SF
SCREENED HALL	1,100 SF
SCREENED CLOSET	1,100 SF
SCREENED BATH	1,100 SF
SCREENED KITCHEN	1,100 SF
SCREENED BREAKFAST	1,100 SF
SCREENED DINING	1,100 SF
SCREENED LIVING	1,100 SF
SCREENED BEDROOM	1,100 SF
SCREENED MASTER BEDROOM	1,100 SF
SCREENED UTILITY	1,100 SF
SCREENED LAUNDRY	1,100 SF
SCREENED GARAGE	1,100 SF
SCREENED PORCH	1,100 SF
SCREENED PATIO	1,100 SF
SCREENED DECK	1,100 SF
SCREENED PERGOLA	1,100 SF
SCREENED BALCONY	1,100 SF
SCREENED TERRACE	1,100 SF
SCREENED WALKWAY	1,100 SF
SCREENED DRIVEWAY	1,100 SF
SCREENED GARAGE	1,100 SF

A-2

DATE	11-14-2003
BY	B.W.T.
CHECKED BY	B.W.T.
SCALE	1/4" = 1'-0"
PROJECT NO.	11-14-2003
CLIENT	BRIAN FORD
ADDRESS	LOT 5 BLK 1 SECT 5-A


A CUSTOM HOME FOR:
BRIAN FORD
VILL OF HIGH MEADOW RANCH
LOT: 5 BLK: 1 SECT: 5-A

Mark W. Todd • Architects, Inc.
Architects • Planners • Consultants
1440 Lake Forest Circle, Ste. 100
The Woodlands, Texas 77380
(281) 363-0888
FAX (281) 367-0888

© COPYRIGHT
MARK W. TODD ARCHITECTS, INC.
THIS DOCUMENT AND SPECIFICATIONS ARE THE PROPERTY AND CONTROLLED BY THE ARCHITECT AND SHALL NOT BE USED OR REPRODUCED IN ANY MANNER WITHOUT THE WRITTEN PERMISSION OF THE ARCHITECT. ANY REPRODUCTION OR TRANSMISSION OF THIS DOCUMENT OR INFORMATION CONTAINED HEREIN WITHOUT THE WRITTEN PERMISSION OF THE ARCHITECT SHALL BE PROHIBITED. THE ARCHITECT SHALL BE RESPONSIBLE FOR THE ACCURACY OF THE INFORMATION CONTAINED IN THIS DOCUMENT.

CONSTRUCTION

11-14-2003

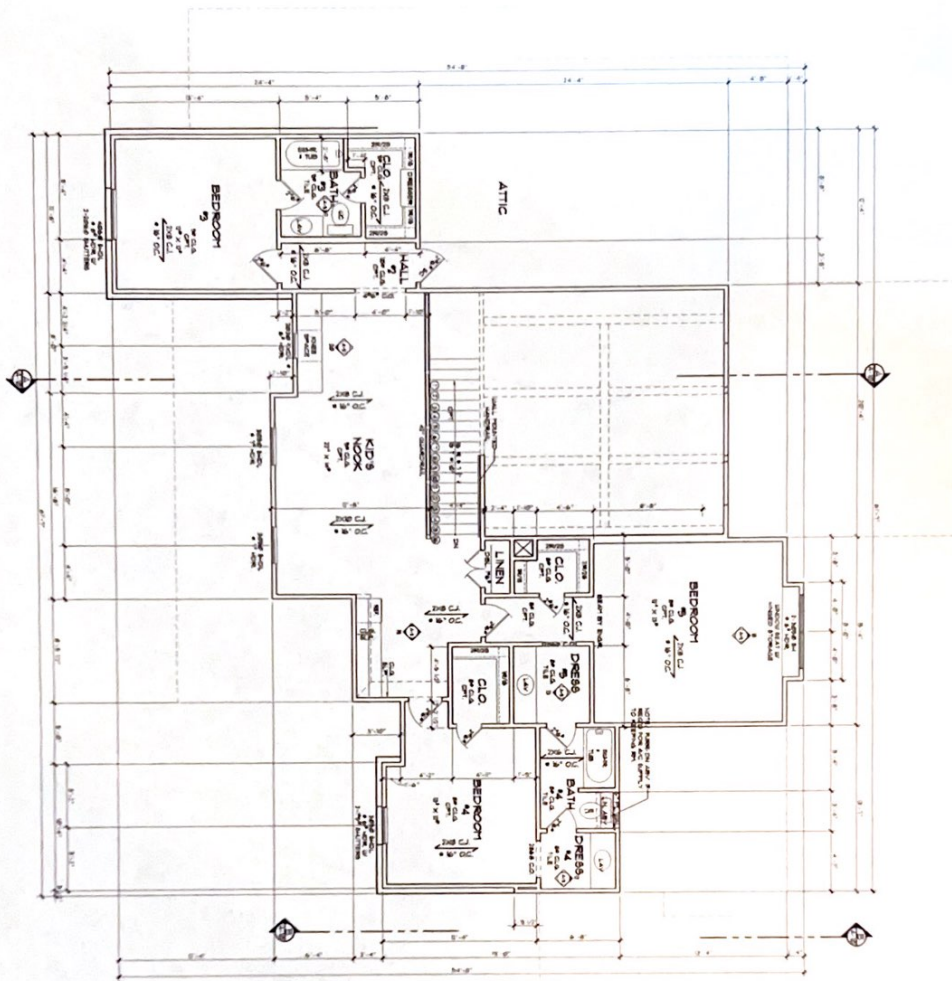

SECOND FLOOR PLAN
SCALE: 1/4" = 1'-0"

THESE PLANS SHALL COMPLY WITH THE PROVISIONS SET FORTH IN CHAPTER 11 OF THE INTERNATIONAL RESIDENTIAL CODE 2003.

A-3

Project #	110303R
Date	10/2/03
Client	MR. & MRS. AN
Site	...

A CUSTOM HOME FOR:
BRIAN
FORD
VILL OF HIGH MEADOW RANCH
LOT: 5 BLK: 1 SECT: 5-A

Mark W. Todd • Architects, Inc.
Architects • Planners • Consultants
1440 Lake Front Circle, Ste. 120
The Woodlands, Texas 77380
(281) 363-0200
FAX (281) 367-8888

© COPYRIGHT
MARK W. TODD ARCHITECTS, INC.
THIS DRAWING AND SPECIFICATIONS ARE
THE PROPERTY OF MARK W. TODD ARCHITECTS, INC.
NO PART OF THIS DRAWING OR SPECIFICATIONS
SHALL BE REPRODUCED OR TRANSMITTED IN ANY
FORM OR BY ANY MEANS, ELECTRONIC OR
MECHANICAL, INCLUDING PHOTOCOPYING, RECORDING,
OR BY ANY INFORMATION STORAGE AND RETRIEVAL
SYSTEM, WITHOUT PERMISSION IN WRITING FROM
MARK W. TODD ARCHITECTS, INC.

