


SCALE: 1" = 30'

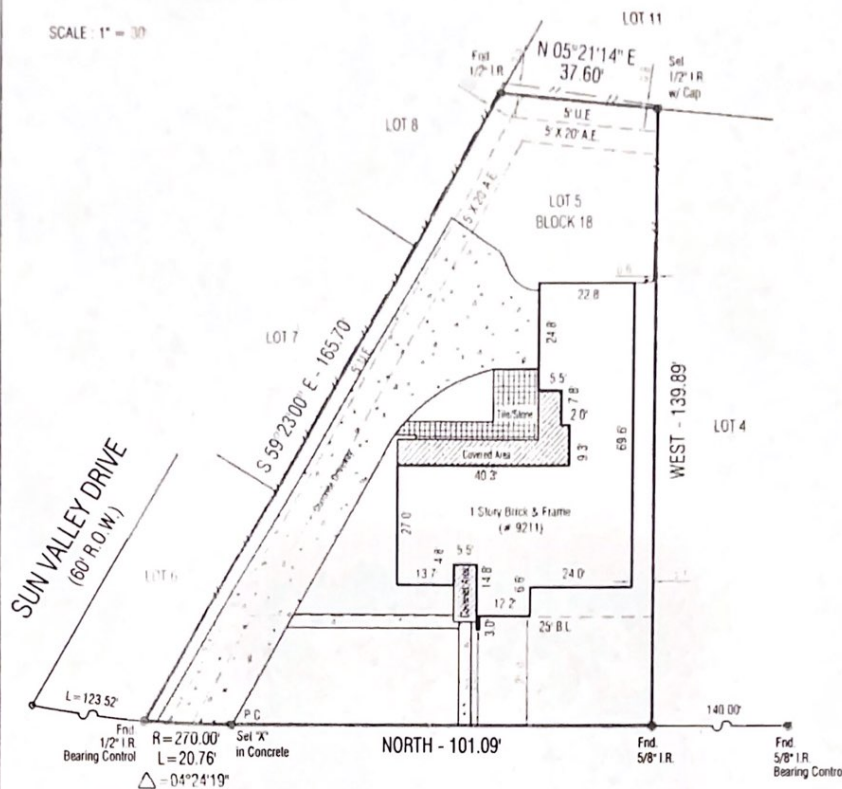

**ILONA LANE**  
(60' R.O.W.)

The subject is located within the City of Houston or within its extra territorial jurisdiction (within 5 miles of the City limits but outside another municipality). It is subject to the terms, conditions, and provisions of City of Houston Ordinance #85-1878, pertaining to among other things, the platting and replatting of real property and to the establishment of building lines (25 feet along major thoroughfares and 10 feet along other streets). A certified copy of said ordinance was filed for record on August 1, 1991 under H.C.C.F.No. N-253886.

**Note:**  
This survey was performed without benefit of a title commitment and may not show all deed restrictions, easements, building lines and other matters of record.

- Notes:**
- Basis for Bearings: RECORD PLAT
  - Distances shown are ground distances
  - All abstracting done by title company
  - All B.L.'s & U.E.'s taken from recorded plat unless otherwise noted
  - Dimension ties from improvements to property lines are calculated and should NOT be relied upon for construction and/or removal of any improvements including fences.
  - Building dimensions may not be used to calculate square footage
  - This property subject to any and all recorded and unrecorded easements. Surveyor has made no investigation or independent search for easements of record, encumbrances, restrictive covenants or ownership title evidence.

- LEGEND:**
- U.E. = Utility Easement
  - D.E. = Drainage Easement
  - B.L. = Building Line
  - G.E. = Guy Easement
  - I.R. = Iron Rod
  - I.P. = Iron Pipe
  - P.I.P. = Pinch Iron Pipe
  - P.P. = Power Pole
  - Sim S.E. = Storm Sewer Easement
  - San S.E. = Sanitary Sewer Easement
  - H.C.C.F.No. = Harris County Clerk File Number
  - //--- = Wood Fence
  - o--- = Chain Link
  - X--- = Barbed Wire
  - = Wrought Iron
  - = Overhead Powerline
  - \*--- = Power Pole

I hereby certify that this survey under my supervision was this day made on the ground and that this plat correctly represents the property legally described hereon (or on attached sheet). That the facts found at the time of this survey show the improvements and that there are no visible encroachments apparent on the ground, except as shown, to the best of my knowledge, surveyed 07-23-10

*Barry D. Adkins* 07/26/10

This survey is certified for this transaction only, is not transferable to additional institutions or subsequent owners. If this survey does not bear an original BLUE seal it is invalid and should not be relied upon for any purpose.

This property appears to be in an area of 500 year flood, area of 100 year flood with an average depth of less than 1 ft. or with drainage area less than 1 sq. mile or an area protected by levees from 100 year flood, and in insurance rate map zone shaded X as per map 48201C0870 L  
Dated 06-18-07

This determination to be used for flood insurance rate purposes ONLY and is NOT to be relied upon for ANY other purpose. Surveyor makes no representation as to whether property may Flood.

LOT: 5      BLOCK: 18      SUBDIVISION: WOODSIDE      SECTION: 3  
 RECORDATION: VOL. 51, PG. 3 OF MAP RECORDS      COUNTY: HARRIS      STATE: TEXAS  
 ADDRESS: 9211 ILONA LANE      CITY: HOUSTON      LEADER: N/A  
 PURCHASER:      TITLE COMPANY: N/A      G.F. # N/A

**DaRam Engineers, Inc.**

14201 Springwood Drive, Suite 200  
 Houston, Texas 77081  
 (713) 528-1527 FAX (713) 529-8096

SURVEYED BY: EP  
 DRAWN BY: abc  
 DRAWING NO: ILONA 9211