



The Conway V Plan 2665

2833 SQUARE FEET


BUILT AS OPPOSITE HAND

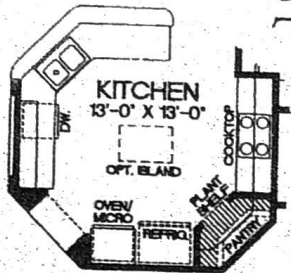

OPTIONAL KITCHEN

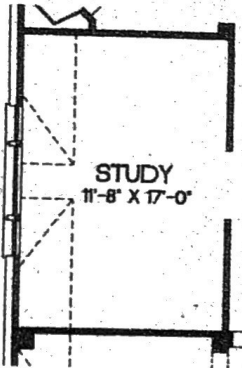


OPTIONAL STUDY

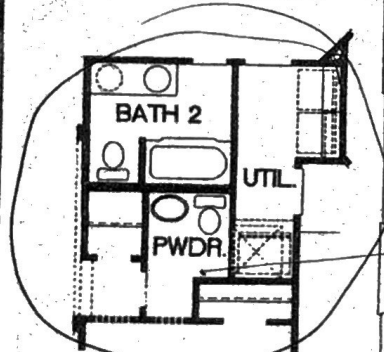

OPTIONAL BATH 2 and POWDER

AS BUILT -

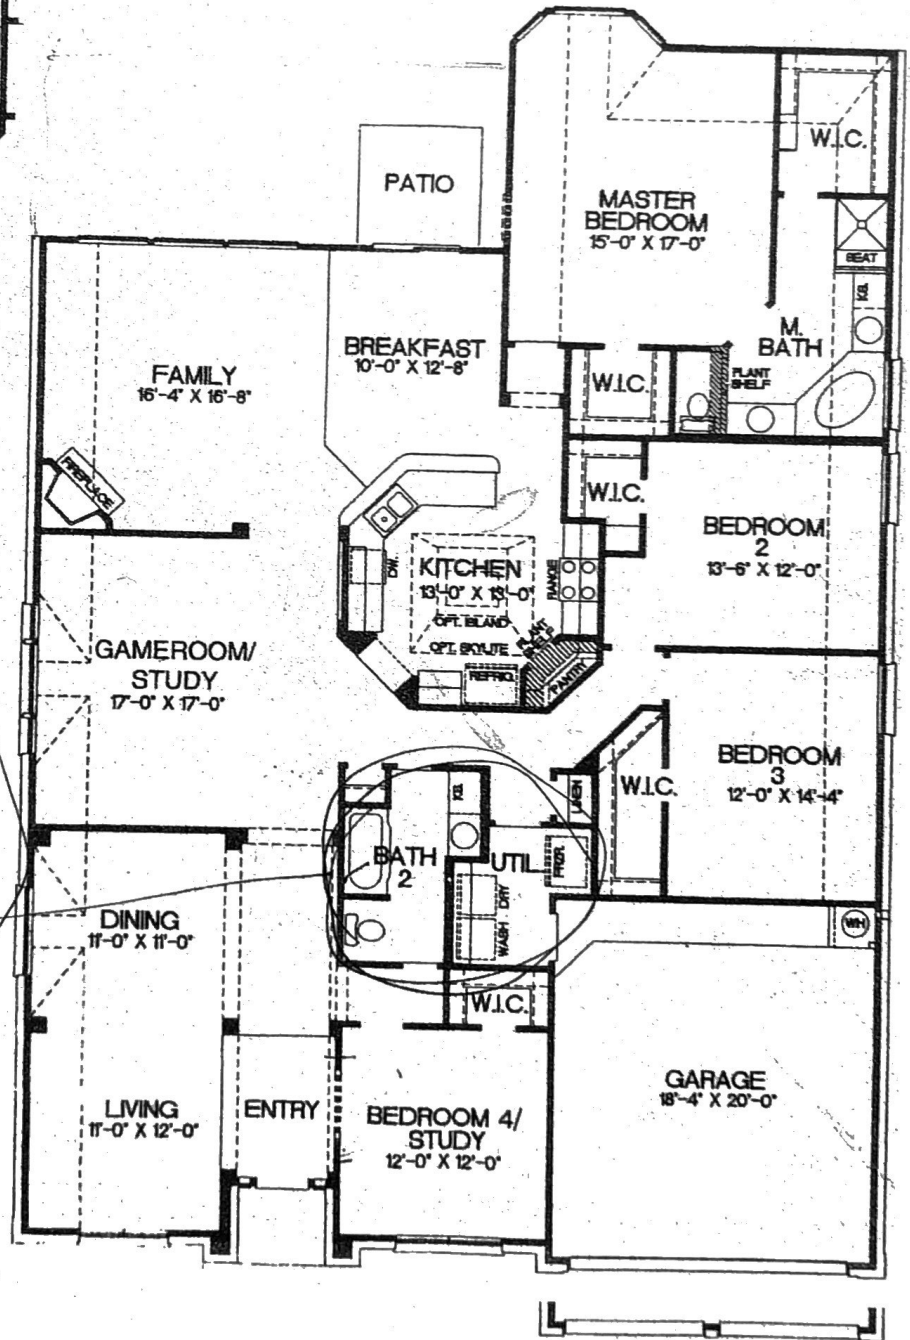


LEGACY HOMES
 A HERITAGE CO.
 www.legacy-homes.com

Room dimensions are approximate and may vary. Prices, products and specifications subject to change without notice. Legacy Homes designs are copyrighted and all rights reserved. © Legacy Homes, Inc. All rights reserved. Legacy Homes designs and are not responsible for the name of the builder shown.


The Conway V Plan 2665

2833 SQUARE FEET


BUILT AS OPPOSITE HAND

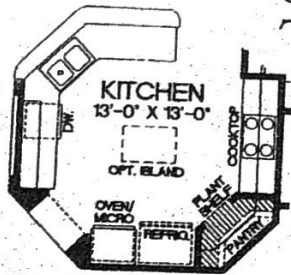

OPTIONAL KITCHEN

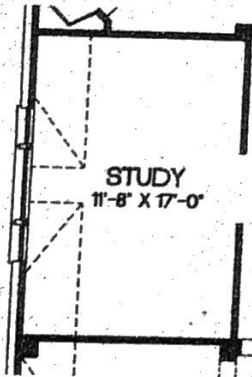

OPTIONAL STUDY

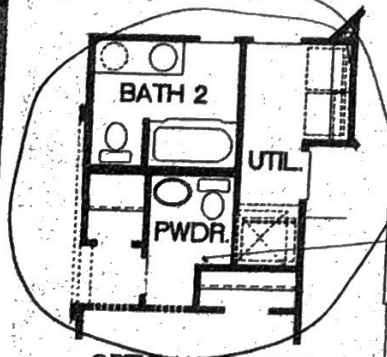

OPTIONAL BATH 2 and POWDER

AS BUILT.

