

ORDERED BY:



1177 West Loop South #1350 Houston, TX 77027
(713) 840-0208

POWERED BY
STARS
SURVEY TRACKING
AND
RETRIEVAL SYSTEM
www.surveystars.com



PROPERTY ADDRESS: 110 E 24TH STREET HOUSTON, TEXAS 77008


SURVEY NUMBER: 1409.0980

FIELD WORK DATE: 9/11/2014 REVISION DATE(S): (REV.1 9/15/2014)


NOTE: PROPERTY SUBJECT TO TERMS,
CONDITIONS, AND EASEMENTS
CONTAINED IN INSTRUMENT RECORDED IN
VOL. 557, PG. 55, C.F. NO(S). V620908, V719174



SCALE: 1" = 20'

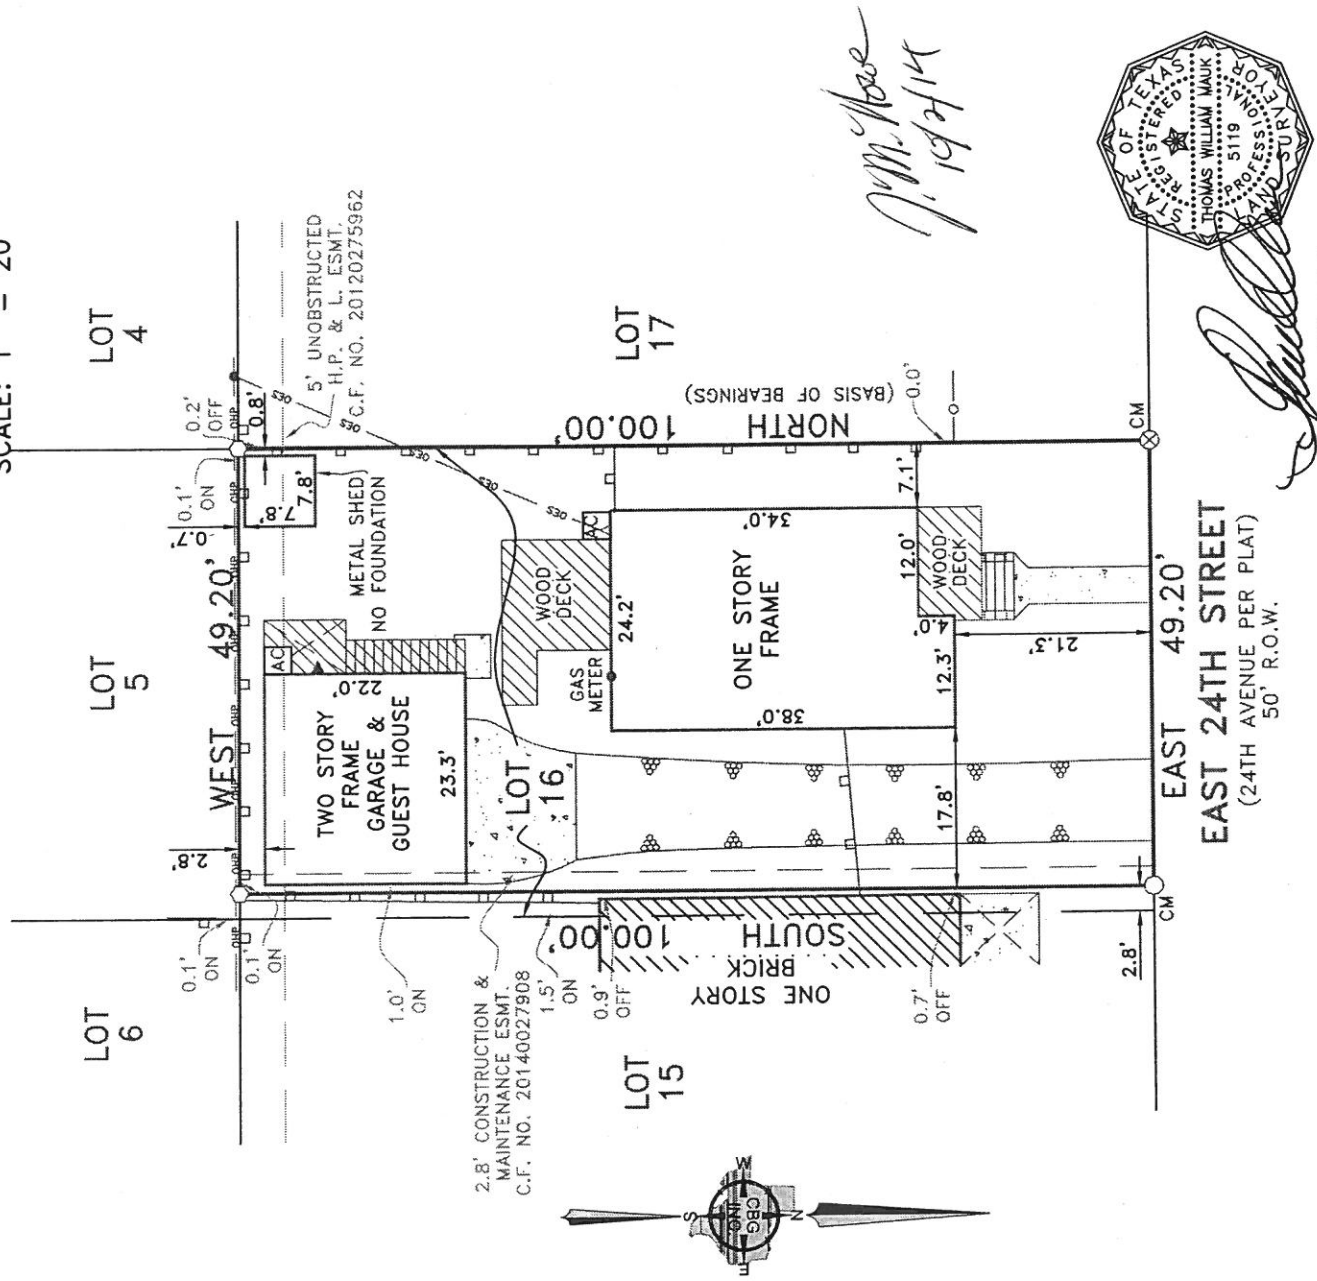

J.M. Howe
9/14/14

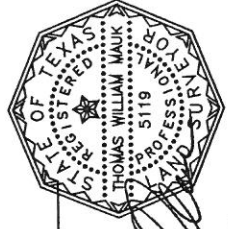

Use of This Survey for Purposes other than Intended, Without Written Verification, will be at the User's Sole Risk and Without Liability to the Surveyor. Nothing hereon shall be Construed to Give ANY Rights or Benefits to Anyone Other than those Certified.

FLOOD INFORMATION:

POINTS OF INTEREST
NONE VISIBLE

CLIENT NUMBER: 1415399

DATE: 9/15/2014

BUYER: Jamie Howe, Jr

SELLER: J. M. HOWE AND MARTHA K. HOWE

CERTIFIED TO: JAMIE HOWE JR; FRONTIER TITLE; FIRST AMERICAN TITLE INSURANCE COMPANY; NETWORK FUNDING LP

This is page 1 of 2 and is not valid without all pages.



Exacta Texas Surveyors
www.exacta365.com

EXACTA
TEXAS SURVEYORS, INC.

LB# 101739-00
www.exacta365.com
P 281.763.7766
F 281.763.7766
250 W. OHL LANE
Clear Creek, TX 75812

LEGAL DESCRIPTION:

THE WEST 49.2 FEET OF LOT 16, BLOCK 1, MILROY PLACE ADDITION, A SUBDIVISION IN HARRIS COUNTY, TEXAS, ACCORDING TO THE MAP OR PLAT THEREOF RECORDED IN VOLUME 557, PAGE 55, OF THE DEED RECORDS OF HARRIS COUNTY, TEXAS.












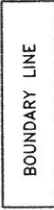







JOB SPECIFIC SURVEYOR NOTES:

GENERAL SURVEYOR NOTES:

- The Legal Description used to perform this survey was supplied by others. This survey does not determine or imply ownership.
- The survey only shows improvements found above ground, Underground footings, utilities and encroachments are not located on this survey map.
- This survey is exclusively for the use of the parties to whom it is certified.
- Additions or deletions to this survey map and report by other than the signing party or parties is prohibited without written consent of the signing party or parties.
- Dimensions are in feet and decimals thereof.
- Any FEMA flood zone data contained on this survey is for informational purposes only. Research to obtain such data was performed at www.fema.gov.
- All corners marked as set are at minimum of 1/2" diameter, 12" iron rebar with a yellow cap stamped "CBG SURVEYING". Unless otherwise noted, an examination of the abstract of title was NOT performed by the signing surveyor to determine which instruments, if any, are affecting this property. The symbols reflected in the legend and on this survey may have been enlarged or reduced for clarity. The symbols have been plotted at the center of the field location, and may not represent the actual shape or size of feature.
- Utilities shown on the subject property may or may not indicate the existence of recorded or unrecorded utility easements.
- The information contained on this survey has been performed exclusively, and is the sole responsibility, of Exacta Surveyors, Additional logo or references to third party firms are for informational purposes only.

LEGEND:

SURVEYOR'S LEGEND

	BOUNDARY LINE		STONE
	STRUCTURE		TILE
	CHAIN LINK		BRICK
	WOOD FENCE 0.5' WIDE TYPICAL		WOOD
	WOOD FENCE POST ONLY		CONCRETE
	IRON FENCE		COVERED AREA
	BARBED WIRE		
	PIPE FENCE		
	OVERHEAD ELECTRIC POWER		
	OVERHEAD ELECTRIC SERVICE		
	EDGE OF GRAVEL		
	EDGE OF ASPHALT		
	EASEMENT		
	CM CONTROLLING MONUMENT		
	AC AIR CONDITIONER		
	PE POOL EQUIPMENT		
	T TRANSFORMER PAD		
	FF FINISH FLOOR		
	CONCRETE MONUMENT		
	1/2" ROD FOUND		
	1/2" ROD SET		
	1" PIPE FOUND		
	"X" FOUND/SET		
	60d NAIL FOUND		
	FENCE POST FOR CORNER		
	BRICK/STONE COLUMN		
	POWER POLE		
	UNDERGROUND ELECTRIC		
	OVERHEAD ELECTRIC		
	FIRE HYDRANT		
	LP GAS LIGHT POLE		

ELECTRONIC SIGNATURE:

In order to "Electronically Sign" all of the PDFs sent by STARS, you must use a hash calculator. A free online hash calculator is available at <http://www.fileformat.info/tool/md5sum.htm>. To Electronically Sign any survey PDF: 1. Save the PDF onto your computer. 2. Use the online tool at <http://www.fileformat.info/tool/md5sum.htm> to browse for the saved PDF on your computer. 3. Select the Hash Method as SHA. 4. Click Submit. Your PDF is electronically signed if all of the characters in the SHA-1 code submitted by STARS matches the code which is produced by the hash calculator. If they match exactly, your PDF is electronically signed. If the codes do not match exactly, your PDF is not authentic.

PRINTING INSTRUCTIONS:

- While viewing the survey in Adobe Reader, select the "Print" button under the "File" tab.
- Select a printer with legal sized paper.
- Under "Print Range", click select the "All" toggle.
- Under the "Page Handling" section, select the number of copies that you would like to print.
- Under the "Page Scaling" selection drop down menu, select "None."
- Uncheck the "Auto Rotate and Center" checkbox.
- Check the "Choose Paper size by PDF" checkbox.
- Click OK to print.


TO PRINT IN BLACK + WHITE

- In the main print screen, choose "Properties".
- Choose "Quality" from the options.
- Change from "Auto Color" or "Full Color" to "Gray Scale".

OFFER VALID ONLY FOR:

Jamie Howe, Jr

POWERED BY

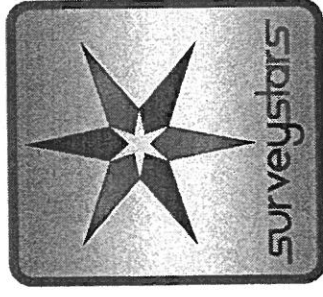

www.surveystars.com

EXACTA

Exacta Texas Surveyors, Inc.

LB# 101739-00

www.exacta365.com
P. 381.763.7766
F. 381.763.7767
250 W. Oak Loop
Cedar Creek, TX 78612