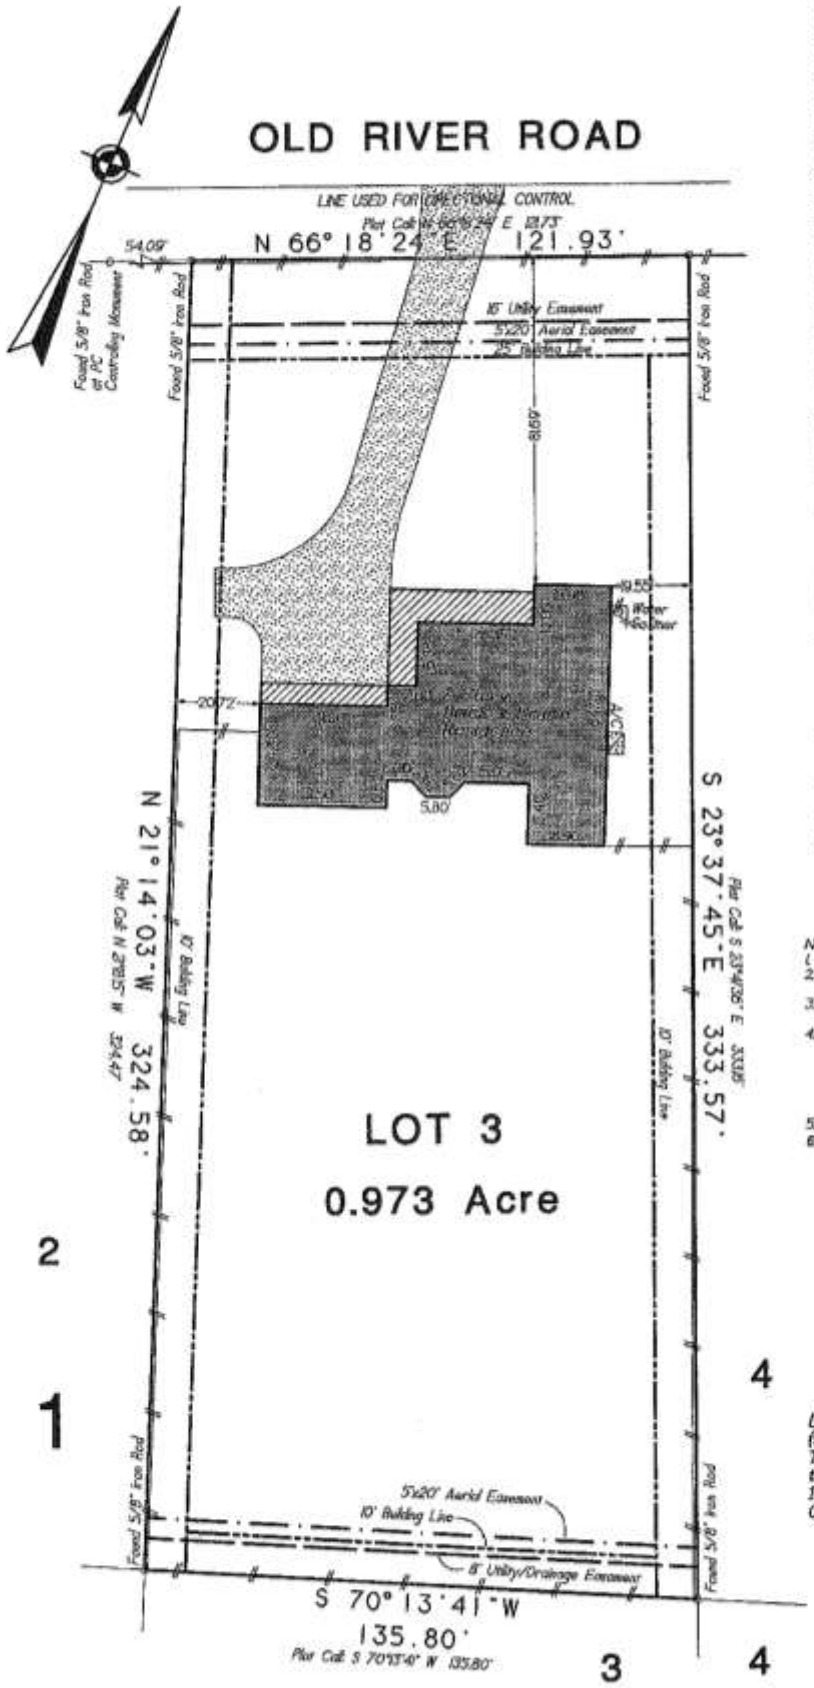

If this plat and accompanying description are not sealed with the raised embossing seal of R.P.L.S. whose signature appears on the raised seal and in red ink, it is considered a copy, and not a legal original. See Note 5 above.

Purchaser: Tracy O. Henderson and Gina L. Henderson
Address: 2054 Old River Rd.
Montgomery, TX 77356

GF No.: 983184

Date: March 30, 2007 (DG)
Job No.: 2007-043

To Prosperity Bank and First American Title Company

We, Glezman Surveying Inc., acting by and through Michael Glezman, a Registered Professional Land Surveyor in the State of Texas, hereby certify that this survey and professional service substantially conforms to the Texas Society of Professional Surveyors Standards and Specifications for a Category 1A, Condition II Survey.

© 2007 All Rights Reserved

RPLS #4627

Glezman Surveying Inc.
Surveying Southeast Texas since 1957
GLEZMAN SURVEYING, INC.
1938 Old River Road
Montgomery, Texas 77356
Office (936) 582-6340 www.glezmansurveying.com

NOTES:
1. Plat Scale: 1" = 30'
2. The bearings for this survey are based on the recorded plat as shown on this survey.
3. Roads dedicated by recorded plat unless otherwise noted
4. This plat of survey has been performed with reliance upon title examination and abstracting performed by First American Title Company under GF No.983184 with an effective date of 02/12/07. This surveyor has not abstracted the subject property.
5. 2-1/2' O.S.U. Co. Esmt. CF 986608 OPRMCT.
6. The professional service reflected on this plat of survey is provided in connection with the transaction anticipated by the title search referenced and dated above. It is not to be used for any other purpose. This original work is protected under copyright laws, Title 17 United States Code Sections 101 and 102. All violators will be prosecuted to the fullest extent of the law. This survey is being provided solely for the use of the recipients named below and no license has been created, expressed or implied, to copy the survey except as is necessary in conjunction with the original transaction, which shall take place within thirty (30) days from the date shown hereon.

Lot 3, of South Shore Estates, Section (5), a subdivision in Montgomery County, Texas, according to the map or plat thereof recorded in Cabinet H, Sheet 178B, of the Map Records of Montgomery County, Texas.