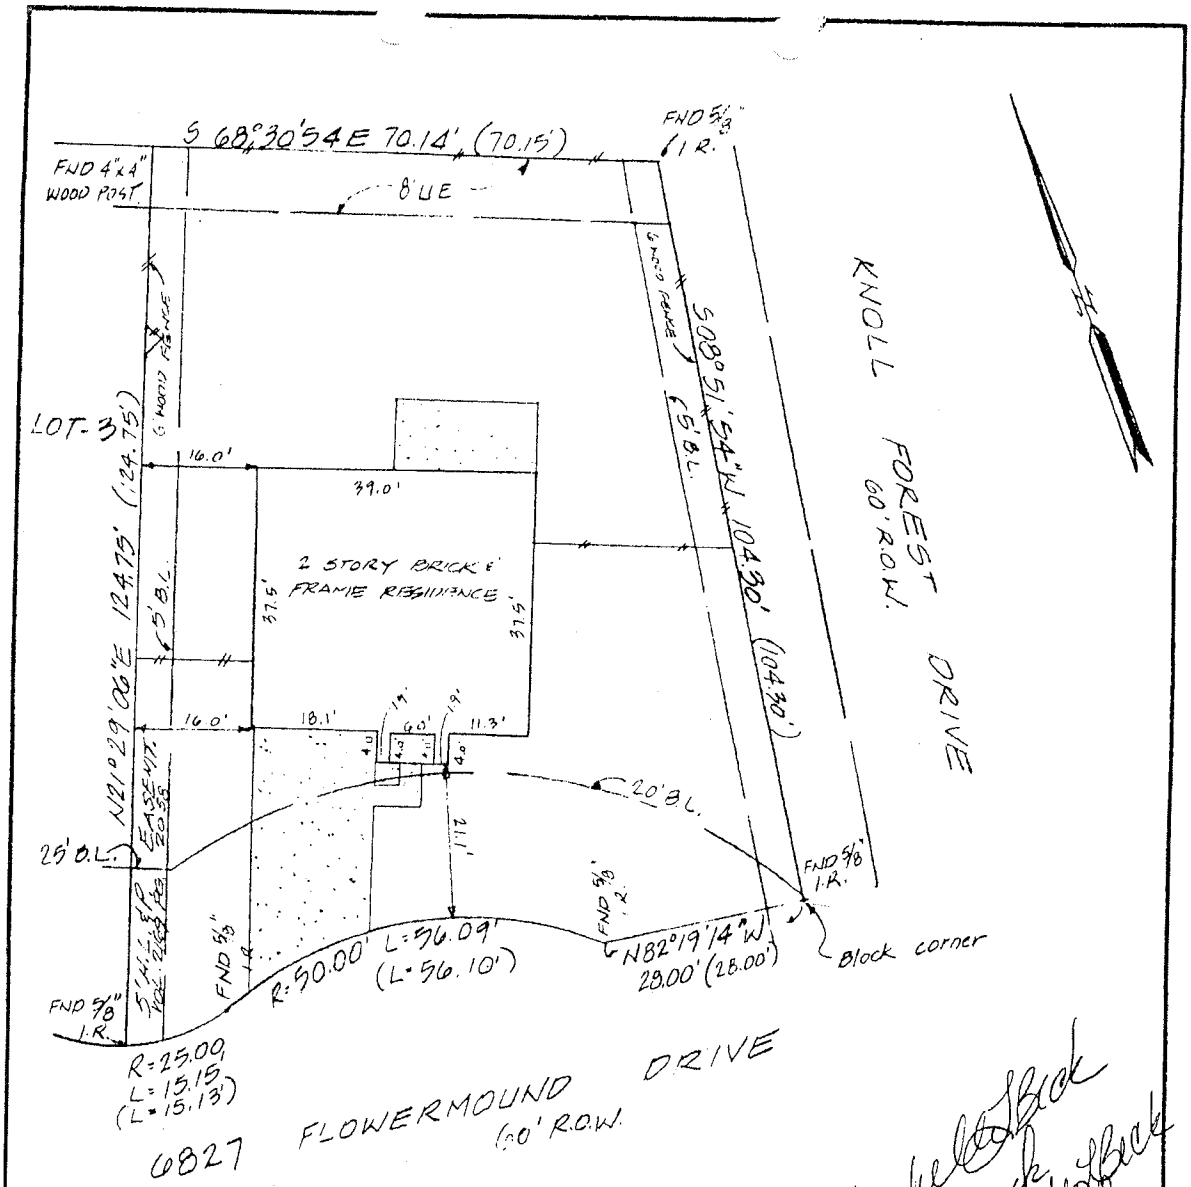

NOTE:

1. Distances shown in parentheses were measured on the ground.
2. The following flood information was received from Lichliter Jameson and Assoc. We are not responsible for its accuracy. Use it at your own risk.

100 YEAR FLOOD INFORMATION

F.I.R.M. #FBC.L.I.D #11 PANEL #

ZONE "B" DATE OF REVISION L.O.M.R. 7-6-89 SCALE 1"=20'

Michelle Beck
Doug Beck
Michelle Beck
Doug Beck

NOTE:
Agreement for underground/overhead electrical service easements granted to H.L.and P. File No. Vol 2140 Pg. 2302

Surveyed for HAMMONDS HOMES INC. on 9-17-91

Showing Lot 4 Block 4 of GREATWOOD KNOLL

Section 1 in FORT BEND County Texas according to the Map or Plat SLIDE No. 980 B, 981 A recorded in ~~Volume~~ ~~Page~~ of the PLAT records of FORT BEND County.

I hereby certify that this survey was made on the ground under my supervision and that it correctly represents the facts found at the time of survey. There was no encroachment apparent on the ground, except as shown hereon. This survey is for loan purposes only and is not to be recorded. Responsibility assumed only for easements clearly indicated on the recorded plat.

UPDATES	
DATE	INITIALS
12-2-91	

W. O. NO. 17636

G. F. NO. 91300896

George J. Gale

Buyer: DOUGLAS A BECK and MICHELLE L. BECK

Mortgage Co: GROUP AMERICA

Title Company: STEWART TITLE

STATE OF TEXAS REGISTERED GEORGE J. GALE 4678 PROFESSIONAL LAND SURVEYOR

Hoffman Surveying Company, Inc.

5245 LANGFIELD ROAD — HOUSTON, TEXAS 77040 — (713) 939-9100

Drawing 1/11