NOT FOR CONSTRUCTION

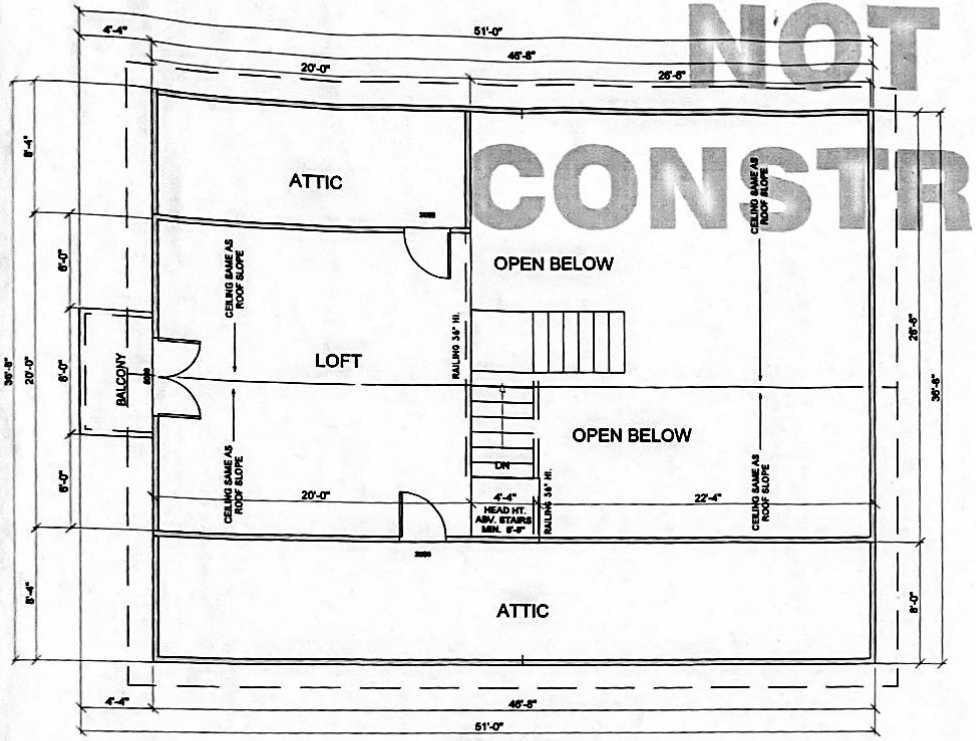

SECOND FLOOR

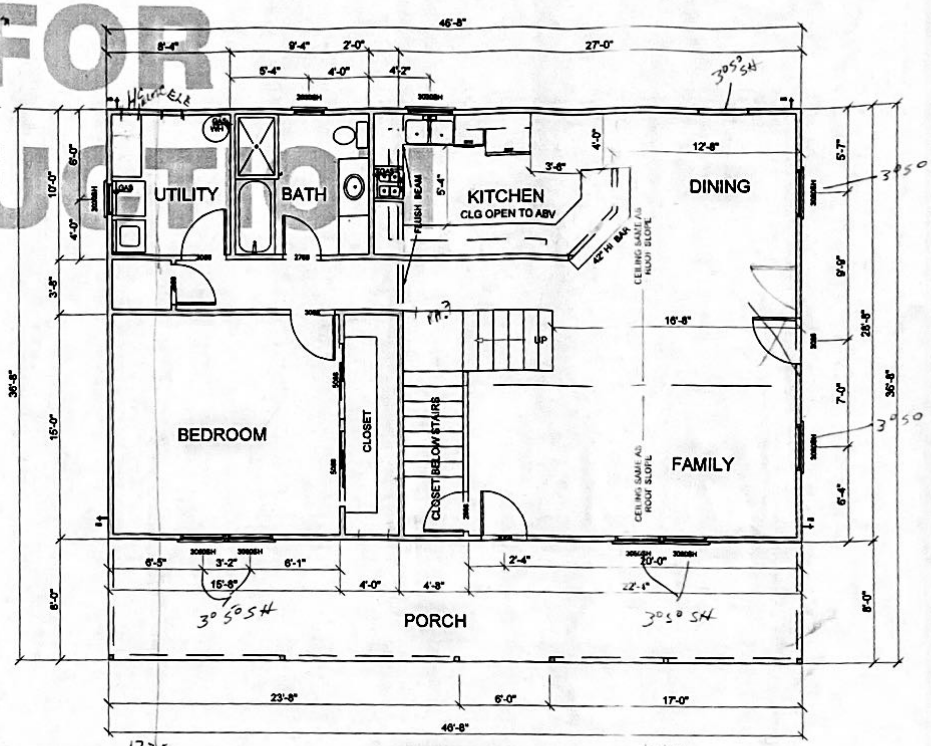

FIRST FLOOR

8' CEILINGS U.N.O.

1st FLOOR LIVING	~~1808~~ 1336 SQ FT
2nd FLOOR LOFT	433
TOTAL LIVING	~~2241~~ SQ FT
PORCH	373
BALCONY	35
TOTAL AREA	~~2649~~ SQ FT

All Electric

CARNES ENGINEERING, INC.
DESIGN
ENGINEERING
COMMERCIAL
RESIDENTIAL
INSPECTION
12888 I.H. 10 EAST
BAYTOWN, TEXAS 77521
(281) 385-1288 (281) 866-8828
INFO@CARNESINC.NET
WWW.CARNESENGINEERING.COM

LA COMBE RESIDENCE
2150 FM 1008
DAYTON, TEXAS
LIBERTY COUNTY

DRAWN BY: DATE: 08/05/2021
SCALE: 1/4" = 1'
REVISED BY: DATE:
CHECKED BY:MH DATE:
ENGINEER: D. SPENCER CARNES, P.E.
SEAL

DRAWING NUMBER
2 OF