SURVEY OF


ADDRESS: 23418 CANNONDALE LOOP
MONTGOMERY, TEXAS 77316

SITE: LOT 12 - BLOCK 2
HIGH MEADOW ESTATES SECTION 4

JOB NO: 1379-19 — *SCALE: 1" = 20'*
DATE: 6-24-19 — *SHEET 1 OF 1*

REVISIONS:

NO.	DATE	DESCRIPTION

SOUTH TEXAS SURVEYING ASSOCIATES, INC.
11281 Richmond Ave. Bldg J, Suite 101, Houston, Texas 77082
281-556-6918 FAX 281-556-9331
Firm Number: 10043400

Copyright 2019 South Texas Surveying Associates, Inc. K:\CONRES 2018\1438-18ZMI (PHH/BD)

JOB NO: 1379-19

NOTES:

1. BASIS OF BEARING IS THE SOUTHWEST ROWLINE OF CANNONDALE LOOP BEING S 61°58'06" E.
2. SURVEYOR DID NOT ABSTRACT PROPERTY. SURVEY BASED ON LEGAL DESCRIPTIONS SUPPLIED BY TITLE COMPANY, SURVEY AS SHOWN AND LEGAL DESCRIPTION AS PER AN ON THE GROUND SURVEY, EASEMENTS, BUILDING LINES, ETC., SHOWN ARE AS IDENTIFIED BY OF NO. ATCH1606027 OF ALAMO TITLE COMPANY.
3. NOTHING IN THIS SURVEY IS INTENDED TO EXPRESS AN OPINION REGARDING OWNERSHIP OR TITLE.
4. THE WORD CERTIFY IS UNDERSTOOD TO BE AN EXPRESSION OF PROFESSIONAL JUDGMENT BY THE SURVEYOR AND WHICH IS BASED ON HIS BEST KNOWLEDGE, INFORMATION AND BELIEF.
5. SURVEY IS CERTIFIED FOR THIS TRANSACTION ONLY.
6. THE FINDINGS AND OPINIONS OF SOUTH TEXAS SURVEYING ASSOCIATES, INC. REFLECTED HEREON ARE PRIVILEGED, CONFIDENTIAL AND INTENDED FOR THE USE OF THE INDIVIDUAL OR ENTITY FOR WHOM THIS WORK WAS PREPARED. IT IS UNDERSTOOD THAT THE USE OF, RELIANCE ON, OR REPRODUCTION OF SAME, IN WHOLE OR IN PART, BY OTHERS WITHOUT THE EXPRESS WRITTEN CONSENT OF SOUTH TEXAS SURVEYING ASSOCIATES, INC. IS PROHIBITED AND WITHOUT WARRANTY, EXPRESS OR IMPLIED. SOUTH TEXAS SURVEYING ASSOCIATES, INC. SHALL BE HELD HARMLESS AGAINST DAMAGES OR EXPENSES RESULTING FROM SUCH UNAUTHORIZED USE, RELIANCE OR REPRODUCTION. COPYRIGHT 2016. ALL RIGHTS RESERVED.
7. THERE IS A BLANKET, NOT PLOTTABLE, 10' WIDE MID-SOUTH ELECTRIC COOPERATIVE ASSOCIATION EASEMENT CENTERED ON ELECTRICAL SERVICE FACILITIES AS INSTALLED.

FLOOD NOTE:

PROPERTY LIES WITHIN FLOOD ZONE "X", ACCORDING TO F.I.R.M. MAP NO. 48339C 0395G DATE 08-18-2014 BY GRAPHING PLOTTING ONLY, WE DO NOT ASSUME RESPONSIBILITY FOR EXACT DETERMINATION.

BEFORE ANY DEVELOPMENT PLANNING, DESIGN, OR CONSTRUCTION IS STARTED, THE COMMUNITY, CITY AND COUNTY FLOODWAY AREAS THAN SHOWN BY F.I.R.M. MAPS THAT WILL AFFECT DEVELOPMENT.

SURVEYORS CERTIFICATION

PROPERTY SUBJECT TO CITY ORDINANCES AND SUBDIVISION COVENANTS, CONDITIONS AND RESTRICTIONS.
I hereby certify that this survey was made on the ground and that this plat correctly represents the facts found at the time of survey showing any improvements, from legal descriptions supplied by client. There are no encroachments apparent on the ground, except as shown. This survey is only certified for boundary and this transaction only. Surveyor did not abstract properly. Easements, building lines, etc. shown are as identified by:
GF ATCH1606027 of ALAMO TITLE COMPANY

Fred W. Lawton, Registered Professional Land Surveyor No. 2321
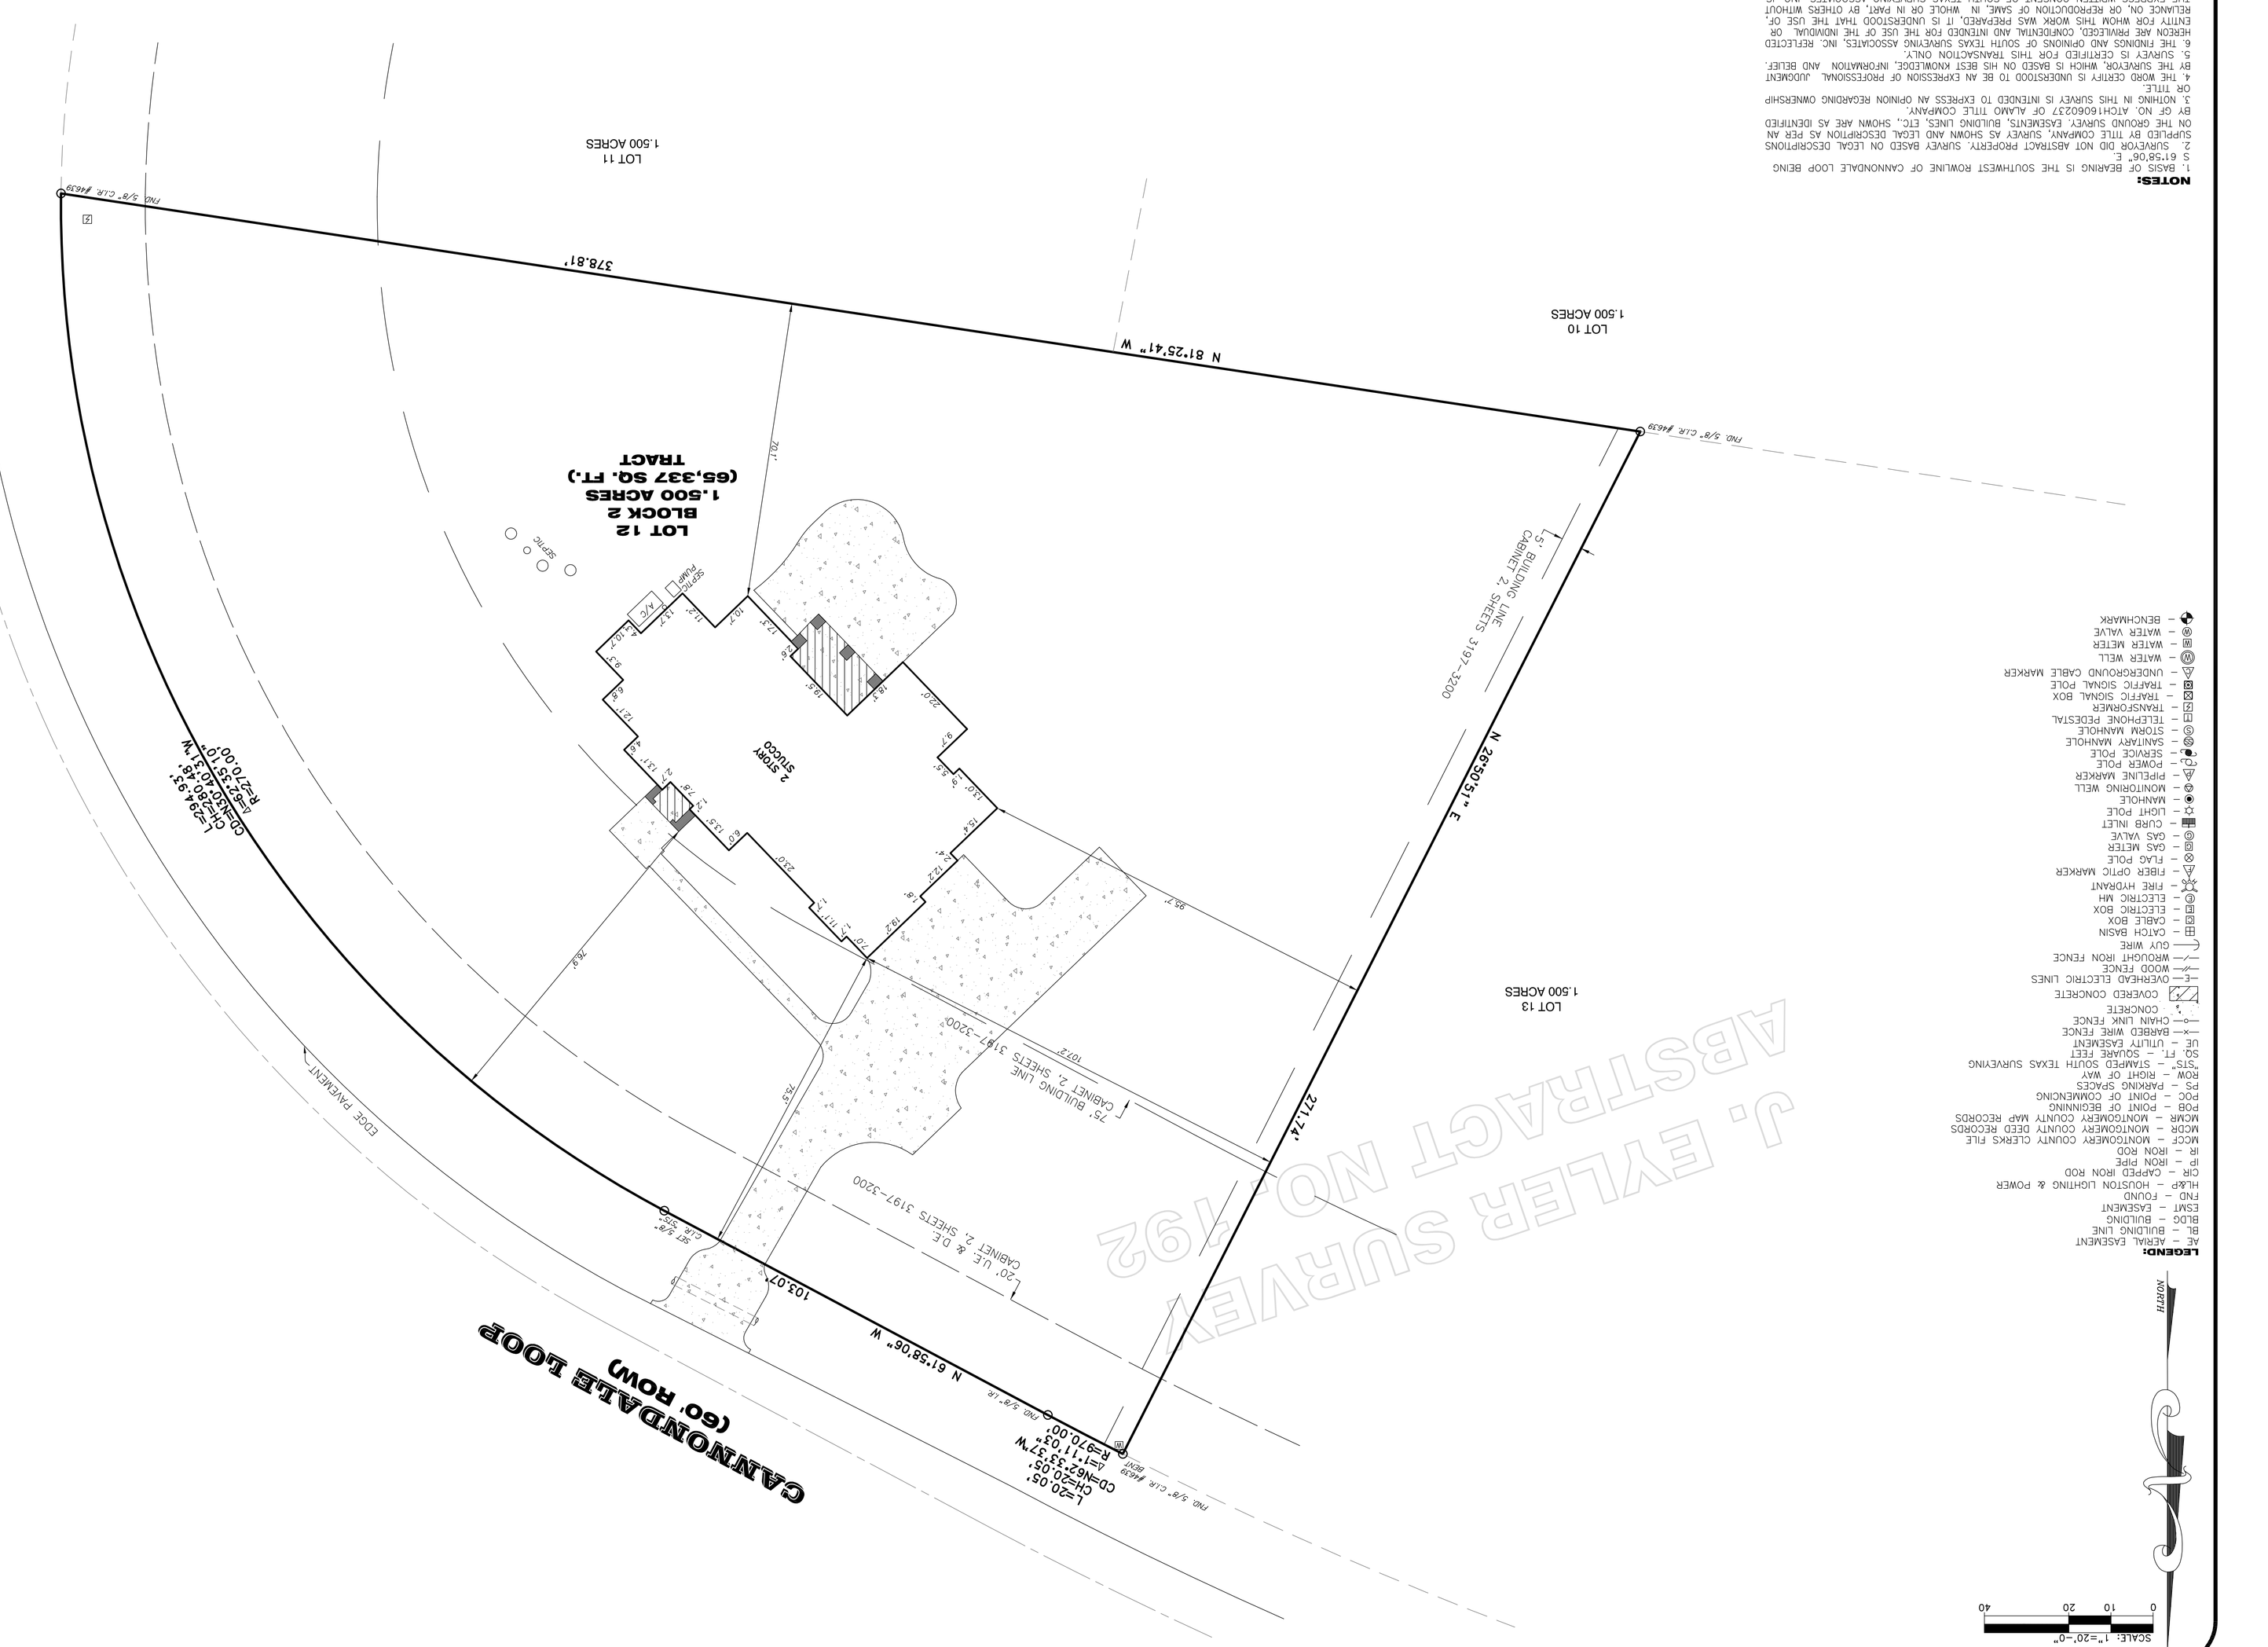
STATE OF TEXAS — REGISTERED — FRED W. LAWTON — 2321 — PROFESSIONAL LAND SURVEYOR