

November 29, 2021

Mr. John Mangiameli
Chief Building Official
City of Conroe
300 W. Davis
P.O. Box 3066
Conroe, Texas 77305

**RE: Review 5 of Submittal of Plan
(Evergreen Design Group)
Beasley Duplexes
2887 Beasley Rd. Conroe, TX
CL-21-012881**

Dear Mr. Mangiameli:

At your request, we have re-reviewed the forth submittal of Tree Preservation Plans for the 1.01 Acres proposed duplex commercial project in the Olivia Subdivision in Conroe, TX. The Landscape Plans were stamped 11/22/2021 by Eric M. Shepley, RLA. Affidavit was signed by Ryan Brizgis, CWOS contractor. (Reference marked up plans):

1. Tree Preservation – One trees can be given credit for 1,200sf (2.73%).
 - a. One 20" Maple given 1,200sf (2.7%)
 - b. One tree >30% CRZ impact
 - c. Three trees in frontage U.E.
2. Landscape Plan – Planted Trees
 - a. 18 trees are scheduled to be planted for 12,100 sf canopy credit (27.5%)
 - b. 9/18 (50%) evergreen. 11/18 (61%) large growth. Ratios met.
 - c. Two 4" trees were provided for parking lot requirement.
3. Other
 - a. 6 ft high opaque fence adjacent to residential on both sides provided on plans and referred to civil plans



A total of 30.2% canopy cover is met with the plans.
Therefore, the plans submitted were determined to be **COMPLIANT** to the requirements of the Tree Canopy Ordinance.

Respectfully,

Michael Gabrielse

Michael Gabrielse
Urban Forester, ISA Cert. Arborist

Enclosure: Markup of Review of Submittal of Plans



CITY OF CONROE

CLEARING PERMIT APPLICATION

Regardless of whether or not trees are being removed or cleared, this application must be filled out for any new commercial development; residential subdivision development; or for parking lot additions and commercial building additions that expand the footprint by (30%) or more, or that add (3000) square feet of area to the existing parking lot or building.

Important Information

- An approved storm water pollution prevention plan (SWPPP) must be on file before a clearing permit will be issued for any site that is larger than 1 acre and regardless of property size, storm water pollution prevention controls must be implemented as soon as practical after a site has been cleared.
- No clearing shall take place without an approved clearing permit and protection fencing installed.
- No clearing shall take place in the 1 percent annual chance flood zone (100 year flood plain) without a flood plain permit on file.
- Clearing permits expire 60 days from the date of issue.
- The information provided herein is intended as a guide and is not a comprehensive list of requirements. Please refer to Chapter 102 of the Conroe Code of Ordinances for complete details.

Checklist

- Clearing plans (two hard copies and one digital PDF) Clearing plans shall contain all of the following:
 - Tree analysis/Inventory with calculations showing ordinance compliance.
 - Complete site plan showing structure placement and setbacks.
 - A site survey showing limits of the proposed clearing, with specific site details including all easements, Right-of-Way's, and any applicable tree preservation zones.
 - Flood plain information/limits if present.
- A one year performance bond made to the City of Conroe in the amount of: the lesser of \$1.50 per square foot of required canopy, or \$50,000.
- Non-Refundable permit fee in the amount set forth in Appendix A of the Conroe Code of Ordinances.
- Affidavit from the individual of record. (Page 3 of this application)

PROJECT NAME AND LOCATION

Project Name: **Beasley Duplexes**

911 Assigned Address: **2887 Beasley Road, Conroe, TX 77301**

Legal Description: **Lot 2, Block 1, Olivia Subdivision, Montgomery County, TX**

OWNER or OWNER'S AGENT INFORMATION

Name: **WERE Property Holdings, LLC**

Phone: **917-482-5894**

Address: **5403 Evergreen Valley Dr.**

City: **Houston**

Zip: **77345**

Email: **djedwards83@gmail.com, kwasserman@gmail.com**

LANDSCAPE ARCHITECT INFORMATION

Name: **LJA Engineering**

Phone: **713-341-8081**

Address: **1904 W Grand Parkway N, Suite 100**

City: **Katy**

Zip: **77449**

Email: **jpasquarelli@gmail.com, rodney@evergreendesigngroup.com**

DETAILED PROJECT INFORMATION

Briefly describe project: **Low Density multi-family comprised of five duplexes**

Existing Developed Acres: **0**

Undeveloped Forested Acres: **0**

Undeveloped Previously Cleared Acres: **1.01**

TOTAL SITE ACREAGE: **1.01**

Type of Project: Multi-Family Commercial Residential Subdivision Other:

If this is an existing site where a parking lot addition and/or a building addition is proposed please indicate the percent and square footage of each addition: _____ % ; _____ ft² of expansion to existing site/structure.

If this is a residential development please indicate the total number of lots:

TREE/CANOPY PRESERVATION INFORMATION

Fill out one or the other of the following two sections but not both.

I have determined I **can** preserve the mandatory 1/3 of the required 30% or 20% tree canopy as required by the Ordinance and will meet the total canopy requirement by one or a combination of the following:

I will be preserving **6** # of trees; Removing **4** # of trees; Replanting **18** # of trees;

I will be preserving **30.3** % of tree canopy; Paying mitigation fees in the amount of \$ **0**


I have determined I **cannot** preserve the mandatory 1/3 of the required: 30% or 20% tree canopy as required by the Ordinance and I am requesting an exception for the following reason(s):

less than 2 Acres; exempt from 1/3 preservation requirement

Although I cannot preserve the mandatory 1/3 of the required canopy, I will achieve the total canopy requirement by one or a combination of the following:

I will be preserving **1 credit tree** # of trees; Removing **4** # of trees; Replanting **18** # of trees;

I will be preserving **2.7%** of tree canopy; Paying mitigation fees in the amount of \$ **0.00**

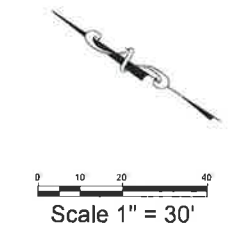

FLOODPLAIN INFORMATION:
 THE FEDERAL EMERGENCY MANAGEMENT AGENCY'S FLOOD INSURANCE RATE MAP FOR THE CITY OF CONROE, MONTGOMERY COUNTY, TEXAS AND INCORPORATED AREAS, COMMUNITY NO. 480484, DATED AUGUST 18, 2014, INDICATES THAT THIS TRACT IS WITHIN ZONE "X" UNSHADED, AREAS DETERMINED TO BE OUTSIDE THE 0.2% ANNUAL CHANCE FLOODPLAIN, AS SHOWN ON MAP AND PANEL NO. 48330C0385G. THIS DETERMINATION HAS BEEN MADE BY SCALING THE PROPERTY ON THE ABOVE REFERENCED MAP AND IS NOT THE RESULT OF AN ELEVATION SURVEY. WARNING: IF THIS SITE IS NOT WITHIN AN IDENTIFIED SPECIAL FLOOD HAZARD AREA, THIS STATEMENT DOES NOT IMPLY THAT THE PROPERTY AND/OR THE STRUCTURES THEREON WILL BE FREE FROM FLOODING OR FLOOD DAMAGE. ON RARE OCCASIONS, GREATER FLOODS CAN AND WILL OCCUR AND FLOOD HEIGHTS MAY BE INCREASED BY MAN-MADE OR NATURAL CAUSES. THIS FLOOD STATEMENT SHALL NOT CREATE LIABILITY ON THE PART OF THE SURVEYOR.

BENCHMARKS:
 CITY OF CONROE BENCHMARK "CC-4" BEING A BRASS DISK IN CONCRETE ALONG THE EAST SIDE OF NORTH FRAZIER STREET (STATE HIGHWAY 75) BETWEEN WOODLAND HILLS DRIVE AND LEAGUE LINE ROAD IN FRONT OF EASTERN TRANSMISSION CORP. CONROE MAINTENANCE HEADQUARTERS AT 3700 NORTH FRAZIER STREET. (NAVD 88) ELEV.=284.24

TEMPORARY BENCHMARK:
 RAILROAD SPIKE IN POWER POLE ALONG THE NORTH RIGHT-OF-WAY LINE OF BEASLEY ROAD APPROXIMATELY 25' ± SOUTHWEST OF THE COMMON SOUTHERLY CORNER OF LOTS 1 AND 2, BLOCK 1, OLIVA SUBDIVISION, AS SHOWN ON SURVEY. (NAVD 88) ELEV.=228.08

NOTE:
 IN CASE OF CONFLICT BETWEEN DETAILS SHOWN ON THIS SHEET AND THE CITY OF CONROE DESIGN STANDARDS, THE MORE STRINGENT SHALL APPLY.



DATE	REVISION
11-22-21	


CITY OF CONROE
 MONTGOMERY COUNTY, TEXAS

BEASLEY ROAD DUPLEX

LANDSCAPE PLANTING

LJA Engineering Inc.
 1804 W. Grand Pkwy N. Phone 713.953.5200
 Suite 100 Houston, TX 77042 Fax 713.953.5025
 Katy, Texas 77449 FRN - F-1386

LJA PROJECT NO.: 2844-0001
 SCALE: 1"=20'
 DATE: July 30, 2021 SHEET NO. LP-1

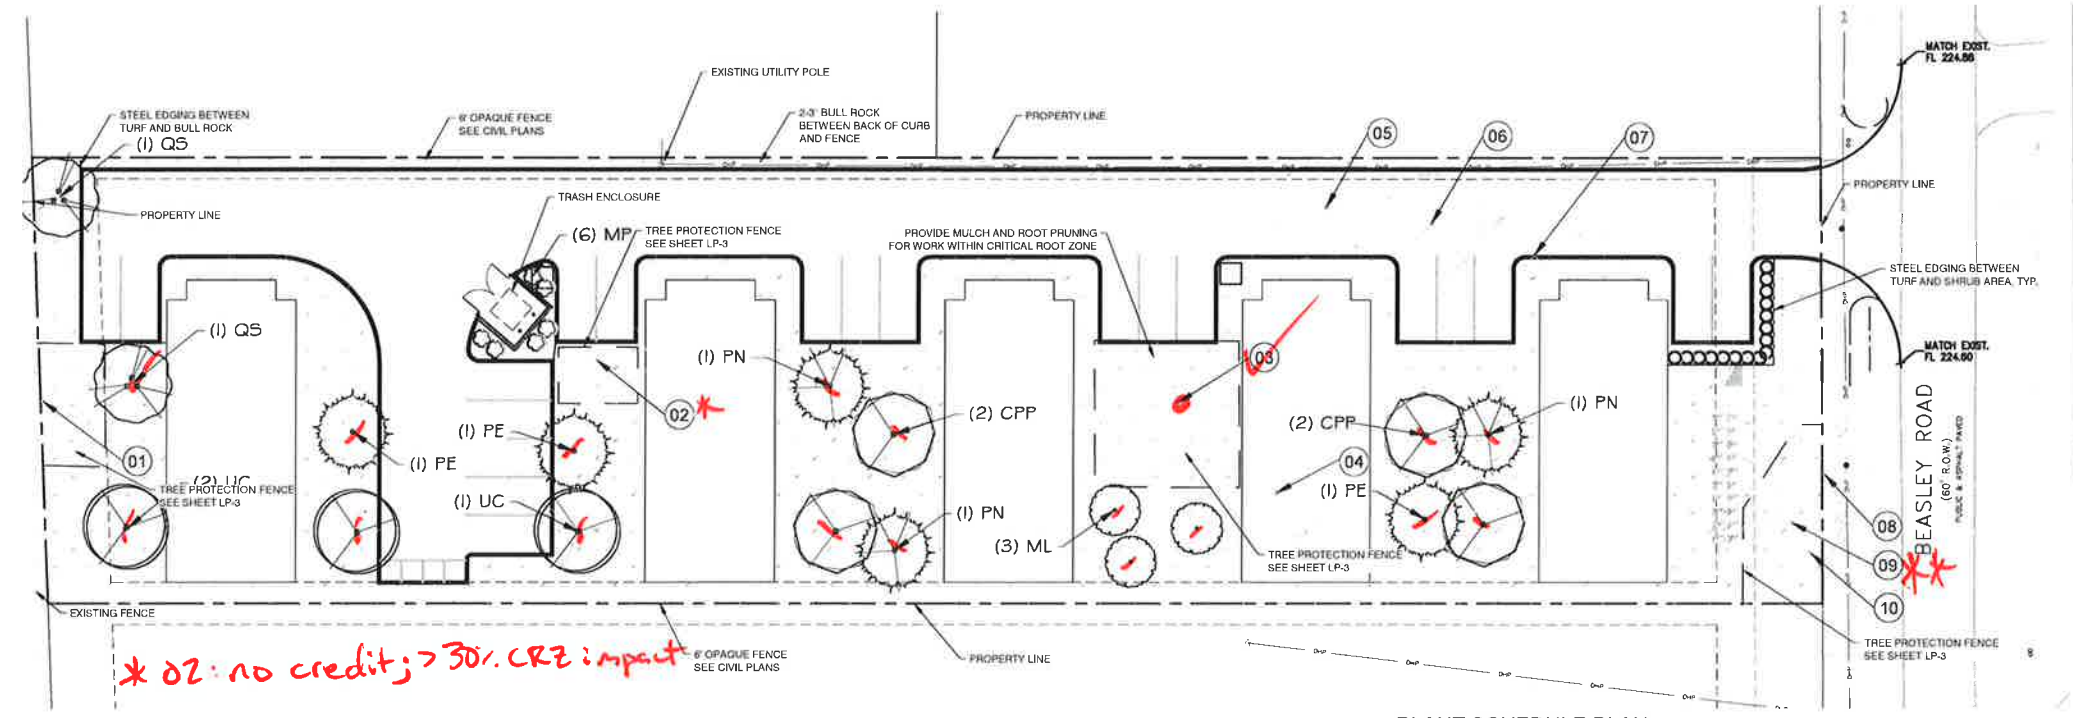

*** 08, 09, 10: in easement, no credit*

** 02: no credit; > 30% CRZ impact*

GENERAL GRADING AND PLANTING NOTES

- BY SUBMITTING A PROPOSAL FOR THE LANDSCAPE PLANTING SCOPE OF WORK THE CONTRACTOR CONFIRMS THAT HE HAS READ AND WILL COMPLY WITH THE ASSOCIATED NOTES, SPECIFICATIONS AND DETAILS WITH THIS PROJECT.
- THE GENERAL CONTRACTOR IS RESPONSIBLE FOR REMOVING ALL EXISTING VEGETATION (EXCEPT WHERE NOTED TO REMAIN).
- IN THE CONTEXT OF THESE PLANS, NOTES, AND SPECIFICATIONS, FINISH GRADE REFERS TO THE FINAL ELEVATION OF THE SOIL SURFACE (NOT TOP OF MULCH) AS INDICATED ON THE GRADING PLANS.
- BEFORE STARTING WORK, THE LANDSCAPE CONTRACTOR SHALL VERIFY THAT THE ROUGH GRADES OF ALL LANDSCAPE AREAS ARE WITHIN +0.1' OF FINISH GRADE. SEE SPECIFICATIONS FOR MORE DETAILED INSTRUCTION ON TURF AREA AND PLANTING BED PREPARATION.
- CONSTRUCT AND MAINTAIN FINISH GRADES AS SHOWN ON GRADING PLANS, AND CONSTRUCT AND MAINTAIN SLOPES AS REQUIRED BY THE GEOTECHNICAL REPORT. ALL LANDSCAPE AREAS SHALL HAVE POSITIVE DRAINAGE AWAY FROM STRUCTURES AT THE MINIMUM SLOPE SPECIFIED IN THE REPORT AND ON THE GRADING PLANS AND AREAS OF POTENTIAL PONDING SHALL BE REGRADED TO BLEND IN WITH THE SURROUNDING GRADES AND ELIMINATE PONDING POTENTIAL.
- THE LANDSCAPE CONTRACTOR SHALL DETERMINE WHETHER OR NOT THE EXPORT OF ANY SOIL WILL BE NEEDED. (TAKING INTO ACCOUNT THE ROUGH GRADE PROVIDED, THE AMOUNT OF SOIL AMENDMENTS TO BE ADDED (BASED ON A SOIL TEST) FOR SPECIFICATIONS) AND THE FINISH GRADES TO BE ESTABLISHED.
- ENSURE THAT THE FINISH GRADE IN SHRUB AREAS IMMEDIATELY ADJACENT TO WALKS AND OTHER WALKING SURFACES AFTER INSTALLING SOIL AMENDMENTS IS 3" BELOW THE ADJACENT FINISH GRADE. IN ORDER TO ALLOW FOR PROPER MULCHING, FINISH THE SOIL SURFACE TO MEET FINISH GRADE. AS SPECIFIED ON THE GRADING PLANS, AT APPROXIMATELY 18" AWAY FROM THE WALKS.
- ENSURE THAT THE FINISH GRADE IN TURF AREAS IMMEDIATELY ADJACENT TO WALKS AND OTHER WALKING SURFACES AFTER INSTALLING SOIL AMENDMENTS IS 1" BELOW THE FINISH GRADE OF THE WALKS. TAPER THE SOIL SURFACE TO MEET FINISH GRADE AS SPECIFIED ON THE GRADING PLANS, AT APPROXIMATELY 18" AWAY FROM THE WALKS.
- SHOULD ANY CONFLICTS AND/OR DISCREPANCIES ARISE BETWEEN THE GRADING PLANS, GEOTECHNICAL REPORT, THESE NOTES AND PLANS, AND ACTUAL CONDITIONS, THE CONTRACTOR SHALL IMMEDIATELY BRING SUCH ITEMS TO THE ATTENTION OF THE LANDSCAPE ARCHITECT, GENERAL CONTRACTOR, AND OWNER.
- ALL PLANT LOCATIONS ARE DIAGRAMMATIC. ACTUAL LOCATIONS SHALL BE VERIFIED WITH THE LANDSCAPE ARCHITECT OR DESIGNER PRIOR TO PLANTING. THE LANDSCAPE CONTRACTOR SHALL ENSURE THAT ALL REQUIREMENTS OF THE PERMITTING AUTHORITY ARE MET (I.E. MINIMUM PLANT QUANTITIES, PLANTING METHODS, TREE PROTECTION METHODS, ETC.).
- THE LANDSCAPE CONTRACTOR IS RESPONSIBLE FOR DETERMINING PLANT QUANTITIES. PLANT QUANTITIES SHOWN ON LEGENDS AND CALLOUTS ARE FOR GENERAL INFORMATION ONLY. IN THE EVENT OF A DISCREPANCY BETWEEN THE PLAN AND THE PLANT LEGEND, THE PLANT QUANTITY AS SHOWN ON THE PLAN (FOR INDIVIDUAL SYMBOLS) OR CALLOUT (FOR OVERLAPPING PATTERNS) SHALL TAKE PRECEDENCE.
- NO SUBSTITUTIONS OF PLANT MATERIALS SHALL BE ALLOWED WITHOUT THE WRITTEN PERMISSION OF THE LANDSCAPE ARCHITECT. IF SOME OF THE PLANTS ARE NOT AVAILABLE, THE LANDSCAPE CONTRACTOR SHALL NOTIFY THE LANDSCAPE ARCHITECT IN WRITING (VIA PROPER CHANNELS).
- THE CONTRACTOR SHALL AT A MINIMUM PROVIDE REPRESENTATIVE PHOTOS OF ALL PLANTS PROPOSED FOR THE PROJECT. THE CONTRACTOR SHALL ALLOW THE LANDSCAPE ARCHITECT AND THE OWNER/OWNER'S REPRESENTATIVE TO INSPECT AND APPROVE OR REJECT ALL PLANTS DELIVERED TO THE JOBSITE. REFER TO SPECIFICATIONS FOR ADDITIONAL REQUIREMENTS FOR SUBMITTALS.
- THE CONTRACTOR SHALL MAINTAIN THE LANDSCAPE IN A HEALTHY CONDITION FOR 90 DAYS AFTER ACCEPTANCE BY THE OWNER. REFER TO SPECIFICATIONS FOR CONDITIONS OF ACCEPTANCE FOR THE START OF THE MAINTENANCE PERIOD AND FOR FINAL ACCEPTANCE AT THE END OF THE MAINTENANCE PERIOD.
- SEE SPECIFICATIONS AND DETAILS FOR FURTHER REQUIREMENTS.

MULCHES

AFTER ALL PLANTING IS COMPLETE, CONTRACTOR SHALL INSTALL 3" THICK LAYER OF 1-1/2" SHREDDED WOOD MULCH, NATURAL (UNDYED), OVER LANDSCAPE FABRIC IN ALL PLANTING AREAS (EXCEPT FOR TURF AND SEEDING AREAS). CONTRACTOR SHALL SUBMIT SAMPLES OF ALL MULCHES TO LANDSCAPE ARCHITECT AND OWNER FOR APPROVAL PRIOR TO CONSTRUCTION. ABSOLUTELY NO EXPOSED GROUND SHALL BE LEFT SHOWING ANYWHERE ON THE PROJECT AFTER MULCH HAS BEEN INSTALLED (SUBJECT TO THE CONDITIONS AND REQUIREMENTS OF THE "GENERAL GRADING AND PLANTING NOTES" AND SPECIFICATIONS).

ROOT BARRIERS

THE CONTRACTOR SHALL INSTALL ROOT BARRIERS NEAR ALL NEWLY PLANTED TREES THAT ARE LOCATED WITHIN FIVE (5) FEET OF PAVING OR CURBS. ROOT BARRIERS SHALL BE "CENTURY" OR "DEEP-ROOT" 24" DEEP PANELS (OR EQUAL). BARRIERS SHALL BE LOCATED IMMEDIATELY ADJACENT TO HARDSCAPE. INSTALL PANELS PER MANUFACTURER'S RECOMMENDATIONS. UNDER NO CIRCUMSTANCES SHALL THE CONTRACTOR USE ROOT BARRIERS OF A TYPE THAT COMPLETELY ENIRCLE THE ROOTBALL.

LANDSCAPE CALCULATIONS

TOTAL SITE AREA	43,958 SF
PARKING LOT TREES	
PARKING LOT TREE CANOPY REQUIRED (60 SF / PARKING SPACE)	1,200 SF (20 SPACES * 60 SF)
PARKING LOT TREE CANOPY PROVIDED	1,200 SF (1 EXISTING TREE)
TREE CANOPY	
TREE CANOPY REQUIRED (30% GROSS PROPERTY AREA)	13,187 SF (43,958 * 30%)
PRESERVED EXISTING TREE CANOPY	1,200 SF
NEW PARKING LOT TREE CANOPY PROVIDED	0 SF (EXISTING TREES)
NEW SITE TREE CANOPY PROVIDED	12,100 SF
TOTAL TREE CANOPY PROVIDED	13,300 SF (30.2%)
PARKING LOT BUFFER	
NEW PARKING SHALL BE SCREENED FROM STREET VIEW	PROVIDED
SCREENING SHRUBS REQUIRED (PERIMETER / 3)	7 (20 LF / 3)
SCREENING SHRUBS PROVIDED	16
TREE SPECIFICATION REQUIREMENTS	
EVERGREEN TREES REQUIRED	7 (13 * 50%)
EVERGREEN TREES PROVIDED	7
4" CALIPER PARKING LOT TREES REQUIRED	1 (2 * 25%)
4" CALIPER PARKING LOT TREES PROVIDED	1 (EXISTING TREE IS GREATER THAN 4")
MAXIMUM 'LARGE' GROWTH TREES ALLOWED	10 (13 * 75%)
'LARGE' GROWTH TREES PROVIDED	10

EXISTING TREES

NO.	SPECIES	DBH	STATUS
01	UNKNOWN	15" DBH	REMAIN
02	ELM	17" DBH	REMAIN
03	MAPLE	20" DBH	REMAIN
04	ELM	23" DBH	REMOVE
05	ELM	25" DBH	REMOVE
06	ELM	25" DBH	REMOVE
07	ELM	15" DBH	REMOVE
08	OAK	35" DBH	REMAIN
09	OAK	20" DBH	REMAIN
10	OAK	35" DBH	REMAIN

LEGEND

- (XX) INDICATES TREE NUMBER
- EXISTING TREES TO BE PROTECTED IN PLACE
- TREE PROTECTION FENCE
- (XX) INDICATES TREE NUMBER
- EXISTING TREE TO BE REMOVED

PLANT SCHEDULE PLAN

TREES	CODE	QTY	BOTANICAL / COMMON NAME	CAL	CONT.	SIZE
	ML	3	Magnolia grandiflora "Little Gem" Dwarf Southern Magnolia	3" Cal.	B&B	10'-12'
	PE	3	Pinus Elliotti Slash Pine	3" Cal.	B&B	10'-12'
	PN	3	Pinus taeda Loblolly Pine	3" Cal.	B&B	10'-12'
	CPP	4	Platanus chinensis Chinese Platanus	3" Cal.	B&B	10'-12'
	QS	2	Quercus shumardii Shumard Red Oak	4" Cal.	B&B	12'-14'
	UC	3	Ulmus crassifolia Cedar Elm	3" Cal.	B&B	10'-12'
SHRUBS	CODE	QTY	BOTANICAL / COMMON NAME	CONTAINER	SPACING	SIZE
	IB	16	Ilex cornuta "Burfordii Nana" Dwarf Burford Holly	5 gal.	36" OC	24"-36" max.
	MP	6	Myrica cerifera "Pumila" Dwarf Wax Myrtle	5 gal.	36" OC	24"-36" max.
GROUND COVERS	CODE	QTY	BOTANICAL / COMMON NAME	CONT.	SPACING	SIZE
	CD	17,521 sf	Cynodon dactylon "If 419" Bermuda Grass	Sod		

*3 * 300 = 900 sf*
*3 * 800 = 2,400 sf*
*3 * 800 = 2,400 sf*
*4 * 600 = 2,400 sf*
*2 * 800 = 1,600 sf*
*3 * 800 = 2,400 sf*

12,100 sf

*11/18 Large = 60%
 9/18 Evergreen = 50%*

*(1,200 + 12,100) = 13,300 sf available
 30.2%*

NOTE: TREE PROTECTION FOR ANY PRESERVED OR RELOCATED TREES MUST BE PROVIDED PER DETAILS AND SPECIFICATIONS ON SHEET LP-3. THESE MUST BE UP PRIOR TO THE COMMENCEMENT OF ANY WORK AND MAINTAINED THROUGHOUT CONSTRUCTION.

NOTE: ALL TREE TRIMMING MUST BE APPROVED BY THE OWNER AND LOCAL JURISDICTION PRIOR TO COMMENCEMENT OF WORK. ALL TREE TRIMMING MUST BE DONE BY AN ISA CERTIFIED ARBORIST IN ACCORDANCE WITH LOCAL TREE PRESERVATION ORDINANCE.



PRIVATE PLANS - BEASLEY ROAD DUPLEX; CITY OF CONROE, TX : 2844-0001

PLANTING SPECIFICATIONS

GENERAL

- 1. QUALIFICATIONS OF LANDSCAPE CONTRACTOR**
 - ALL LANDSCAPE WORK SHALL BE PERFORMED BY A SINGLE FIRM SPECIALIZING IN LANDSCAPE PLANTING.
 - A LIST OF SUCCESSFULLY COMPLETED PROJECTS OF THIS TYPE, SIZE AND NATURE MAY BE REQUESTED BY THE OWNER FOR FURTHER QUALIFICATION MEASURES.
 - THE LANDSCAPE CONTRACTOR SHALL HOLD A VALID NURSERY AND FLORAL CERTIFICATE ISSUED BY THE TEXAS DEPARTMENT OF AGRICULTURE, AS WELL AS OPERATE UNDER A COMMERCIAL PESTICIDE APPLICATION LICENSE ISSUED BY EITHER THE TEXAS DEPARTMENT OF AGRICULTURE OR THE TEXAS STRUCTURAL PEEL CONTROL BOARD.
- 2. SCOPE OF WORK**
 - WORK COVERED BY THESE SPECIFICATIONS INCLUDES THE FURNISHING AND PLANTING OF ALL WATERBURY-LASCH SERVICE EQUIPMENT, LICENSED TAXES AND ANY OTHER ITEMS THAT ARE NECESSARY FOR THE EXECUTION, INSTALLATION AND COMPLETION OF ALL WORK SPECIFIED HEREIN AND FOR SHOWN ON THE LANDSCAPE PLANS, NOTES AND DETAILS.
 - ALL WORK SHALL BE PERFORMED IN ACCORDANCE WITH ALL APPLICABLE LAWS, CODES AND REGULATIONS REQUIRED BY AUTHORITIES HAVING JURISDICTION OVER SUCH WORK, INCLUDING ALL INSPECTIONS AND PERMITS REQUIRED BY FEDERAL, STATE AND LOCAL AUTHORITIES IN SUPPLY, TRANSPORTATION AND INSTALLATION OF MATERIALS.
 - THE LANDSCAPE CONTRACTOR SHALL VERIFY THE LOCATION OF ALL UNDERGROUND UTILITY LINES (WATER, SEWER, ELECTRICAL, TELEPHONE, GAS, CABLE, TELEVISION, ETC.) PRIOR TO THE START OF ANY WORK.

PRODUCTS

- A. ALL MANUFACTURED PRODUCTS SHALL BE NEW:**
 - CONTAINER AND BILLED-AND-SURAPPED PLANTS
 - FURNISH NURSERY-GROWN PLANTS COMPLYING WITH ANSI Z60.1-2014. PROVIDE WELL-LIGHTED, FULLY BRANCHED, HEALTHY VEGEVATION STOCK FREE OF DISEASE, INSECTS, EGGS, LARVAE, AND DEFECTS SUCH AS KNOTS, SUN SCALD, INJURIES, ABRASIONS, AND DISFIGUREMENT. ALL PLANTS WITH A SPICE SHALL HAVE SIMILAR SIZE AND SHALL BE OF A FORM IDEAL FOR THE SPECIES. ALL TREES SHALL BE CROWNED FROM SOURCES WITH A MINIMUM OF 75% OF THE PROJECT SITE AND WITH SIMILAR CLIMATIC CONDITIONS.
 - ROOT SYSTEMS SHALL BE HEALTHY, DENSELY BRANCHED ROOT SYSTEMS, NONPOI-AQUILAN, FREE FROM ENCIRCLING AND/OR GIRDLING ROOTS, AND FREE FROM ANY OTHER ROOT DEFECTS (SUCH AS J-SHAPED ROOTS).
 - TREES MAY BE PLANTED FROM CONTAINERS OR BILLED-AND-SURAPPED (BSR), UNLESS SPECIFIED ON THE PLANTING LEGEND. BARE-ROOT TREES ARE TWO TO FOUR INCHES ABOVE THE SURFACE OF THE SOIL. ANY PLANT DEEMED UNACCEPTABLE BY THE LANDSCAPE ARCHITECT OR OWNER SHALL BE IMMEDIATELY REMOVED FROM THE SITE AND SHALL BE REPLACED WITH AN ACCEPTABLE PLANT OF LIKE TYPE AND SIZE AT THE CONTRACTOR'S OWN EXPENSE. ANY PLANT APPEARING TO BE UNHEALTHY (EVEN IF DETERMINED TO STILL BE ALIVE) SHALL NOT BE ACCEPTED. THE LANDSCAPE ARCHITECT AND OWNER SHALL BE THE SOLE JUDGES AS TO THE ACCEPTABILITY OF PLANT MATERIAL.
 - ALL TREES SHALL BE STANDARD IN FORM UNLESS OTHERWISE SPECIFIED. TREES WITH CENTRAL LEADERS WILL NOT BE ACCEPTED IF LEADER IS DAMAGED OR REMOVED. PRUNE ALL DAMAGED TWIGS AFTER PLANTING.
 - CALIPER MEASUREMENTS FOR STANDARD (SINGLE TRUNK) TREES SHALL BE AS FOLLOWS: SIX INCHES ABOVE THE ROOT FLARE FOR TREES UP TO AND INCLUDING FOUR INCHES CALIPER AND TWELVE INCHES ABOVE THE ROOT FLARE FOR TREES EXCEEDING FOUR INCHES IN CALIPER.
 - MULTI-TRUNK TREES SHALL BE MEASURED BY THEIR OVERALL HEIGHT, MEASURED FROM THE TOP OF THE ROOT BALL, WHERE OTHER MEASUREMENTS ARE USED. THE CALIPER SHALL BE CALCULATED AS ONE-HALF OF THE SUM OF THE CALIPER OF THE THREE LARGEST TRUNKS.
 - ANY TREE OR SHRUB SHOWN TO HAVE EXCESS SOIL PLACED ON TOP OF THE ROOT BALL SO THAT THE ROOT FLARE HAS BEEN COMPLETELY COVERED, SHALL BE REJECTED.
 - SOIL: PROVIDE WELL-ROOTED SOIL OF THE VARIETY NOTED ON THE PLANS. SOIL SHALL BE CUT FROM HEALTHY, MATURE TURF WITH SOIL THICKNESS OF 2 1/2" TO 1". EACH PALLET OF SOIL SHALL BE ACCOMPANIED BY A CERTIFICATE FROM SUPPLIER STATING THE COMPOSITION OF THE SOIL.
 - TOPSOIL: SANDY TO CLAY LOAM TOPSOIL, FREE OF STONES LARGER THAN 1/2" INCH, FOREIGN MATTER, PLANTER ROOTS, AND SEEDS.
 - COMPOST: WELL-COMPOSTED STABLE AND WEED-FREE ORGANIC MATTER (PH RISE OF 5 TO 8 MOISTURE CONTENT 35 TO 55 PERCENT BY WEIGHT) 100 PERCENT PASSING THROUGH 3/8" MESH SIEVE. SOIL'S CONTENT OF 5 TO 10 ORGANIC MATTER, 10 TO 15 PERCENT NITROGEN, 10 TO 15 PERCENT PHOSPHORUS AND FREE OF SUBSTANCES TOXIC TO PLANTINGS. NO MANURE OR ANIMAL-BASED PRODUCTS SHALL BE USED.
 - FERTILIZER: GRANULAR FERTILIZER CONSISTING OF NITROGEN, PHOSPHORUS, POTASSIUM, AND OTHER NUTRIENTS IN PROPORTIONS, AMOUNTS, AND RELEASE RATES RECOMMENDED IN A SOIL REPORT FROM A QUALIFIED SOIL-TESTING AGENCY (SEE BELOW).
 - MULCH: SIZE AND TYPE AS INDICATED ON PLANS. FREE FROM DELETERIOUS MATERIALS AND SUITABLE AS A TOP DRESSING OF TREES AND SHRUBS.
 - TREE STAKING AND GROUND STAKES:**
 - 1. 1/2" DIA. GALVANIZED STEEL RODS, 14 GAUGE, 24" X 4 INCHES WIDE, FACTORY PAINTED DARK GREEN. ACCEPTABLE MANUFACTURERS INCLUDE COL-VET OR APPROVED EQUAL.
 - 2. PRE-EMERGENT HERBICIDES: ANY GRANULAR, NON-SELECTIVE PRE-EMERGENT HERBICIDE THAT IS LABELED FOR THE SPECIFIC ORNAMENTALS OR TURF ON WHICH IT WILL BE UTILIZED. PRE-EMERGENT HERBICIDES SHALL BE APPLIED PER THE MANUFACTURER'S LABELED RATES.

METHODS

- A. SOIL PREPARATION**
 - 1. BEFORE STARTING WORK, THE LANDSCAPE CONTRACTOR SHALL VERIFY THAT THE GRADE OF ALL LANDSCAPE AREAS ARE WITHIN +1" OF FINISH GRADE. THE CONTRACTOR SHALL NOTIFY THE OWNER IMMEDIATELY SHOULD ANY DISCREPANCIES EXIST.
 - 2. SOIL TESTING
 - a. AFTER FINISH GRADES HAVE BEEN ESTABLISHED, CONTRACTOR SHALL HAVE SOIL SAMPLES FROM THE PROJECT'S LANDSCAPE AREAS TESTED BY AN ESTABLISHED SOIL TESTING LABORATORY. EACH SAMPLE SUBMITTED TO THE LAB SHALL CONTAIN NO LESS THAN ONE QUART OF SOIL, TAKEN FROM BETWEEN THE SOIL SURFACE AND 12 INCHES DEEP. NO SAMPLE LOCATIONS ARE INDICATED ON THE PLANS, THE CONTRACTOR SHALL TAKE A MINIMUM OF THREE SAMPLES FROM VARIOUS REPRESENTATIVE LOCATIONS FOR TESTING.
 - b. THE CONTRACTOR SHALL HAVE THE SOIL TESTING LABORATORY PROVIDE RESULTS FOR THE FOLLOWING: SOIL TEXTURE CLASS, GENERAL SOIL FERTILITY, pH, ORGANIC MATTER CONTENT, SALT (EC) LEVEL, SODIUM ADSORPTION RATIO (SAR), AND BORON CONTENT.
 - c. THE CONTRACTOR SHALL ALSO SUBMIT THE PROJECT'S PLANT LIST TO THE LABORATORY ALONG WITH THE SOIL SAMPLES.
 - d. THE SOIL REPORT PRODUCED BY THE LABORATORY SHALL CONTAIN RECOMMENDATIONS FOR THE FOLLOWING (AS APPROPRIATE): SEPARATE SOIL PREPARATION AND BACKFILL MIX RECOMMENDATIONS FOR GENERAL ORNAMENTALS, XERIC PLANTS, TURF, AND NATIVE SEED, AS WELL AS PRE-PLANT FERTILIZER APPLICATIONS AND RECOMMENDATIONS FOR ANY OTHER SOIL RELATED ISSUES. THE REPORT SHALL ALSO PROVIDE A FERTILIZER PROGRAM FOR THE ESTABLISHMENT PERIOD AND FOR LONG-TERM MAINTENANCE.
 - e. THE CONTRACTOR SHALL INSTALL SOIL AMENDMENTS AND FERTILIZERS PER THE SOILS REPORT RECOMMENDATIONS. ANY CHANGE IN COST DUE TO THE SOIL REPORT RECOMMENDATIONS EITHER INCREASE OR DECREASE, SHALL BE SUBMITTED TO THE OWNER WITH THE REPORT.
 - f. FOR BEDDING PURPOSES ONLY, THE SOIL PREPARATION SHALL CONSIST OF THE FOLLOWING:
 - 1. TURF: INCORPORATE THE FOLLOWING AMENDMENTS INTO THE TOP 8" OF SOIL BY MEANS OF ROTOTILLING AFTER CROSS-BARRING:
 - a. NITROGEN STABILIZED ORGANIC AMENDMENT +4 CU YDS PER 1,000 SF.
 - b. PRE-PLANT TURF FERTILIZER (10-20-10 OR SIMILAR, SLOW RELEASE, ORGANIC) - 15 LBS PER 1,000 SF.
 - c. CLAY BUSTER OR EQUAL - USE MANUFACTURER'S RECOMMENDED RATE.
 - d. TREES, SHRUBS, AND PERENNIALS: INCORPORATE THE FOLLOWING AMENDMENTS INTO THE TOP 8" OF SOIL BY MEANS OF ROTOTILLING AFTER CROSS-BARRING:
 - 1. NITROGEN STABILIZED ORGANIC AMENDMENT - 4 CU YDS PER 1,000 SF.
 - 2. 10-20-10 FERTILIZER (OR SIMILAR, ORGANIC, SLOW RELEASE) - 10 LBS PER CU YD.
 - 3. CLAY BUSTER OR EQUAL - USE MANUFACTURER'S RECOMMENDED RATE.
 - 4. IRON SULPHATE - 2 LBS PER CU YD.
- B. FINISH GRADE**
 - 1. IN THE CONTEXT OF THESE PLANS, NOTES, AND SPECIFICATIONS, "FINISH GRADE" REFERS TO THE FINAL ELEVATION OF THE SOIL SURFACE (NOT TOP OF MULCH) AS INDICATED ON THE GRADING PLANS.
 - 2. BEFORE STARTING WORK, THE LANDSCAPE CONTRACTOR SHALL VERIFY THAT THE ROUGH GRADES OF ALL LANDSCAPE AREAS ARE WITHIN +1" OF FINISH GRADE. SEE SPECIFICATIONS FOR MORE DETAILED INSTRUCTION ON TURF AREA AND PLANTING BED PREPARATION.
 - 3. CONSTRUCT AND MAINTAIN FINISH GRADES AS SHOWN ON GRADING PLANS, AND CONSTRUCT AND MAINTAIN SLOPES AS RECOMMENDED BY THE GEOTECHNICAL REPORT. ALL LANDSCAPE AREAS SHALL HAVE POSITIVE DRAINAGE AWAY FROM STRUCTURES AT THE MINIMUM SLOPE SPECIFIED IN THE REPORT AND ON THE GRADING PLANS. AND AREAS OF PERENNIALS, PERENNIALS SHALL BE REGRADED TO BLEND IN WITH THE SURROUNDING GRASSES, AND ELIMINATE POONDING POTENTIAL.
 - 4. THE LANDSCAPE CONTRACTOR SHALL DETERMINE WHETHER OR NOT THE EXPORT OF ANY SOIL WILL BE NEEDED, TAKING INTO ACCOUNT THE ROUGH GRADE PROVIDED, THE AMOUNT OF SOIL AMENDMENTS TO BE ADDED (BASED ON A SOIL TEST PER SPECIFICATIONS), AND THE FINISH GRADES TO BE ESTABLISHED.
 - 5. ENSURE THAT THE FINISH GRADE IN SHRUB AREAS IMMEDIATELY ADJACENT TO WALKS AND OTHER WALKING SURFACES, AFTER INSTALLING SOIL AMENDMENTS, IS 3" BELOW THE ADJACENT FINISH GRADE. PROVIDE TO ALLOW FOR PROPER KICK-UP DEPTH. TAPER THE SOIL SURFACE TO MEET FINISH GRADE AS SPECIFIED ON THE GRADING PLANS, AT APPROXIMATELY 18" AWAY FROM THE WALKS.
 - 6. ENSURE THAT THE FINISH GRADE IN TURF AREAS IMMEDIATELY ADJACENT TO WALKS AND OTHER WALKING SURFACES, AFTER INSTALLING SOIL AMENDMENTS, IS 1" BELOW THE FINISH GRADE OF THE WALKS. TAPER THE SOIL SURFACE TO MEET FINISH GRADE AS SPECIFIED ON THE GRADING PLANS, AT APPROXIMATELY 18" AWAY FROM THE WALKS.
 - 7. SHOULD ANY CONFLICTS OR DISCREPANCIES ARISE BETWEEN THE GRADING PLANS, GEOTECHNICAL REPORT, THESE NOTES AND PLANS, AND ACTUAL CONDITIONS, THE CONTRACTOR SHALL IMMEDIATELY BRING SUCH ITEMS TO THE ATTENTION OF THE LANDSCAPE ARCHITECT, GENERAL CONTRACTOR, AND OWNER.
 - 8. ONCE SOIL PREPARATION IS COMPLETE, THE LANDSCAPE CONTRACTOR SHALL ENSURE THAT THERE ARE NO DEBRIS TRASH OR STONES LARGER THAN 1" REMAINING IN THE TOP 6" OF SOIL.

SUBMITTALS

- 1. THE CONTRACTOR SHALL PROVIDE SUBMITTALS AND SAMPLES, IF REQUIRED, TO THE LANDSCAPE ARCHITECT AND RECEIVE APPROVAL IN WRITING FOR SUCH SUBMITTALS BEFORE WORK COMMENCES.** SUBMITTALS SHALL INCLUDE PHOTOS OF PLANTS WITH A RUBER OR MEASURING STICK FOR SCALE, PHOTOS OR SAMPLES OF ANY REQUIRED MULCHES, AND SOIL TEST RESULTS AND PREPARATION RECOMMENDATIONS FROM THE TESTING LAB INCLUDING COMPOST AND FERTILIZER RATES AND TYPES, AND OTHER AMENDMENTS FOR TREES, SHRUB, TURF, AND SEED AREAS AS MAY BE APPROPRIATE.
- 2. SUBMITTALS SHALL ALSO INCLUDE MANUFACTURER CUT SHEETS FOR PLANTING ACCESSORIES SUCH AS TREE STAKES AND TIES, BEDDING, AND LANDSCAPE FABRICS (IF ANY), WHERE MULTIPLE ITEMS ARE SHOWN ON A PAGE, THE CONTRACTOR SHALL CLEARLY INDICATE THE ITEM BEING SUBMITTED.**
- 3. GENERAL PLANTING**
 - 1. REMOVE ALL NURSERY TAGS AND STAKES FROM PLANTS EXCEPT FINALS TO BE INSTALLED WITH ORNAMENTAL GRASSES. APPLY PRE-EMERGENT HERBICIDES AT THE MANUFACTURER'S RECOMMENDED RATE.
 - 2. TRENDING NEAR EXISTING TREES
 - a. CONTRACTOR SHALL NOT DISTURB ROOTS 1/2" AND LARGER IN DIAMETER WITHIN THE CRITICAL ROOT ZONE (CRZ) OF EXISTING TREES AND SHALL EXERCISE ALL POSSIBLE CARE AND PRECAUTIONS TO AVOID INJURY TO TREE ROOTS, TRUNKS, AND BRANCHES. THE CRZ IS DEFINED AS A CIRCULAR AREA EXTENDING OUTWARD FROM THE TREE TRUNK, WITH A RADIUS EQUAL TO 1" FOR EVERY 1" OF TRUNK DIAMETER AT-BREAST+HEIGHT (4.5' ABOVE THE AVERAGE GRADE AT THE TRUNK).
 - b. ALL EXCAVATION WITHIN THE CRZ SHALL BE PERFORMED USING HAND TOOLS. NO MACHINE EXCAVATION OR TRENCHING OF ANY KIND SHALL BE ALLOWED WITHIN THE CRZ.
 - c. ALTER ALIGNMENT OF PIPE TO AVOID TREE ROOTS 1/2" AND LARGER IN DIAMETER, WHERE TREE ROOTS 1/2" AND LARGER IN DIAMETER ARE ENCOUNTERED IN THE FIELD, TUNNEL UNDER SUCH ROOTS, WRAP EXPOSED ROOTS WITH SEVERAL LAYERS OF BURAP AND KEEP MOIST. GLOBE ALL TRENCHER WITHIN THE CANOPY OR LINES WITHIN 24 HOURS.
 - d. ALL SEVERED ROOTS SHALL BE HAND PRUNED WITH SHARP TOOLS AND ALLOWED TO AIR-DRY. DO NOT USE ANY SORT OF SEALERS OR WOUNDS.

TREE PLANTING

- 1. TREE PLANTING HOLES SHALL BE EXCAVATED TO MINIMUM WIDTH OF TWO TIMES THE WIDTH OF THE ROOTBALL, AND TO THE DEPTH OF THE ROOTBALL LESS TWO TO FOUR INCHES.** SCARIFY THE SIDES AND BOTTOM OF THE PLANTING HOLE PRIOR TO THE PLACEMENT OF THE TREE FOR CONTAINERS THAT MAY HAVE BEEN CAISED DURING THE EXCAVATION OF THE HOLE.
- 2. FOR CONTAINERS TO REMOVE ANY POTENTIALLY GIRDLING ROOTS AND OTHER ROOT DEFECTS, THE CONTRACTOR SHALL SHAVE A 1" LAYER OFF OF THE SIDES AND BOTTOM OF THE ROOTBALL OF ALL TREES JUST BEFORE PLACING INTO THE PLANTING PIT. DO NOT TEASE ROOTS OUT FROM THE ROOTBALL.**
- 3. INSTALL THE TREE ON UNDISTURBED SUBGRADE SO THAT THE TOP OF THE ROOTBALL IS TWO TO FOUR INCHES ABOVE THE SURROUNDING GRADE.**
- 4. BACKFILL THE TREE AND TAMPING THE EXISTING TOPSOIL FROM ON-SITE. ROCKS LARGER THAN 1" DIA. AND ALL OTHER DEBRIS SHALL BE REMOVED FROM THE SOIL PRIOR TO THE BACKFILL. SHOULD ADDITIONAL SOIL BE REQUIRED TO ACCOMPLISH THIS TASK, USE STONED TOPSOIL FROM ON-SITE OR IMPORTED TOPSOIL, SHALL BE OF SIMILAR TEXTURE, CLASS AND COMPOSITION IN THE ON-SITE SOIL.** TREES SHALL NOT BE STAKED UNLESS LOCAL CONDITIONS (WINDS OR SLOPES) REQUIRE STAKES TO KEEP TREES UPRIGHT. SHOULD STAKING BE REQUIRED, THE TOTAL NUMBER OF TREE STAKES BEYOND THE MINIMUMS LISTED BELOW WILL BE LEFT TO THE LANDSCAPE CONTRACTOR'S DISCRETION. SHOULD ANY TREES FALL OR BE DAMAGED, THE CONTRACTOR SHALL STRAIGHTEN THE TREE, OR REPLACE IT SHOULD IT BECOME DAMAGED. TREE STAKING SHALL ADHERE TO THE FOLLOWING GUIDELINES:
 - a. 1" x 12" TREES: TWO STAKES PER TREE
 - b. 2 1/2" - 4" TREES: THREE STAKES PER TREE
 - c. TREES OVER 4" CALIPER: QUATERS NEEDED
 - d. MULTI-TRUNK TREES: THREE STAKES PER TREE MINIMUM. QUANTITY AND POSITIONS AS NEEDED TO STABILIZE THE TREE.
 - e. MULTI-TRUNK TREES: THREE STAKES PER TREE MINIMUM. QUANTITY AND POSITIONS AS NEEDED TO STABILIZE THE TREE.
- 5. UPON COMPLETION OF PLANTING, CONSTRUCT AN EARTH WATERING BASIN AROUND THE TREE COVER THE INTERIOR OF THE BASIN WITH THE WEED BARRIER CLOTH AND TOPDRESS WITH MULCH (TYPE AND DEPTH PER PLANS).**
- 6. SHRUB PERENNIAL AND GROUNDCOVER PLANTING**
 - 1. DIG THE PLANTING HOLES TWICE AS WIDE AND 2" DEEPER THAN EACH PLANT'S ROOTBALL. INSTALL THE PLANT IN THE HOLE. BACKFILL AROUND THE PLANT WITH SOIL AMENDED PER SOIL TEST RECOMMENDATIONS.
 - 2. INSTALL THE WEED BARRIER CLOTH OVERLAPPING IT AT THE ENDS. UTILIZE STEEL STAPLES TO KEEP THE WEED BARRIER CLOTH IN PLACE.
 - 3. WHEN PLANTING IS COMPLETE, INSTALL MULCH (TYPE AND DEPTH PER PLANS) OVER ALL PLANTING.
- 7. SOODING**
 - 1. SOIL VARIETY TO BE AS SPECIFIED ON THE LANDSCAPE PLAN.
 - 2. LAY SOIL WITHIN 24 HOURS FROM THE TIME OF STRIPPING. DO NOT LAY IF THE GROUND IS FROZEN.
 - 3. LAY THE SOIL TO FORM A SOLID MASS WITH TIGHTLY FITTED JOINTS. BOTH ENDS AND SIDES OF SOIL STRIPS DO NOT OVERLAP.
 - 4. ROLL THE SOIL TO ENSURE GOOD CONTACT OF THE SOILS ROOT SYSTEM WITH THE SOIL UNDERNEATH.
 - 5. WATER THE SOIL THOROUGHLY WITH A FINE SPRAY IMMEDIATELY AFTER PLANTING TO OBTAIN AT LEAST SIX INCHES OF PENETRATION INTO THE SOIL BELOW THE SOIL.
- 8. MULCH**
 - 1. INSTALL MULCH TOPDRESSING TYPE AND DEPTH PER MULCH NOTE IN ALL PLANTING AREAS AND TREE PINNS.
 - 2. DO NOT INSTALL MULCH WITHIN 8" OF TREE ROOT FLARE AND WITHIN 24" OF HABITABLE STRUCTURES EXCEPT AS MAY BE NOTED ON THESE PLANS. MULCH COVER WITHIN 8" OF CONCRETE WALKS AND CURBS SHALL NOT PROTRUDE ABOVE THE FINISH SURFACE OF THE WALKS AND CURBS. MULCH COVER WITHIN 12" OF WALLS SHALL BE AT LEAST 3" LOWER THAN THE TOP OF WALL.

CLEANUP









- 1. DURING LANDSCAPE PREPARATION AND PLANTING, KEEP ALL PAVEMENT CLEAN AND ALL WORK AREAS IN A NEAT, ORDERLY CONDITION.**
- 2. DISPOSED LEGALLY OF ALL EXCAVATED MATERIALS OFF THE PROJECT SITE.**

INSPECTION AND ACCEPTANCE

- 1. UPON COMPLETION OF THE WORK, THE LANDSCAPE CONTRACTOR SHALL PROVIDE THE SITE CLEAN, FREE OF DEBRIS AND TRASH, AND SUITABLE FOR USE AS INTENDED. THE LANDSCAPE CONTRACTOR SHALL THEN REQUEST AN INSPECTION BY THE OWNER TO DETERMINE FINAL ACCEPTABILITY.** WHEN THE INSPECTED PLANTING WORK DOES NOT COMPLY WITH THE CONTRACT DOCUMENTS, THE LANDSCAPE CONTRACTOR SHALL REPLACE AND/OR REPAIR THE REJECTED WORK TO THE OWNER'S SATISFACTION WITHIN 24 HOURS.
- 2. THE LANDSCAPE MAINTENANCE PERIOD WILL NOT COMMENCE UNTIL THE LANDSCAPE WORK HAS BEEN RE-INSPECTED BY THE OWNER AND FOUND TO BE ACCEPTABLE. AT THAT TIME, A WRITTEN NOTICE OF FINAL ACCEPTANCE WILL BE ISSUED BY THE OWNER, AND THE MAINTENANCE AND GUARANTEE PERIODS WILL COMMENCE.**
- 3. LANDSCAPE MAINTENANCE**
 - 1. THE LANDSCAPE CONTRACTOR SHALL BE RESPONSIBLE FOR THE MAINTENANCE OF ALL WORK SHOWN ON THESE PLANS FOR 90 DAYS BEYOND FINAL ACCEPTANCE OF ALL LANDSCAPE WORK BY THE OWNER. LANDSCAPE MAINTENANCE SHALL INCLUDE WEEKLY SITE VISITS FOR THE FOLLOWING ACTIONS (AS APPROPRIATE): PROPER PRUNING, RESTIMING OF TREES, RESETTling OF PLANTS THAT HAVE SETTLED, MOWING AND AERATION OF LAWNS, WEEDING, TREATING FOR INSECTS AND DISEASES, REPLACEMENT OF MULCH, REMOVAL OF LITTER, REPAIRS TO THE IRRIGATION SYSTEM DUE TO FAULTY PARTS, AND MAINTENANCE, AND THE APPROPRIATE WATERING OF ALL PLANTINGS. THE LANDSCAPE CONTRACTOR SHALL MAINTAIN THE IRRIGATION SYSTEM IN PROPER WORKING ORDER WITH SCHEDULED ADJUSTMENTS BY SEASON TO MAXIMIZE WATER CONSERVATION.
 - 2. SHOULD SEEDED AND/OR SODDED AREAS NOT BE COVERED BY AN AUTOMATIC IRRIGATION SYSTEM, THE LANDSCAPE CONTRACTOR SHALL BE RESPONSIBLE FOR WATERING THESE AREAS AND OBTAINING A FULL, HEALTHY STAND OF PLANTS AT NO ADDITIONAL COST TO THE OWNER.
 - 3. TO ACHIEVE FINAL ACCEPTANCE AT THE END OF THE MAINTENANCE PERIOD, ALL OF THE FOLLOWING CONDITIONS MUST OCCUR:
 - a. THE LANDSCAPE SHALL SHOW ACTIVE, HEALTHY GROWTH (WITH EXCEPTIONS MADE FOR SEASONAL DORMANCY). ALL PLANTS NOT MEETING THIS CONDITION SHALL BE REJECTED AND REPLACED BY HEALTHY PLANT MATERIAL PRIOR TO FINAL ACCEPTANCE.
 - b. ALL HABITABLE STRUCTURES SHALL BE CLEANED PRIOR TO FINAL ACCEPTANCE.
 - c. SODDED AREAS MUST BE ACTIVELY GROWING AND MUST REACH A MINIMUM HEIGHT OF 1 1/2 INCHES BEFORE FIRST MOWING. BARE AREAS LARGER THAN TWELVE SQUARE INCHES MUST BE RESEEDDED AS APPROPRIATE PRIOR TO FINAL ACCEPTANCE. ALL SODDED TURF SHALL BE NEARLY MOWED.

WARRANTY PERIOD

- 1. THE LANDSCAPE CONTRACTOR SHALL GUARANTEE AND REPLACEMENTS**
 - 1. THE LANDSCAPE CONTRACTOR SHALL GUARANTEE ALL TREES, SHRUBS, PERENNIALS, SOIL, AND IRRIGATION SYSTEMS FOR A PERIOD OF ONE YEAR FROM THE DATE OF THE OWNER'S FINAL ACCEPTANCE (90 DAYS FOR ANNUAL PLANTS). THE CONTRACTOR SHALL REPLACE, AT HIS OWN EXPENSE AND TO THE SATISFACTION OF THE OWNER, ANY PLANTS WHICH DIE IN THAT TIME, OR REPAIR ANY PORTIONS OF THE IRRIGATION SYSTEM WHICH OPERATE IMPROPERLY.
 - 2. AFTER THE INITIAL MAINTENANCE PERIOD AND DURING THE GUARANTEE PERIOD, THE LANDSCAPE CONTRACTOR SHALL ONLY BE RESPONSIBLE FOR REPLACEMENT OF PLANTS WHEN PLANT DEATH CANNOT BE ATTRIBUTED DIRECTLY TO OVERWATERING OR OTHER DAMAGE BY HUMAN ACTIONS. PROVIDE A MINIMUM OF 20 COPIES OF RECORD DRAWINGS TO THE OWNER. UPON COMPLETION OF WORK, A RECORD DRAWING IS A RECORD OF ALL CHANGES THAT OCCURRED IN THE FIELD AND THAT ARE DOCUMENTED THROUGH CHANGE ORDERS, ADDENDUM, OR CONTRACTOR/CONSULTANT DRAWING MARKUPS.

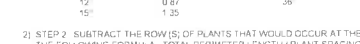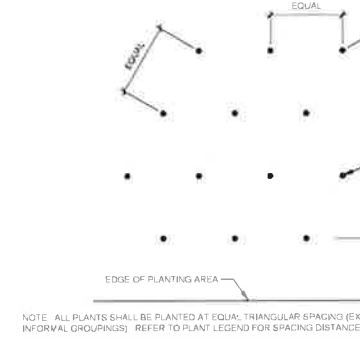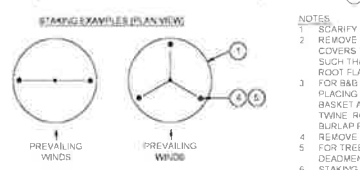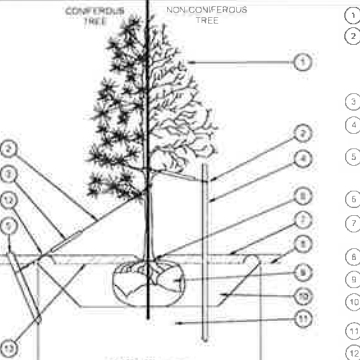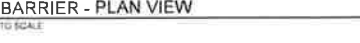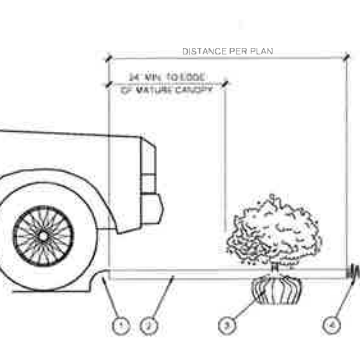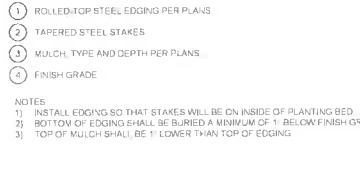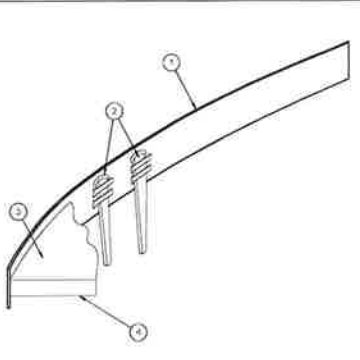

- 1. TREE CANOPY
- 2. 24 X 3/4" PVC MARKERS OVER WIRES
- 3. GREEN STEEL I-POSTS. EXTEND POSTS 12" MIN INTO UNDISTURBED SOIL.
- 4. PRESSURIZED TREATED WOOD DEADMAN. TWO PER TREE (MIN). BURIED OUTSIDE OF PLANTING PIT AND 18" MIN INTO UNDISTURBED SOIL.
- 5. TRUNK FLARE
- 6. MULCH TYPE AND DEPTH PER PLANS. DO NOT PLACE MULCH WITHIN 8" OF TRUNK.
- 7. FINISH GRADE
- 8. ROOT BALL
- 9. BACKFILL. AMEND AND FERTILIZE ONLY AS RECOMMENDED IN SOIL FERTILITY ANALYSIS.
- 10. UNDISTURBED NATIVE SOIL.
- 11. FINISH GRADE

- 1. ROLLED TOP STEEL EDGING PER PLANS
- 2. TAPERED STEEL STAKES
- 3. MULCH TYPE AND DEPTH PER PLANS
- 4. FINISH GRADE

- 1. INSTALL EDGING SO THAT STAKES WILL BE ON INSIDE OF PLANTING BED
- 2. BOTTOM OF EDGING SHALL BE BURIED A MINIMUM OF 1" BELOW FINISH GRADE
- 3. TOP OF MULCH SHALL BE 1" LOWER THAN TOP OF EDGING








FLOODPLAIN INFORMATION:
 THE FEDERAL EMERGENCY MANAGEMENT AGENCY'S FLOOD INSURANCE RATE MAP FOR THE CITY OF CONROE, MONTGOMERY COUNTY, TEXAS AND INCORPORATED AREAS, COMMUNITY NO. 480484, DATED AUGUST 18, 2014, INDICATES THAT THIS TRACT IS WITHIN ZONE "X" UNSHADED. AREAS DETERMINED TO BE OUTSIDE THE 0.2% ANNUAL CHANCE FLOODPLAIN, AS SHOWN ON MAP AND PANEL NO. 4

TREE PROTECTION SPECIFICATIONS

MATERIALS

- FABRIC 4 FOOT HIGH ORANGE PLASTIC FENCING AS SHOWN ON THE PLANS AND SHALL BE WOVEN WITH 2 INCH MESH OPENINGS SUCH THAT IN A VERTICAL DIMENSION OF 23 INCHES ALONG THE DIAGONALS OF THE OPENINGS THERE SHALL BE AT LEAST 7 MESHES.
- POSTS POSTS SHALL BE A MINIMUM OF 72 INCHES LONG AND STEEL T-SHAPED WITH A MINIMUM WEIGHT OF 1.3 POUNDS PER LINEAR FOOT.
- THE WIRE WIRE FOR ATTACHING THE FABRIC TO THE T-POSTS SHALL BE NOT LESS THAN NO. 12 GAUGE GALVANIZED WIRE.
- USED MATERIALS PREVIOUSLY-USED MATERIALS, MEETING THE ABOVE REQUIREMENTS AND WHEN APPROVED BY THE OWNER, MAY BE USED.

CONSTRUCTION METHODS

- ALL TREES AND SHRUBS SHOWN TO REMAIN WITHIN THE PROXIMITY OF THE CONSTRUCTION SITE SHALL BE PROTECTED PRIOR TO BEGINNING ANY DEVELOPMENT ACTIVITY.
- EMPLOY THE SERVICES OF AN ISA (INTERNATIONAL SOCIETY OF ARBORICULTURE) CERTIFIED ARBORIST AND OBTAIN ALL REQUIRED PERMITS TO PRUNE THE EXISTING TREES FOR CLEANING, RAISING AND THINNING, AS MAY BE REQUIRED.
- PROTECTIVE FENCING SHALL BE ERECTED OUTSIDE THE CRITICAL ROOT ZONE (CRZ EQUAL TO 1" FROM THE TRUNK FOR EVERY 1" OF DBH) AT LOCATIONS SHOWN IN THE PLANS OR AS DIRECTED BY THE LANDSCAPE CONSULTANT AND/OR CITY ARBORIST, AND IN ACCORDANCE WITH THE DETAILS SHOWN ON THE PLANS. FENCING SHALL BE MAINTAINED AND REPAIRED BY THE CONTRACTOR DURING SITE CONSTRUCTION. TREES IN CLOSE PROXIMITY SHALL BE FENCED TOGETHER, RATHER THAN INDIVIDUALLY.
- PROTECTIVE FENCE LOCATIONS IN CLOSE PROXIMITY TO STREET INTERSECTIONS OR DRIVES SHALL ADHERE TO THE APPLICABLE JURISDICTION'S SIGHT DISTANCE CRITERIA.
- THE PROTECTIVE FENCING SHALL BE ERECTED BEFORE SITE WORK COMMENCES AND SHALL REMAIN IN PLACE DURING THE ENTIRE CONSTRUCTION PHASE.
- THE INSTALLATION POSTS SHALL BE PLACED EVERY 6 FEET ON CENTER AND EMBEDDED TO 18 INCHES DEEP. MESH FABRIC SHALL BE ATTACHED TO THE INSTALLATION POSTS BY THE USE OF SUFFICIENT WIRE TIES TO SECURELY FASTEN THE FABRIC TO THE T-POSTS TO HOLD THE FABRIC IN A STABLE AND UPRIGHT POSITION.
- WITHIN THE CRZ
 - DO NOT CLEAR, FILL OR GRADE IN THE CRZ OF ANY TREE.
 - DO NOT STORE, STOCKPILE OR DUMP ANY JOB MATERIAL, SOIL OR RUBBISH UNDER THE SPREAD OF THE TREE BRANCHES.
 - DO NOT PARK OR STORE ANY EQUIPMENT OR SUPPLIES UNDER THE TREE CANOPY.
 - DO NOT SET UP ANY CONSTRUCTION OPERATIONS UNDER THE TREE CANOPY (SUCH AS PIPE CUTTING AND THREADING, MORTAR MIXING, PAINTING OR LUMBER CUTTING).
 - DO NOT NAIL OR ATTACH TEMPORARY SIGNS, METERS, SWITCHES, WIRES, BRACING OR ANY OTHER ITEM TO THE TREES.
 - DO NOT PERMIT RUNOFF FROM WASTE MATERIALS INCLUDING SOLVENTS, CONCRETE WASHOUTS, ASPHALT TACK COATS (MC-30 OIL) ETC. TO ENTER THE CRZ. BARRIERS ARE TO BE PROVIDED TO PREVENT SUCH RUNOFF SUBSTANCES FROM ENTERING THE CRZ WHENEVER POSSIBLE, INCLUDING IN AN AREA WHERE RAIN OR SURFACE WATER COULD CARRY SUCH MATERIALS TO THE ROOT SYSTEM OF THE TREE.
- ROUTE UNDERGROUND UTILITIES TO AVOID THE CRZ IF DIGGING IS UNAVOIDABLE. BORE UNDER THE ROOTS, OR HAND DIG TO AVOID SEVERING THEM.
- WHERE EXCAVATION IN THE VICINITY OF TREES MUST OCCUR, SUCH AS FOR IRRIGATION INSTALLATION, PROCEED WITH CAUTION AND USING HAND TOOLS ONLY.
- THE CONTRACTOR SHALL NOT CUT ROOTS LARGER THAN ONE INCH IN DIAMETER. WHEN EXCAVATION OCCURS NEAR EXISTING TREES, ALL ROOTS LARGER THAN ONE INCH IN DIAMETER ARE TO BE CUT CLEANLY. FOR OAKS ONLY, ALL WOUNDS SHALL BE PAINTED WITH WOUND SEALER WITHIN 30 MINUTES.
- REMOVE ALL TREES, SHRUBS OR BUSHES TO BE CLEARED FROM PROTECTED ROOT ZONE AREAS BY HAND.
- TREES DAMAGED OR KILLED DUE TO CONTRACTOR'S NEGLIGENCE DURING CONSTRUCTION SHALL BE MITIGATED AT THE CONTRACTOR'S EXPENSE AND TO THE PROJECT OWNER'S AND LOCAL JURISDICTIONS' SATISFACTION.
- ANY TREE REMOVAL SHALL BE APPROVED BY THE OWNER AND LOCAL JURISDICTION PRIOR TO ITS REMOVAL, AND THE CONTRACTOR SHALL HAVE ALL REQUIRED PERMITS FOR SUCH ACTIVITIES.
- COVER EXPOSED ROOTS AT THE END OF EACH DAY WITH SOIL, MULCH OR WET BURLAP.
- IN CRITICAL ROOT ZONE AREAS THAT CANNOT BE PROTECTED DURING CONSTRUCTION AND WHERE HEAVY TRAFFIC IS ANTICIPATED, COVER THE SOIL WITH EIGHT INCHES OF ORGANIC MULCH TO MINIMIZE SOIL COMPACTION. THIS EIGHT INCH DEPTH OF MULCH SHALL BE MAINTAINED THROUGHOUT CONSTRUCTION.
- WATER ALL TREES IMPACTED BY CONSTRUCTION ACTIVITIES, DEEPLY ONCE A WEEK DURING PERIODS OF HOT DRY WEATHER. SPRAY TREE CROWNS WITH WATER PERIODICALLY TO REDUCE DUST ACCUMULATION ON THE LEAVES.
- WHEN INSTALLING CONCRETE ADJACENT TO THE ROOT ZONE OF A TREE, USE A PLASTIC VAPOR BARRIER BEHIND THE CONCRETE TO PROHIBIT LEACHING OF LIME INTO THE SOIL.
- CONTRACTOR SHALL REMOVE AND DISPOSE OF ALL TREE PROTECTION FENCING WHEN ALL THREATS TO THE EXISTING TREES FROM CONSTRUCTION-RELATED ACTIVITIES HAVE BEEN REMOVED.

TREE PROTECTION GENERAL NOTES


- PRIOR TO THE LAND CLEARING STAGE OF DEVELOPMENT, THE CONTRACTOR SHALL CLEARLY MARK ALL PROTECTED TREES FOR WHICH A TREE REMOVAL PERMIT HAS NOT BEEN ISSUED AND SHALL ERECT BARRIERS FOR THE PROTECTION OF THE TREES ACCORDING TO THE FOLLOWING:
 - AROUND AN AREA AT OR GREATER THAN A SIX-FOOT RADIUS OF ALL SPECIES OF MANGROVES AND PROTECTED CABBAGE PALMS.
 - AROUND AN AREA AT OR GREATER THAN THE FULL DRIPLINE OF ALL PROTECTED NATIVE PINES.
 - AROUND AN AREA AT OR GREATER THAN TWO-THIRDS OF THE DRIPLINE OF ALL OTHER PROTECTED SPECIES.
- NO PERSON SHALL ATTACH ANY SIGN, NOTICE OR OTHER OBJECT TO ANY PROTECTED TREE OR FASTEN ANY WIRES, CABLES, NAILS OR SCREWS TO ANY PROTECTED TREE IN ANY MANNER THAT COULD PROVE HARMFUL TO THE PROTECTED TREE, EXCEPT AS NECESSARY IN CONJUNCTION WITH ACTIVITIES IN THE PUBLIC INTEREST.
- DURING THE CONSTRUCTION STAGE OF DEVELOPMENT, THE CONTRACTOR SHALL NOT CAUSE OR PERMIT THE CLEANING OF EQUIPMENT OR MATERIAL WITHIN THE OUTSIDE PERIMETER OF THE CROWN (DRIPLINE) OR ON THE NEARBY GROUND OF ANY TREE OR GROUP OF TREES WHICH IS TO BE PRESERVED, WITHIN THE OUTSIDE PERIMETER OF THE CROWN (DRIPLINE) OF ANY TREE OR ON NEARBY GROUND, THE CONTRACTOR SHALL NOT CAUSE OR PERMIT STORAGE OF BUILDING MATERIAL AND/OR EQUIPMENT, OR DISPOSAL OF WASTE MATERIAL SUCH AS PAINTS, OIL, SOLVENTS, ASPHALT, CONCRETE, MORTAR OR ANY OTHER MATERIAL HARMFUL TO THE LIFE OF THE TREE.
- NO PERSON SHALL PERMIT ANY UNNECESSARY FIRE OR BURNING WITHIN 30 FEET OF THE DRIPLINE OF A PROTECTED TREE.
- ANY LANDSCAPING ACTIVITIES WITHIN THE BARRIER AREA SHALL BE ACCOMPLISHED WITH HAND LABOR.
- PRIOR TO ISSUING A CERTIFICATE OF OCCUPANCY OR COMPLIANCE FOR ANY DEVELOPMENT, BUILDING OR STRUCTURE, ALL TREES DESIGNATED TO BE PRESERVED THAT WERE DESTROYED DURING CONSTRUCTION SHALL BE REPLACED BY THE CONTRACTOR WITH TREES OF EQUIVALENT DIAMETER AT BREAST HEIGHT TREE CALIPER AND OF THE SAME SPECIES AS SPECIFIED BY THE CITY STAFF BEFORE OCCUPANCY OR USE, UNLESS APPROVAL FOR THEIR REMOVAL HAS BEEN GRANTED UNDER PERMIT.
- THE CITY STAFF MAY CONDUCT PERIODIC INSPECTIONS OF THE SITE DURING LAND CLEARANCE AND CONSTRUCTION.
- IF, IN THE OPINION OF THE CITY STAFF, DEVELOPMENT ACTIVITIES WILL SO SEVERELY STRESS SLASH PINES OR ANY OTHER PROTECTED TREE SUCH THAT THEY ARE MADE SUSCEPTIBLE TO INSECT ATTACK, PREVENTATIVE SPRAYING OF THESE TREES BY THE CONTRACTOR MAY BE REQUIRED.

TREE RELOCATION GUIDELINES

- TREES SHALL NOT BE UNNECESSARILY DAMAGED DURING REMOVAL, TRANSPORT OR REPLANTING OF THE TREE.
- IF THE TREE HAS A DORMANT PERIOD, THEY SHOULD BE TRANSPLANTED DURING THAT TIME. TREES SHOULD NOT BE TRANSPLANTED DURING PERIODS OF STRONG WINDS, DRY WINTER WINDS OR DURING DROUGHT.
- ADEQUATE SPACES FOR ROOT AND CROWN DEVELOPMENT SHALL BE PROVIDED.
- TREES SHALL BE ROOT AND CANOPY PRUNED IN ACCORDANCE WITH SOUND ARBORICULTURAL STANDARDS PRIOR TO TRANSPLANTING.
- DURING AND FOLLOWING TRANSPLANTING, THE ROOT BALL AND TRUNK SHALL BE PROTECTED. THE ROOT BALL MUST BE KEPT MOIST AT ALL TIMES.
- TRANSPLANTED TREES SHALL BE BRACED FOR A MINIMUM OF ONE (1) YEAR.
- TRANSPLANTED TREES SHALL NOT BE FERTILIZED AT PLANTING TIME BUT SHALL BE WATERED SUFFICIENTLY UNTIL THE TREE GROWTH IS REESTABLISHED.
- ALL CROWN PRUNING SHALL BE DONE IN ACCORDANCE WITH "THE AMERICAN NATIONAL STANDARDS INSTITUTE A-300, TREE SHRUB AND OTHER WOODY PLANT MAINTENANCE-STANDARD PRACTICES" AND "2-133.1 PRUNING, REPAIRING, MAINTAINING AND REMOVING TREES, AND CUTTING BRUSH-SAFETY REQUIREMENTS" OR PALM PRUNING IN ACCORDANCE WITH THE STANDARDS IN, RICHARD HARRIS, "ARBORICULTURE INTEGRATED MANAGEMENT OF LANDSCAPE TREES, SHRUBS AND VINES", AS AMENDED.
- CONTRACTOR IS RESPONSIBLE FOR REGULAR WATERING AND MAINTENANCE OF TRANSPLANTED TREES DURING STORAGE PERIOD.

TREES THAT ARE MARKED TO BE PRESERVED ON A SITE PLAN AND FOR WHICH UTILITIES MUST PASS THROUGH THEIR ROOT PROTECTION ZONES MAY REQUIRE TUNNELING AS OPPOSED TO OPEN TRENCHES. THE DECISION TO TUNNEL WILL BE DETERMINED ON A CASE BY CASE BASIS BY THE ENGINEER.

TUNNELS SHALL BE DUG THROUGH THE ROOT PROTECTION ZONE IN ORDER TO MINIMIZE ROOT DAMAGE.

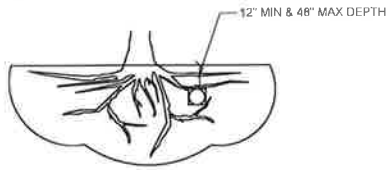


TUNNEL TO MINIMIZE ROOT DAMAGE (TOP) AS OPPOSED TO SURFACE-DUG TRENCHES IN ROOT PROTECTION ZONE WHEN THE 5' MINIMUM DISTANCE FROM TRUNK CAN NOT BE ACHIEVED.




OPEN TRENCHING MAY BE USED IF EXPOSED TREE ROOTS DO NOT EXCEED 3' OR ROOTS CAN BE BENT BACK.

C BORING THROUGH ROOT PROTECTION ZONE
SCALE: NOT TO SCALE

- NOTES
- RETENTION AREAS WILL BE SET AS PART OF THE REVIEW PROCESS AND PRE-CONSTRUCTION MEETING.
 - BOUNDARIES OF RETENTION AREAS MUST BE STAKED AT THE PRE-CONSTRUCTION MEETING AND FLAGGED PRIOR TO ROOT PRUNING.
 - EXACT LOCATION OF ROOT PRUNING SHALL BE DETERMINED IN THE FIELD IN COORDINATION WITH THE FORESTRY INSPECTOR.
 - TRENCH SHOULD BE IMMEDIATELY BACKFILLED WITH EXCAVATED SOIL OR OTHER ORGANIC SOIL AS SPECIFIED PER PLAN OR BY THE FORESTRY INSPECTOR.
 - ROOTS SHALL BE CLEANLY CUT USING VIBRATORY KNIFE OR OTHER ACCEPTABLE EQUIPMENT. ROOT PRUNING METHODS AND MEANS MUST BE IN ACCORDANCE WITH ANSI STANDARD A3000.
 - ALL PRUNING MUST BE EXECUTED AT LOD SHOWN ON PLANS OR AS AUTHORIZED IN WRITING BY THE FORESTRY INSPECTOR.
 - SUPPLEMENTAL WATERING MAY BE REQUIRED FOR ROOT PRUNED TREES THROUGHOUT THE GROWING SEASON DURING CONSTRUCTION AND SUBSEQUENT WARRANTY AND MAINTENANCE PERIOD.

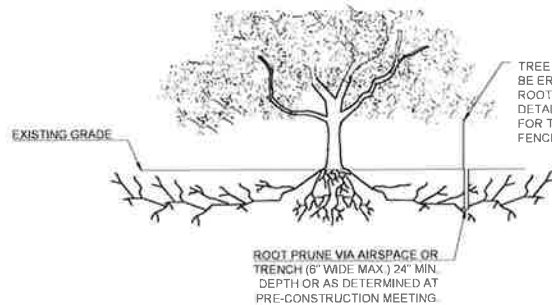


D ROOT PRUNING DETAIL
SCALE: NOT TO SCALE

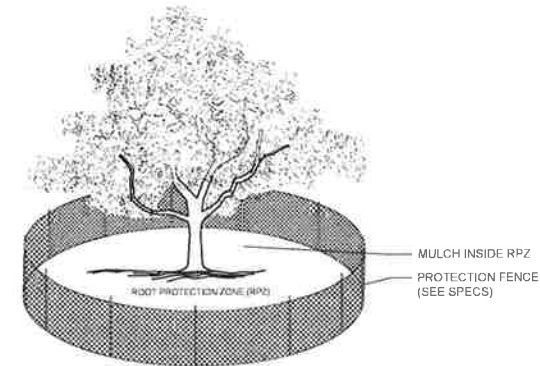

- NOTES
- THE FENCING LOCATION SHOWN ABOVE IS DIAGRAMATIC ONLY AND WILL CONFORM TO THE DRIP LINE AND BE LIMITED TO PROJECT BOUNDARY, WHERE MULTIPLE ADJACENT TREES WILL BE ENCLOSED BY FENCING, THE FENCING SHALL BE CONTINUOUS AROUND ALL TREES.
 - FOR ACCEPTABLE FENCING MATERIALS SEE SPECIFICATIONS.

A TREE PROTECTION FENCE
SCALE: NOT TO SCALE

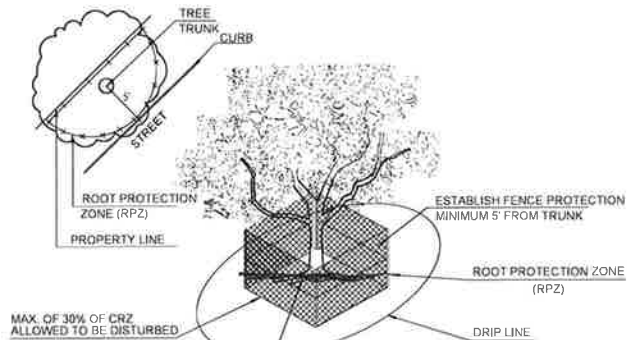

B TREE PROTECTION FENCE - TIGHT CONSTRUCTION
SCALE: NOT TO SCALE

- NOTES
- OPTION USED FOR TIGHT CONSTRUCTION AREAS OR WHEN CONSTRUCTION OCCURS IN ROOT PROTECTION ZONE.
 - FOR ACCEPTABLE FENCING MATERIALS SEE SPECIFICATIONS.

FLOODPLAIN INFORMATION:
THE FEDERAL EMERGENCY MANAGEMENT AGENCY'S FLOOD INSURANCE RATE MAP FOR THE CITY OF CONROE, MONTGOMERY COUNTY, TEXAS AND INCORPORATED AREAS, COMMUNITY NO. 480484, DATED AUGUST 15, 2014, INDICATES THAT THIS TRACT IS WITHIN ZONE "X" UNSHADED, AREAS DETERMINED TO BE OUTSIDE THE 0.2% ANNUAL CHANCE FLOODPLAIN, AS SHOWN ON MAP AND PANEL NO. 48339C0385G. THIS DETERMINATION HAS BEEN MADE BY SCALING THE PROPERTY ON THE ABOVE REFERENCED MAP AND IS NOT THE RESULT OF AN ELEVATION SURVEY. WARNING: IF THIS SITE IS NOT WITHIN AN IDENTIFIED SPECIAL FLOOD HAZARD AREA, THIS STATEMENT DOES NOT IMPLY THAT THE PROPERTY AND/OR THE STRUCTURES THEREON WILL BE FREE FROM FLOODING OR FLOOD DAMAGE, ON RARE OCCASIONS, GREATER FLOODS CAN AND WILL OCCUR AND FLOOD HEIGHTS MAY BE INCREASED BY MAN-MADE OR NATURAL CAUSES. THIS FLOOD STATEMENT SHALL NOT CREATE LIABILITY ON THE PART OF THE SURVEYOR.

BENCHMARKS:
CITY OF CONROE BENCHMARK "CC-4" BEING A BRASS DISK IN CONCRETE ALONG THE EAST SIDE OF NORTH FRAZIER STREET (STATE HIGHWAY 75) BETWEEN WOODLAND HILLS DRIVE AND LEAGUE LINE ROAD IN FRONT OF EASTERN TRANSMISSION CORP. CONROE MAINTENANCE HEADQUARTERS AT 3700 NORTH FRAZIER STREET. (NAVD 88) ELEV.=284.24

TEMPORARY BENCHMARK:
RAILROAD SPIKE IN POWER POLE ALONG THE NORTH RIGHT-OF-WAY LINE OF BEASLEY ROAD APPROXIMATELY 25' ± SOUTHWEST OF THE COMMON SOUTHERLY CORNER OF LOTS 1 AND 2, BLOCK 1, OLIVA SUBDIVISION, AS SHOWN ON SURVEY. (NAVD 88) ELEV.=226.06

NOTE:
IN CASE OF CONFLICT BETWEEN DETAILS SHOWN ON THIS SHEET AND THE CITY OF CONROE DESIGN STANDARDS, THE MORE STRINGENT SHALL APPLY.



11-22-21

DATE	REVISION

CITY OF CONROE
MONTGOMERY COUNTY, TEXAS

BEASLEY ROAD DUPLEX

TREE
DISPOSITION
SPECS & DETAILS

LJA Engineering Inc.
1904 W. Grand Pkwy N., Suite 100, Katy, Texas 77449
Phone 713.953.5200, Fax 713.953.5026, FRN - F-1386

LJA PROJECT NO.: 2844-0001

SCALE: 1"=20'
DATE: July 30, 2021 SHEET NO. LP-3

