Reed, James
~~Smith, M. G.~~
LOIS SMITH

012-S11-0051
#439

Indian Hill Estates
S1, B6, Lot 6

SEPTIC

Application #6219
License #.3286 Issued: 08-31-77

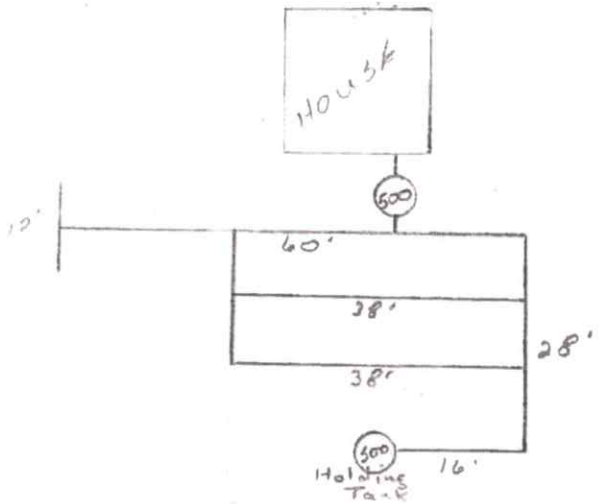

ROAD

SHORELINE

Application # 3930
License # 20684 Fees: ~~$ 26.40~~ ~~70.00~~ 74.00
Bulkhead
Pier-264 SF
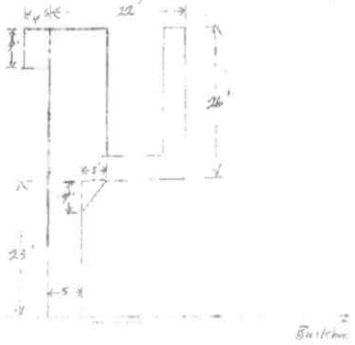
As Built
(not to scale)