LEGEND * ITEMS THAT MAY APPEAR IN * DRAWING BELOW

A.E. = AERIAL EASEMENT
B.L. = BUILDING LINE
BRS = BEARS
C.F.# = CLERK'S FILE NUMBER
D.E. = DRAINAGE EASEMENT
E.E. = ELECTRIC EASEMENT
F.I.P. = FOUND IRON PIPE
F.I.R. = FOUND IRON ROD
FND. = FOUND
M.P. = METAL POST
M.U.E. = MUNICIPAL UTILITY EASEMENT
P.A.E. = PERMANENT ACCESS EASEMENT
P.C. = POINT OF CURVATURE
P.C.C. = POINT OF COMPOUND CURVATURE
P.E. = POOL EQUIPMENT
P.O.C. = POINT OF COMMENCING
P.O.B. = POINT OF BEGINNING
P.P. = POWER POLE
P.R.C. = POINT OF REVERSE CURVATURE
P.T. = POINT OF TANGENCY
P.U.E. = PUBLIC UTILITY EASEMENT
S.I.R. = SET IRON ROD
S.S.E. = SANITARY SEWER EASEMENT
STM.S.E. = STORM SEWER EASEMENT
U.T.S. = UNABLE TO SET
U.E. = UTILITY EASEMENT
W.L.E. = WATER LINE EASEMENT
W.P. = WOODEN POST
W.S.E. = WATER & SEWER EASEMENT
S.F.N.F = SEARCHED FOR, NOT FOUND

= NOT TO SCALE
= GUY ANCHOR
= POWER POLE
= SERVICE DROP
= CONTROL MONUMENT
= PROPERTY CORNER
= PROPERTY LINE
= EASEMENT LINE
= BUILDING SETBACK LINE
= BUILDING WALL
= WOODEN FENCE
= CHAIN LINK FENCE
= METAL FENCE
= WIRE FENCE
= VINYL FENCE
= OVERHEAD ELECTRIC POWER LINE

SCALE 1"=30'

GREEN TEE TERRACE SECTION 2
V-172/P-11, H.C.M.R.

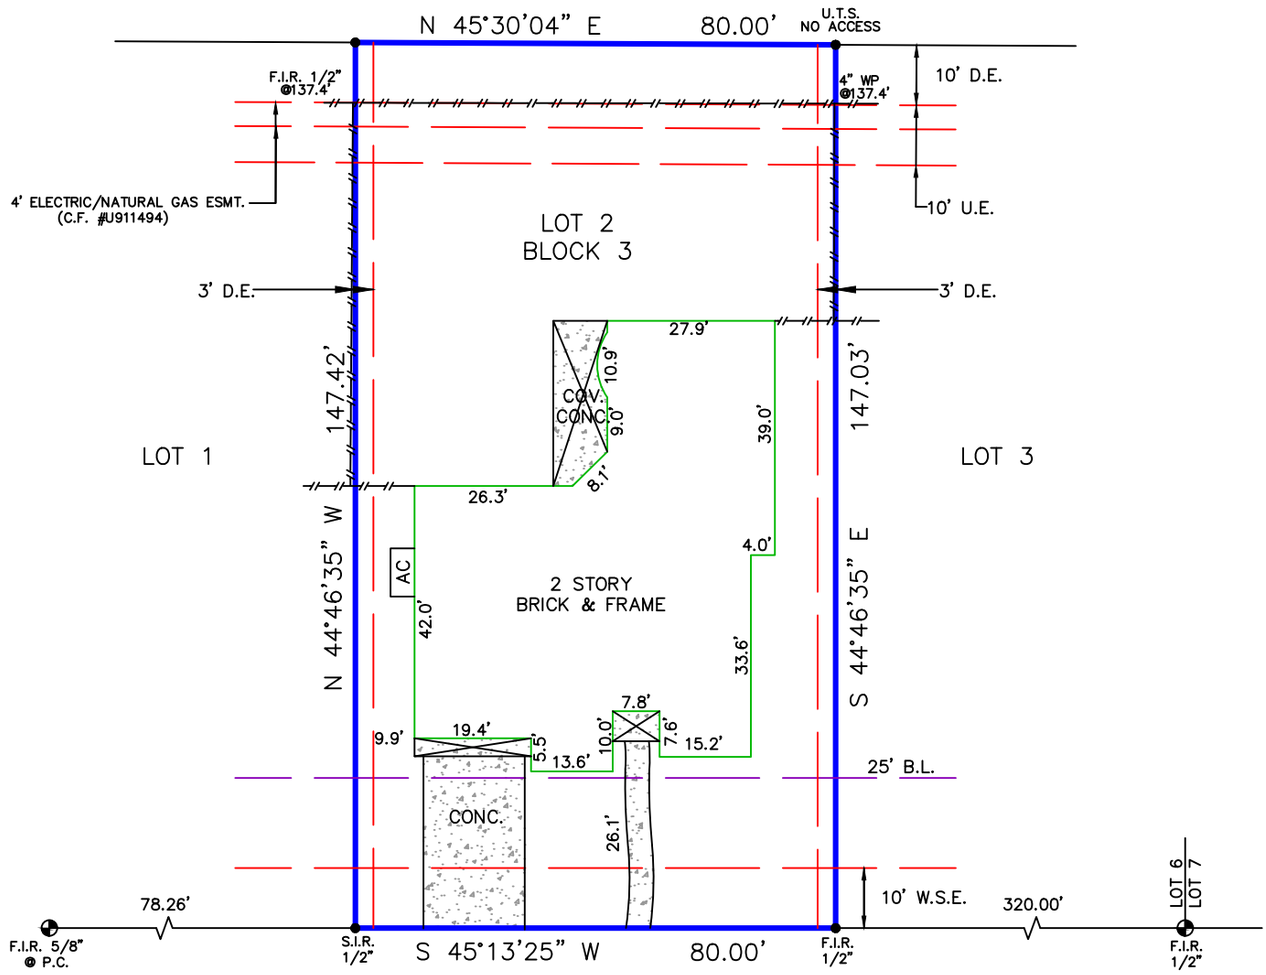

2204 VERONA DRIVE
(60' R.O.W.)
(PRIVATE)

Reviewed & Accepted by: _____ Date _____ / _____ Date _____

NOTES:
– BEARING BASIS: PLAT
– SUBJECT TO ANY AND ALL RECORDED AND UNRECORDED EASEMENTS
– SURVEYOR HAS NOT INDEPENDENTLY ABSTRACTED PROPERTY
– UNDERGROUND UTILITY INSTALLATIONS,UNDERGROUND IMPROVEMENTS, FOUNDATIONS AND/OR OTHER UNDERGROUND STRUCTURES WERE NOT LOCATED BY THIS SURVEY
– THIS SURVEY IS CERTIFIED FOR THIS TRANSACTION ONLY, IT IS NOT TRANSFERABLE TO ADDITIONAL INSTITUTIONS OR SUBSEQUENT OWNERS
– SUBJECT TO RESTRICTIVE COVENANTS AS PER TITLE COMMITMENT
– SUBJECT TO ZONING AND BUILDING ORDINANCES ENFORCED BY LOCAL MUNICIPALITIES
– EASEMENT FOR ELECTRIC DISTRIBUTION FACILITIES OR NATURAL GAS FACILITIES AS RECORDED UNDER HARRIS COUNTY CLERK'S FILE NO. U1914497
– EASEMENT FOR CABLE SERVICES AS RECORDED UNDER HARRIS COUNTY CLERK'S FILE NO. 20170035118
- FENCES DO NOT FOLLOW PROPERTY LINES. NO ACCESS TO ADJOINING PROPERTIES TO CHECK FOR POSSIBLE ENCROACHMENTS

LEGAL DESCRIPTION

LOT TWO (2), BLOCK THREE (3), OF AMENDED FINAL PLAT OF VILLA D'ESTE SECTION ONE, A SUBDIVISION ACCORDING TO THE MAP OR PLAT THEREOF, RECORDED IN FILM CODE NO. 472066, OF THE MAP RECORDS OF HARRIS COUNTY, TEXAS.

KAMAL KEITH MOHAMMED

ADDRESS
2204 VERONA DRIVE

STATE OF TEXAS
REGISTERED
TOBY PAUL COUCHMAN
5565
PROFESSIONAL
SURVEYOR

I DO HEREBY CERTIFY THAT THIS SURVEY WAS THIS DAY MADE ON THE GROUND OF THE PROPERTY LEGALLY DESCRIBED HEREON (OR ON ATTACHED SHEET), AND THERE ARE NO ENCROACHMENTS EXCEPT AS SHOWN, AND WAS DONE BY ME OR UNDER MY SUPERVISION.

JOB # 2206155
DATE 06-16-2022
GF# 22-394007

PRO-SURV
P.O. BOX 1366, FRIENDSWOOD, TX 77549
PHONE: 281-996-1113 FAX: 281-996-0012
EMAIL: orders@prosurv.net
T.B.P.E.L.S. FIRM #10119300

ONLY SURVEY MAPS WITH THE SURVEYOR'S ORIGINAL SIGNATURE ARE GENUINE TRUE AND CORRECT COPIES OF THE SURVEYOR'S ORIGINAL WORK AND OPINION

© 2022 PRO-SURV - ALL RIGHTS RESERVED